
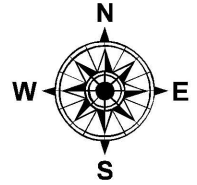


PARENT PARCEL: 15-00-082-000-029

CHILD PARCEL:

STARTING POINT: NORTHWEST CORNER OF S/L 141 IN PHEASANT RUN VILLAGE PH.1

19-04154-A

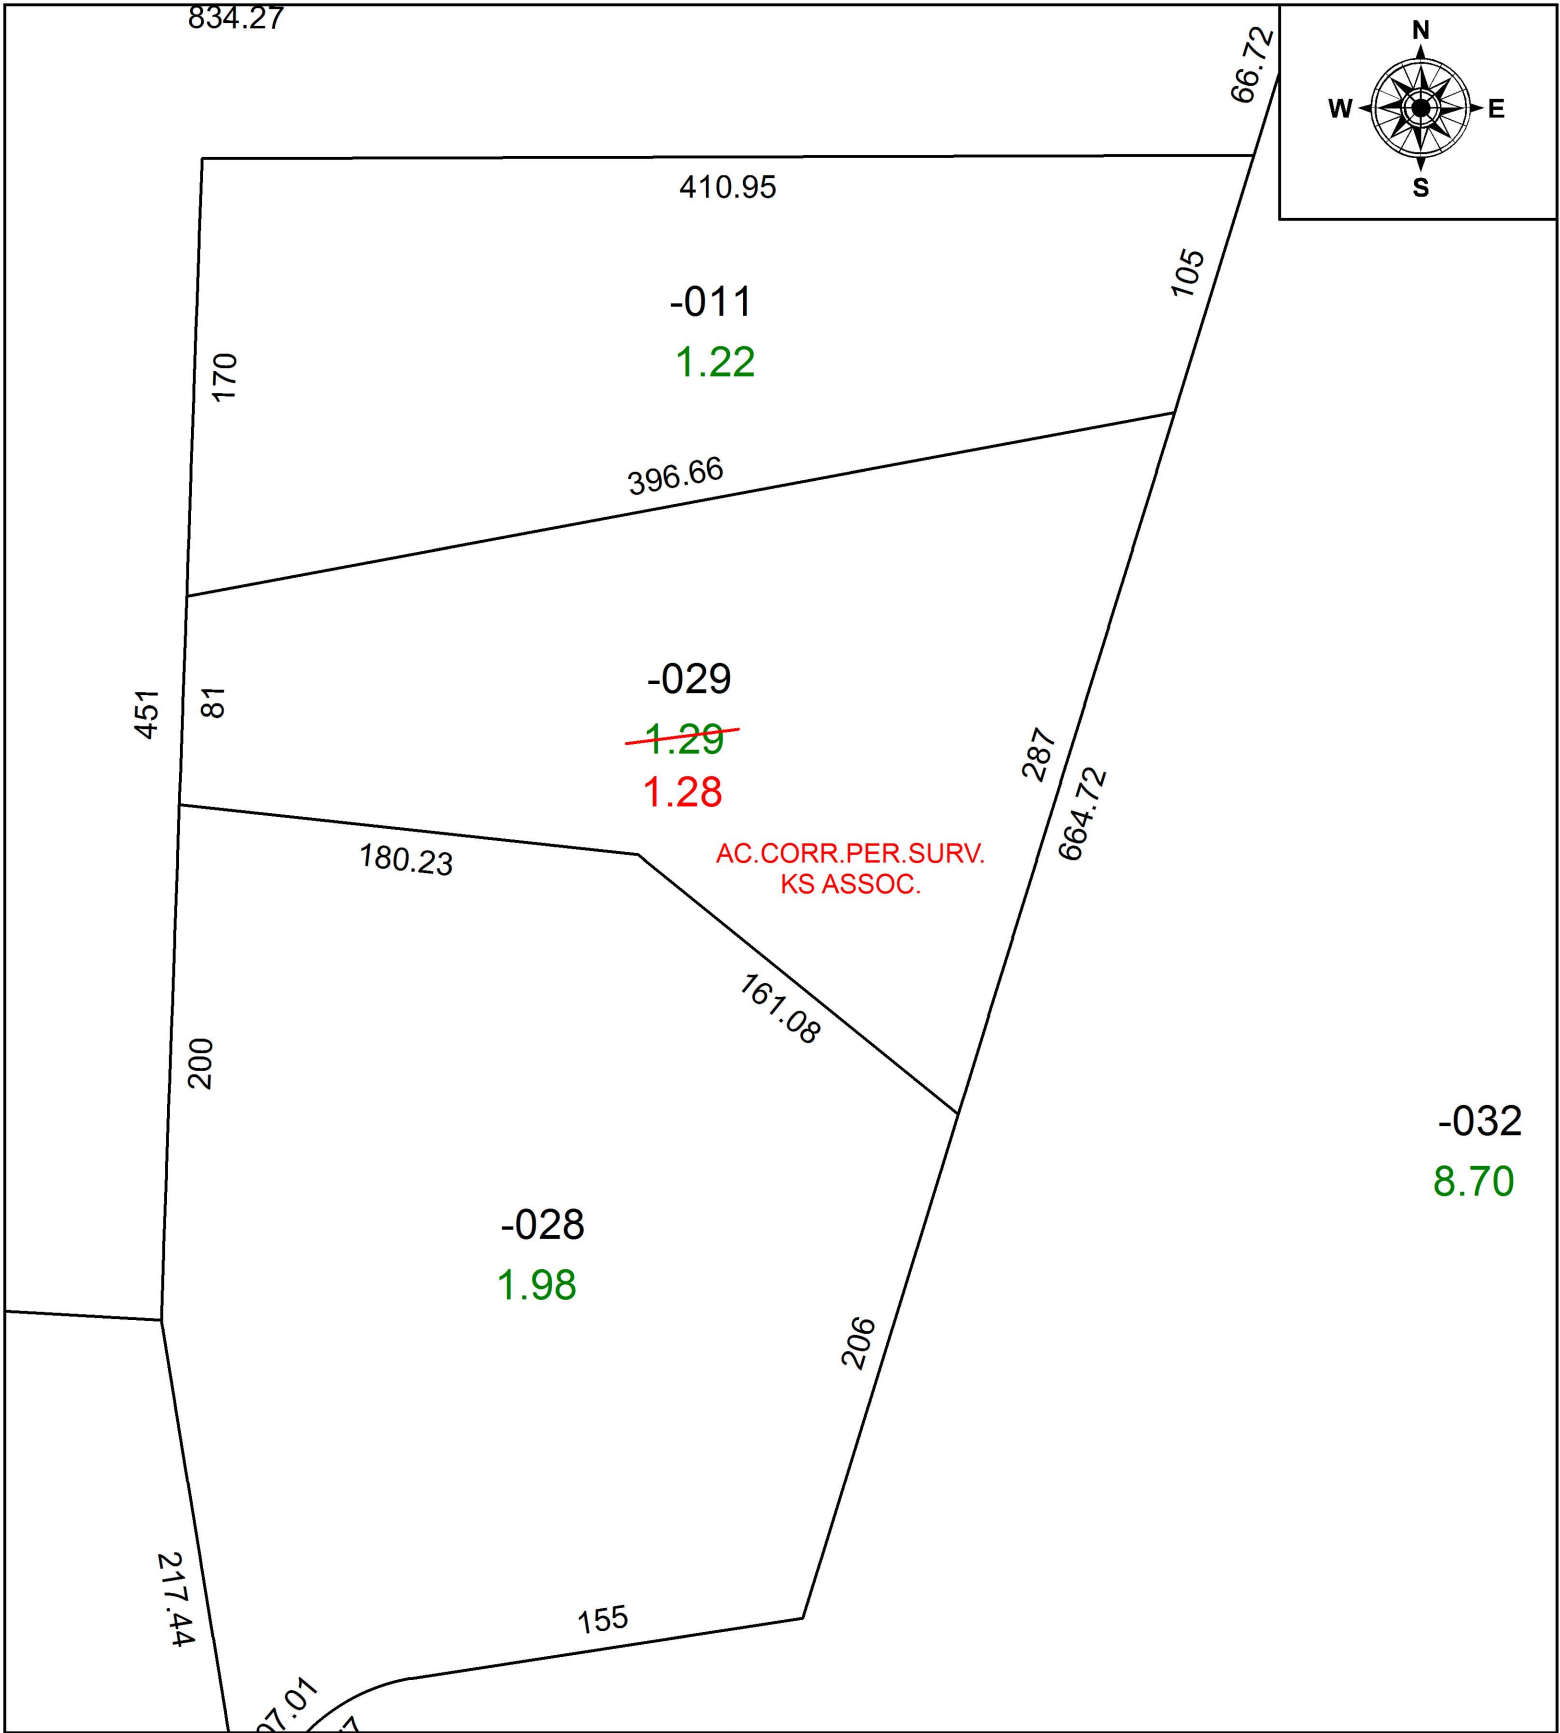

SPLITS/DEEDS PROCESSED
 LORAIN COUNTY TAX MAP DEPARTMENT
 226 MIDDLE AVE. ELYRIA, OH

SURVEYED BY: KS ASSOC.
 CLOSURE: 1:168,551
 MAP PAGE(S): 15-00-082
 APPROVED BY: RRM DATE: 7-23-19
 SCALE: 1" = 75' PRIOR INSTRUMENT: 20080277142