


PARENT PARCEL: 02-01-003-262-015


CHILD PARCEL:

STARTING POINT: NORTHWEST CORNER OF S/L 16 IN REUTER SUB,

19-04155-A

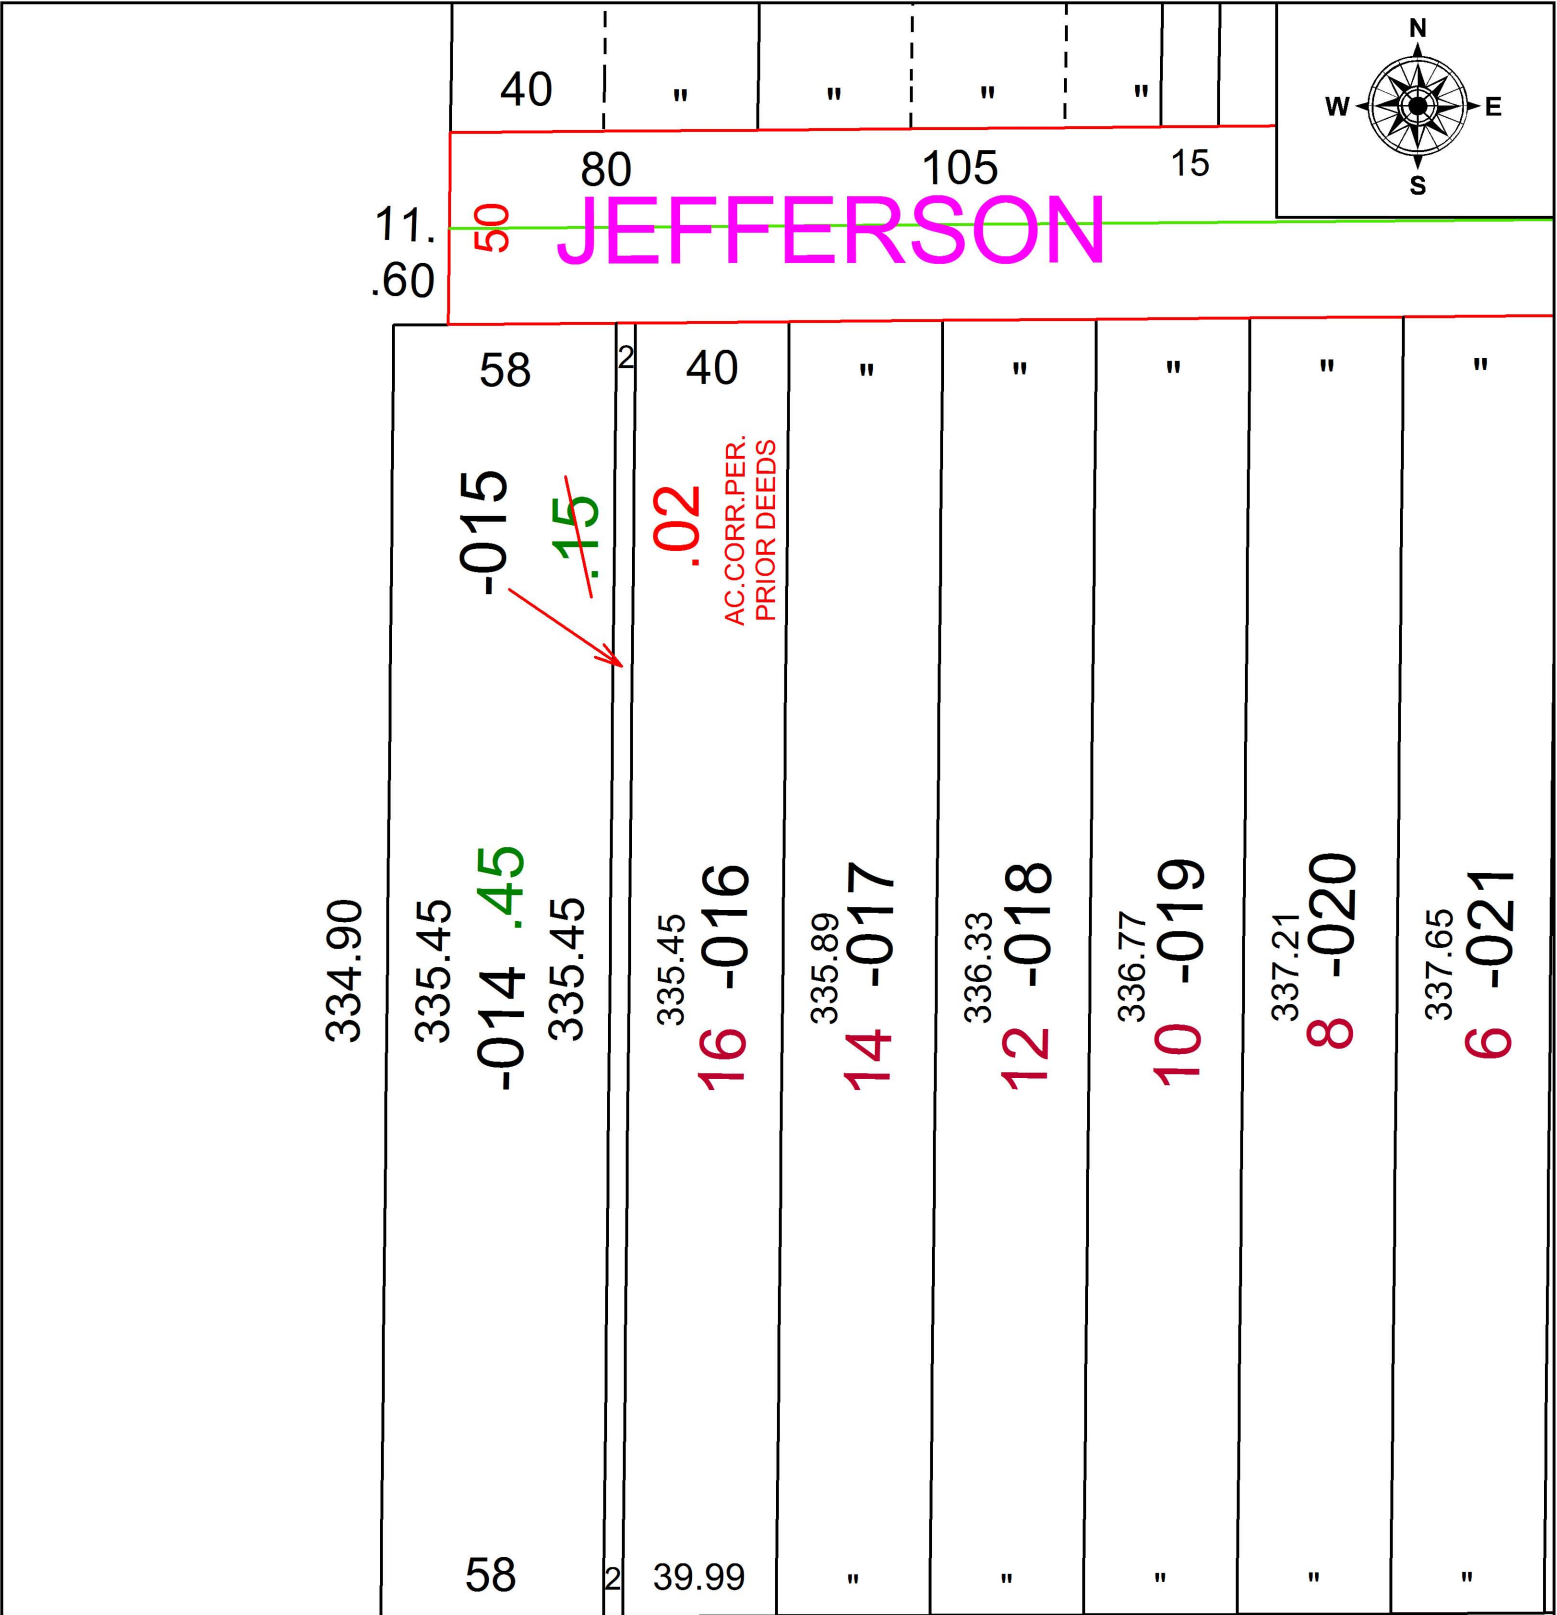

702 90

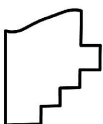

SPLITS/DEEDS PROCESSED
LORAIN COUNTY TAX MAP DEPARTMENT
226 MIDDLE AVE. ELYRIA, OH

SURVEYED BY: _____ N/A

CLOSURE: _____ N/A

MAP PAGE(S): _____ 2-1-003

APPROVED BY: _____ RRM DATE: _____ 7-23-19

SCALE: _____ 1" = 50 PRIOR INSTRUMENT: _____ 20190720493