


PARENT PARCEL: 02-01-006-149-035

CHILD PARCEL:

STARTING POINT:

19-04156-C

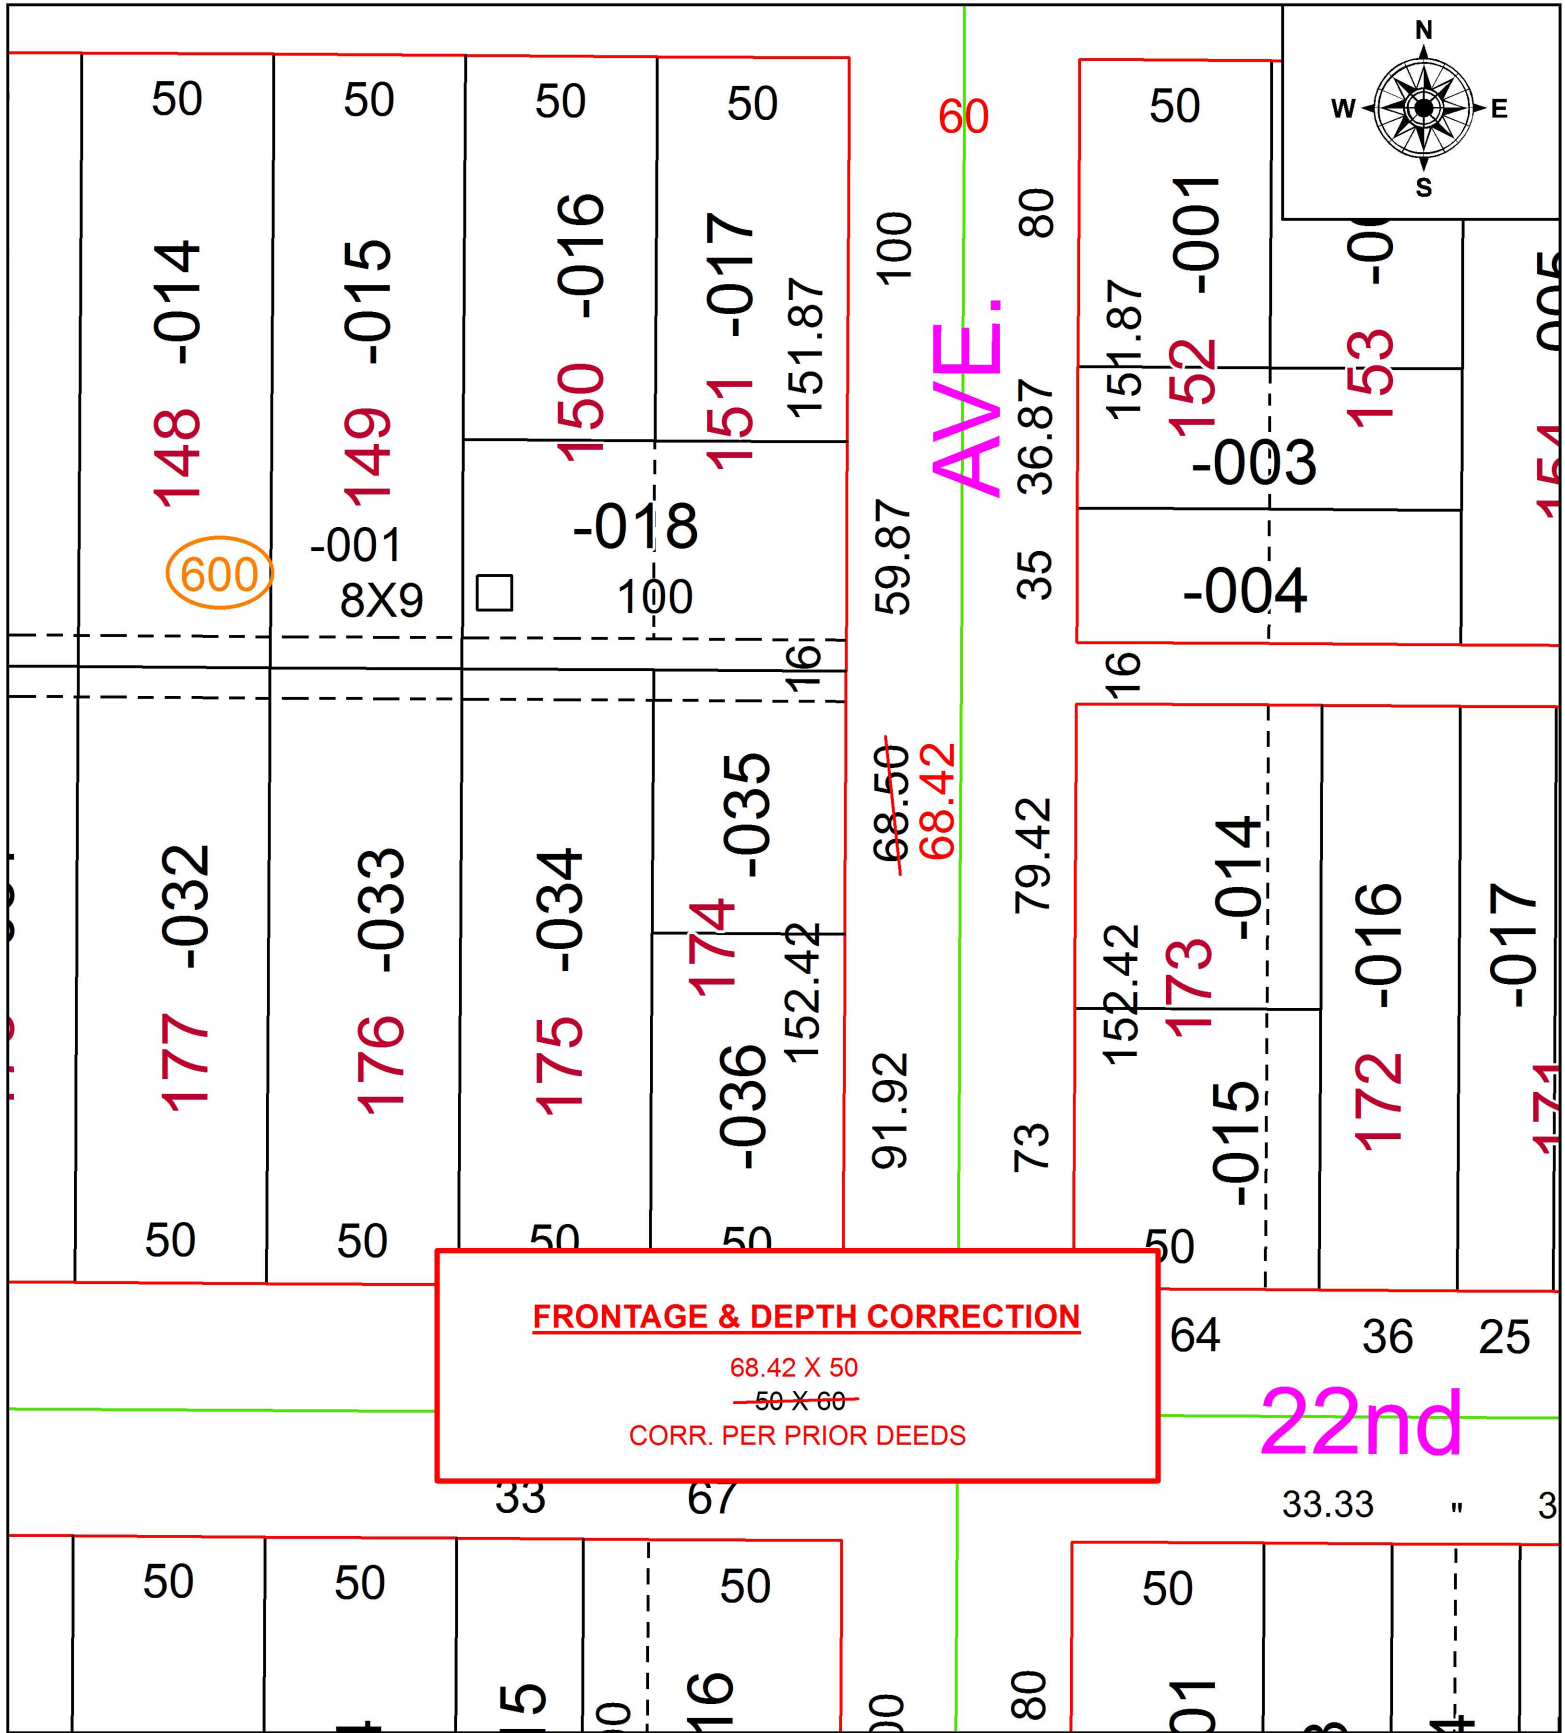

50

148 -014

600

50

149 -015

8X9

50

150 -016

100

50

151 -017

151.87

50

152 -001

151.87

177 -032

50

176 -033

50

175 -034

50

174 -035


50

152.42

173 -014

50


152.42

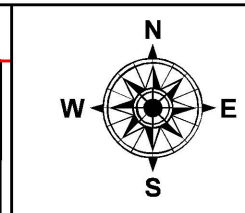

**FRONTAGE & DEPTH CORRECTION**

68.42 X 50  
~~50 X 60~~  
CORR. PER PRIOR DEEDS

22nd

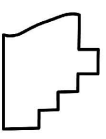

**SPLITS/DEEDS PROCESSED**  
LORAIN COUNTY TAX MAP DEPARTMENT  
226 MIDDLE AVE. ELYRIA, OH

SURVEYED BY: \_\_\_\_\_ N/A  
 CLOSURE: \_\_\_\_\_ N/A  
 MAP PAGE(S): \_\_\_\_\_ 2-01-006  
 APPROVED BY: \_\_\_\_\_ RRM DATE: \_\_\_\_\_ 7-23-19  
 SCALE: \_\_\_\_\_ 1" = 50 \_\_\_\_\_ PRIOR INSTRUMENT: \_\_\_\_\_ 20190719756