



PARENT PARCEL: 03-00-004-000-078 & -086, 03-00-005-000-096  
 CHILD PARCEL: 03-00-004-000-088 THRU -095 & 03-00-005-000-097 THRU -099  
 STARTING POINT: I.P. MON. BOX FD. 0.15' WEST OF CL OF FRENCH CREEK RD. & EAST LINE OF O.L. 5

20-04159

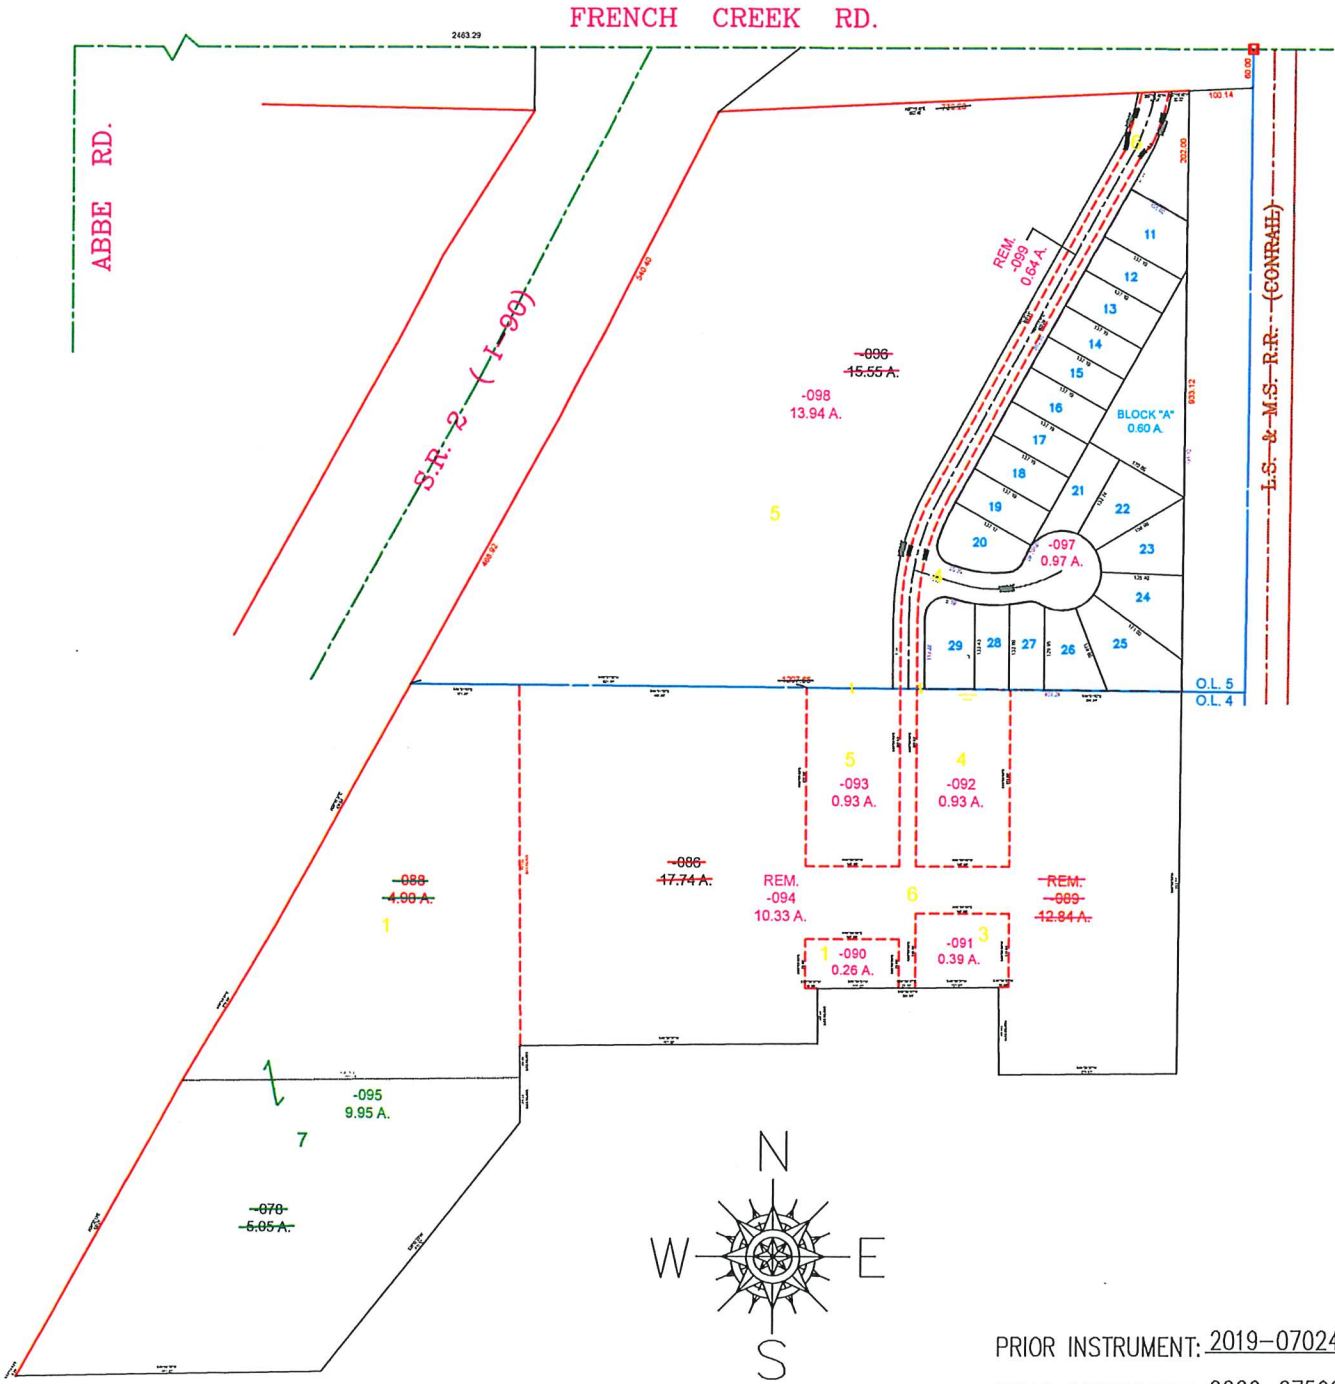

PRIOR INSTRUMENT: 2019-0702415  
 PRIOR INSTRUMENT: 2020-0759964

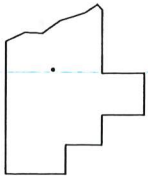

SPLITS/DEEDS PROCESSED  
 LORAIN COUNTY TAX MAP DEPARTMENT  
 226 MIDDLE AVE. ELYRIA, OHIO

SURVEYED BY: BRENT D. ANDERSON  
 CLOSURE: 0.01 : 10,000  
 MAP PAGE(S): 03-00-004 & -005  
 APPROVED BY: TJS DATE: 8/14/2020  
 SCALE: 1" = 300