


PARENT PARCEL: 03-00-109-125-002

CHILD PARCEL: XX-XX-XXX-XXX-XXX

STARTING POINT: SOUTH LINE OF NORTH RIDGE RD. & EAST LINE OF DV. 388 PG. 255

19-04161-A

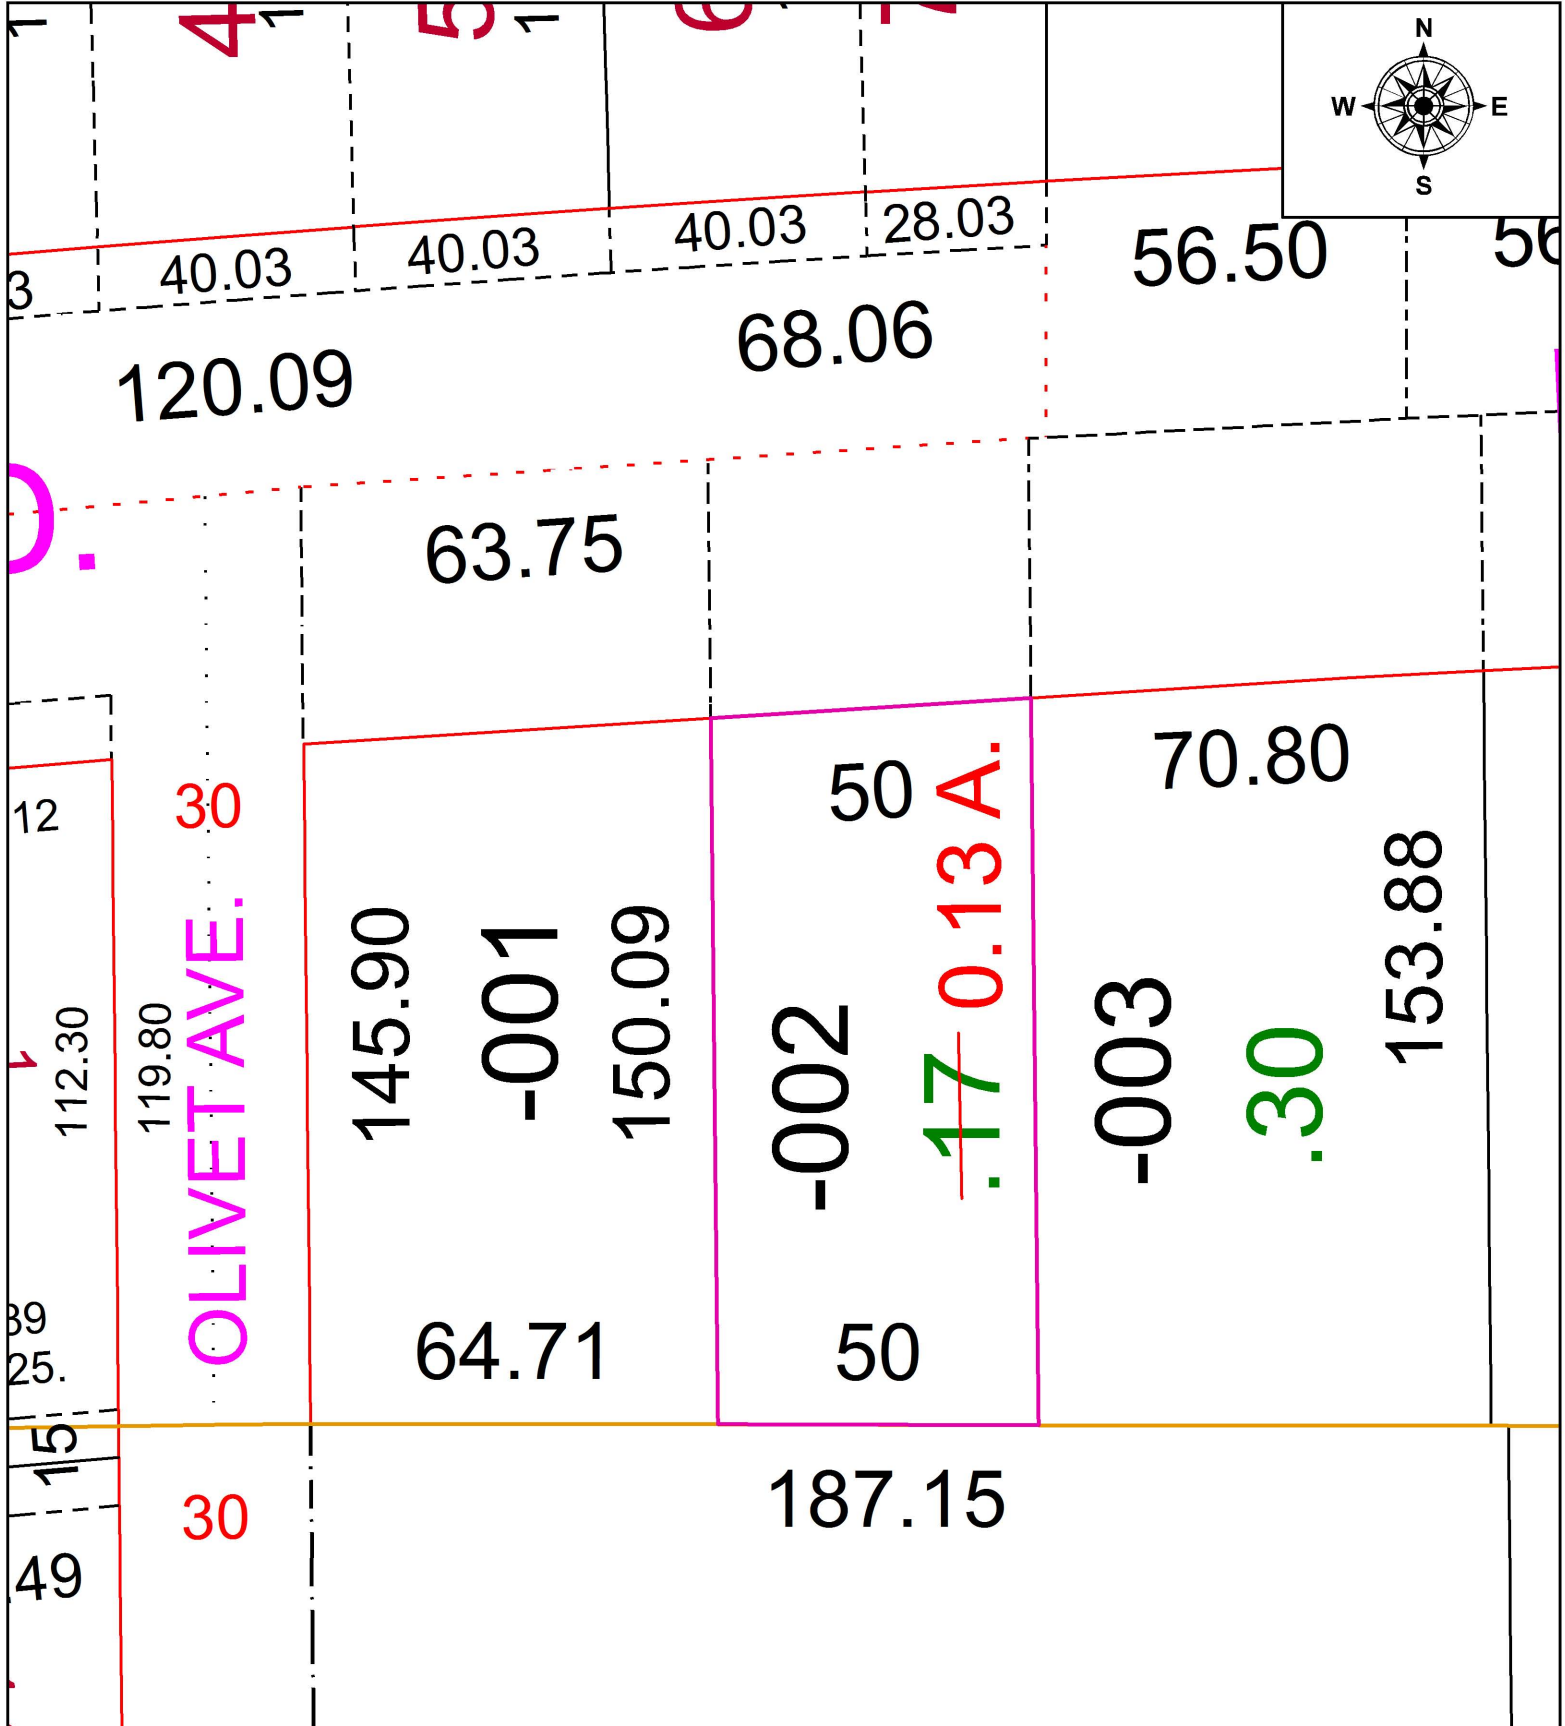

SPLITS/DEEDS PROCESSED
 LORAIN COUNTY TAX MAP DEPARTMENT
 226 MIDDLE AVE. ELYRIA, OH

SURVEYED BY: _____ NA
 CLOSURE: _____ NA
 MAP PAGE(S): _____ 03-00-109
 APPROVED BY: _____ TJS DATE: _____ 12/5/19
 SCALE: _____ 1" = 30' PRIOR INSTRUMENT: _____ 2016-0576281