
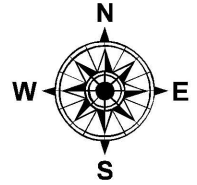


PARENT PARCEL: 05-00-068-000-026, -027

CHILD PARCEL: 05-00-068-000-051

STARTING POINT: NORTHWEST CORNER OF LAND CONVEYED TO A.E. & MARGARET BAUS

19-04164-C

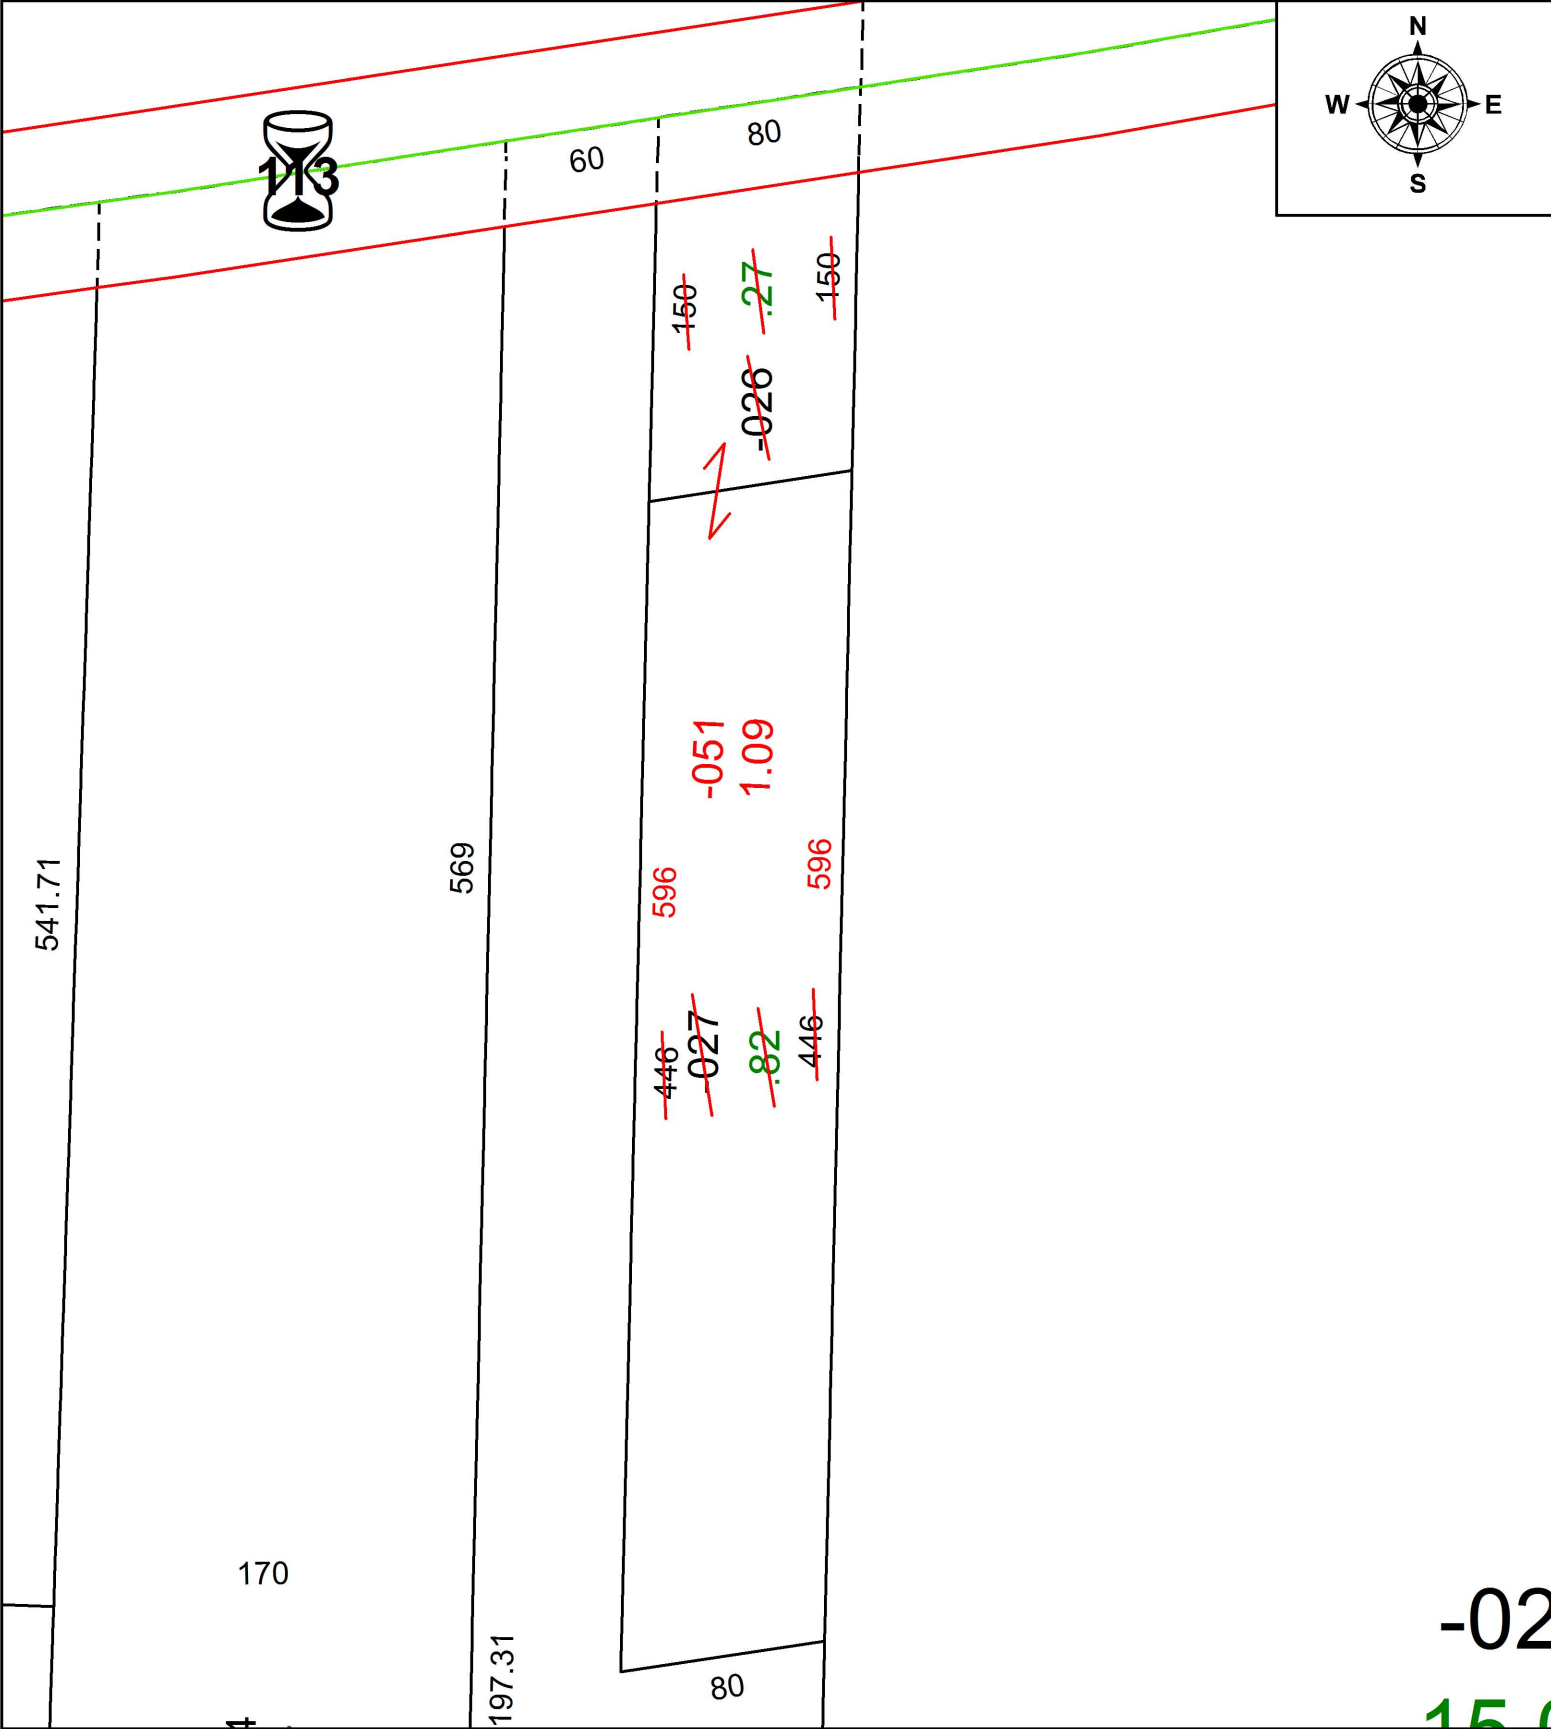

170

541.71

569

197.31

80

596

~~446~~

~~027~~

~~82~~

~~446~~

-051

1.09

~~150~~


~~026~~

~~27~~

~~150~~

-027

150

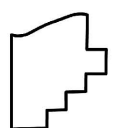

SPLITS/DEEDS PROCESSED

LORAIN COUNTY TAX MAP DEPARTMENT
226 MIDDLE AVE. ELYRIA, OH

SURVEYED BY:	N/A		
CLOSURE:	N/A		
MAP PAGE(S):	5-00-068		
APPROVED BY:	RRM	DATE:	8-1-19
SCALE:	1" = 75'	PRIOR INSTRUMENT:	20090282932