
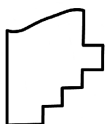


PARENT PARCEL: 14-00-118-000-002

CHILD PARCEL: 14-00-118-000-003, -004

STARTING POINT: NORTHEAST CORNER OF O.L. 118

20-04170

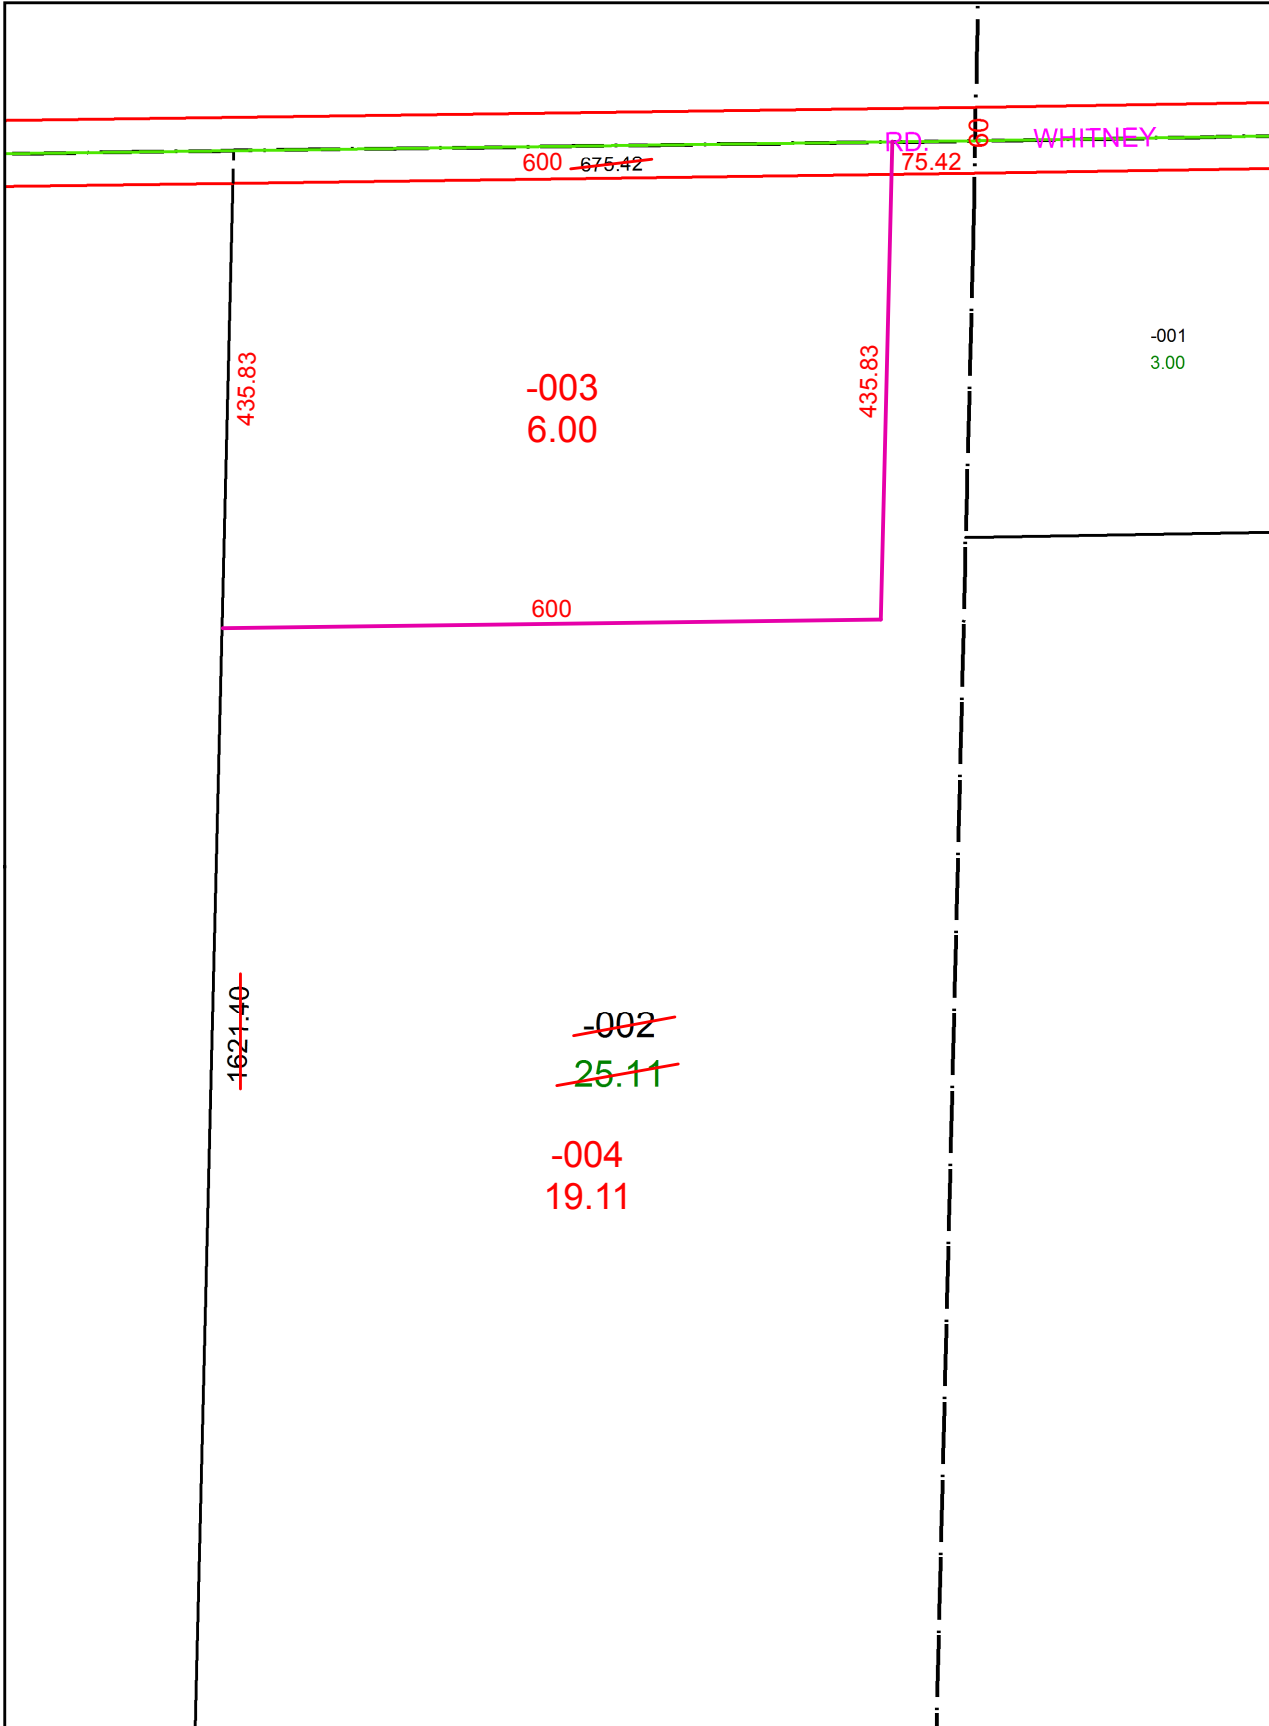

SPLITS/DEEDS PROCESSED
 LORAIN COUNTY TAX MAP DEPARTMENT
 226 MIDDLE AVE. ELYRIA, OH

SURVEYED BY: RICHARD D. CARLSON

CLOSURE: 1:2147483648

MAP PAGE(S): 14-00-118

APPROVED BY: RRM DATE: 8-21-20

SCALE: 1" = 175 PRIOR INSTRUMENT: 20070225303