


PARENT PARCEL: 01-00-003-104-023

CHILD PARCEL: 01-00-003-104-072 THRU -074

STARTING POINT: S/L'S 844, 845 AND 846 IN VERMILION ON THE LAKE SUB. NO.1

19-04176-U

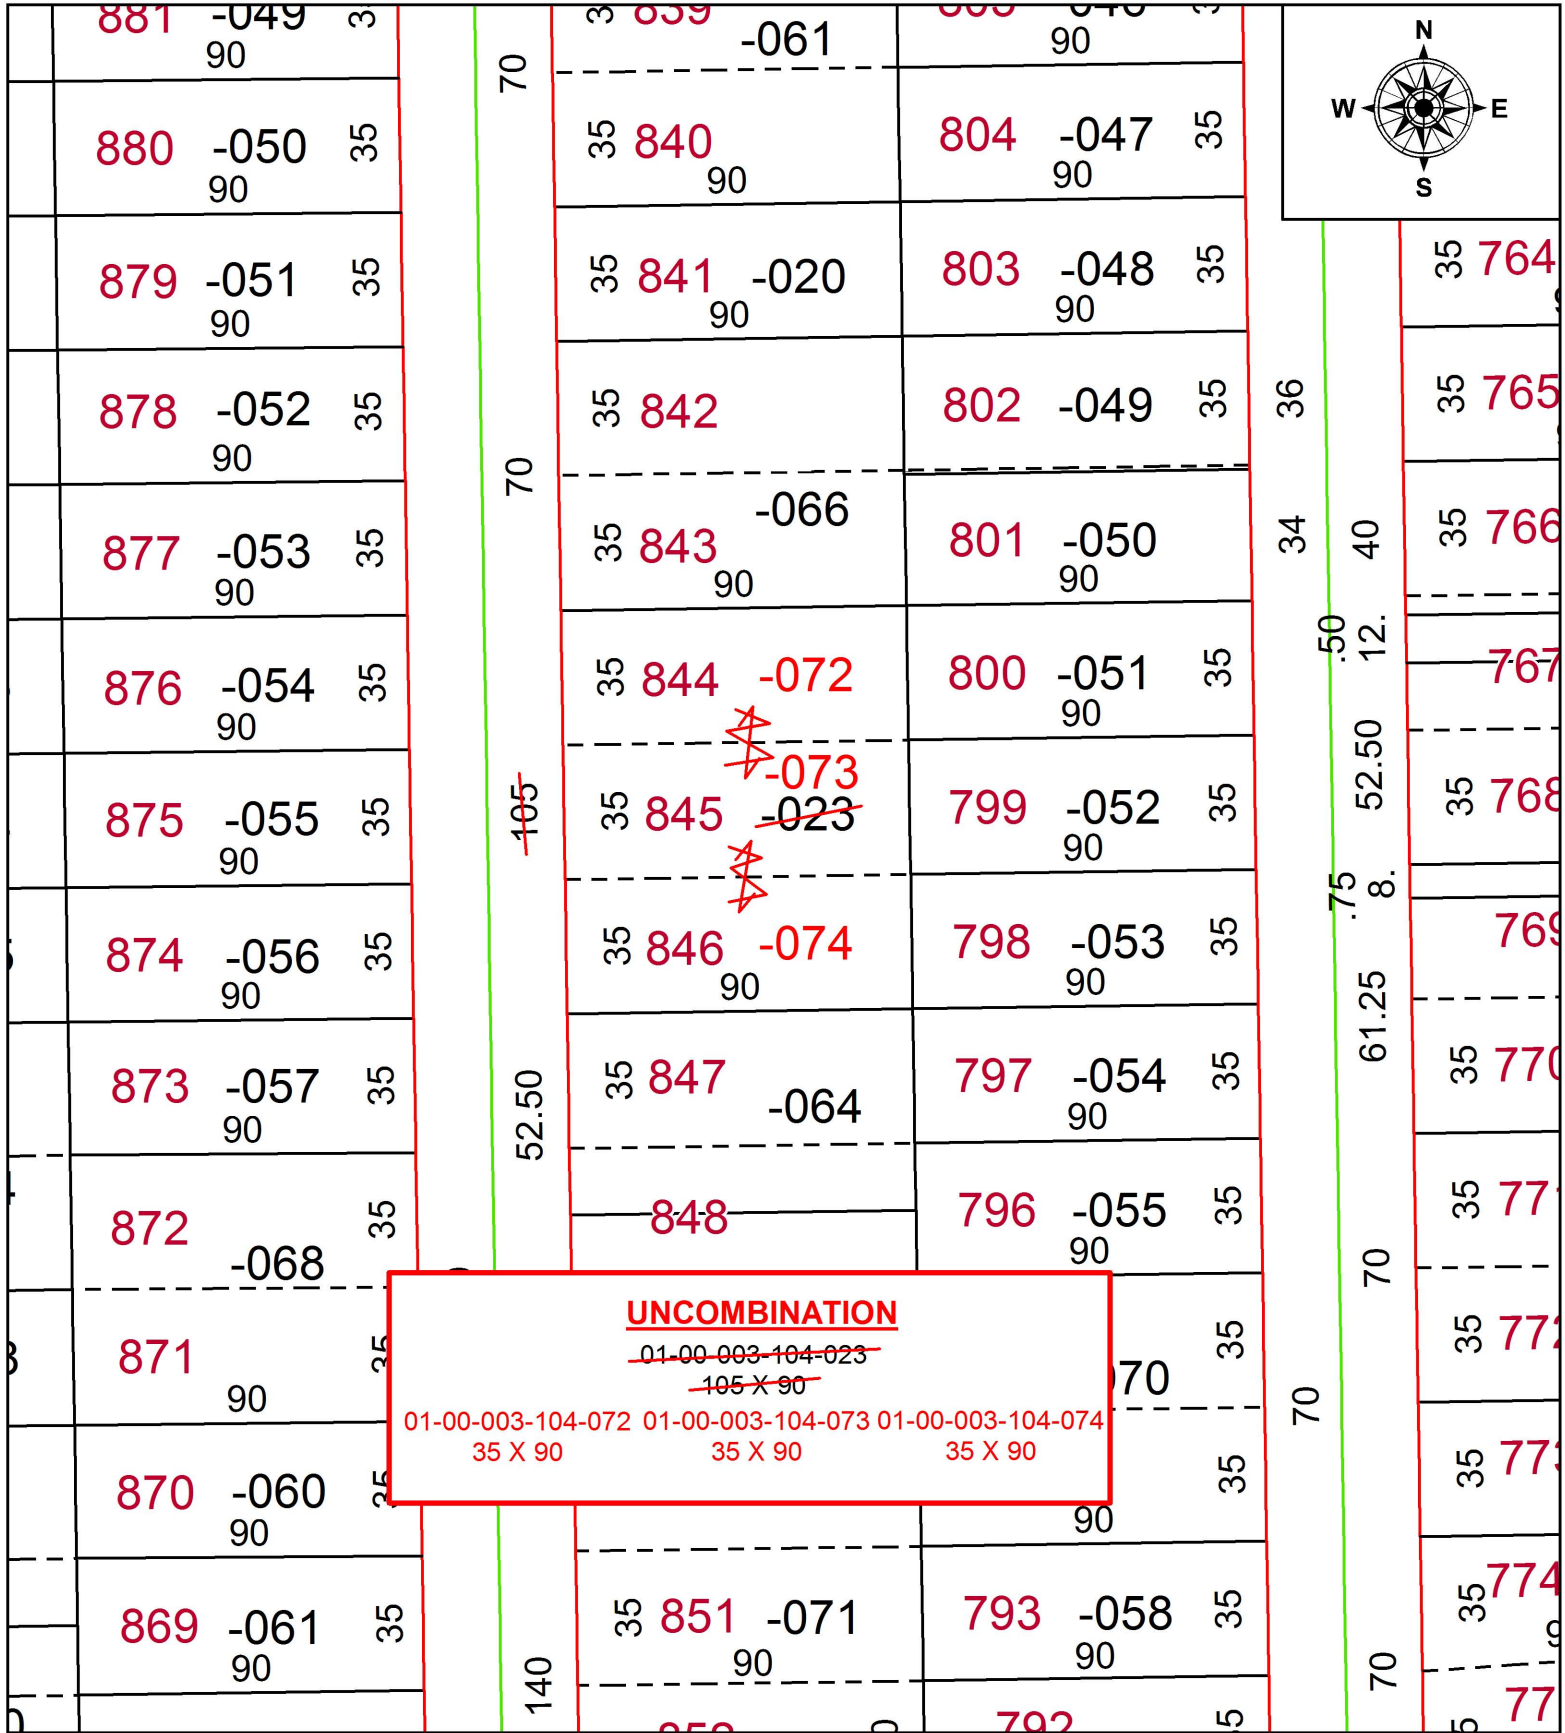

SPLITS/DEEDS PROCESSED
 LORAIN COUNTY TAX MAP DEPARTMENT
 226 MIDDLE AVE. ELYRIA, OH

SURVEYED BY: N/A
 CLOSURE: N/A
 MAP PAGE(S): 1-00-003
 APPROVED BY: RRM DATE: 8-16-19
 SCALE: 1" = 50' PRIOR INSTRUMENT: 20000709232