


PARENT PARCEL: 03-00-046-104-006


CHILD PARCEL: 03-00-046-104-015, -016, 03-00-047-110-020

STARTING POINT: S/L 67 AND SOUTH HALF OF S/L 68 IN COLLAR DAY ALLOTMENT

19-04180-U

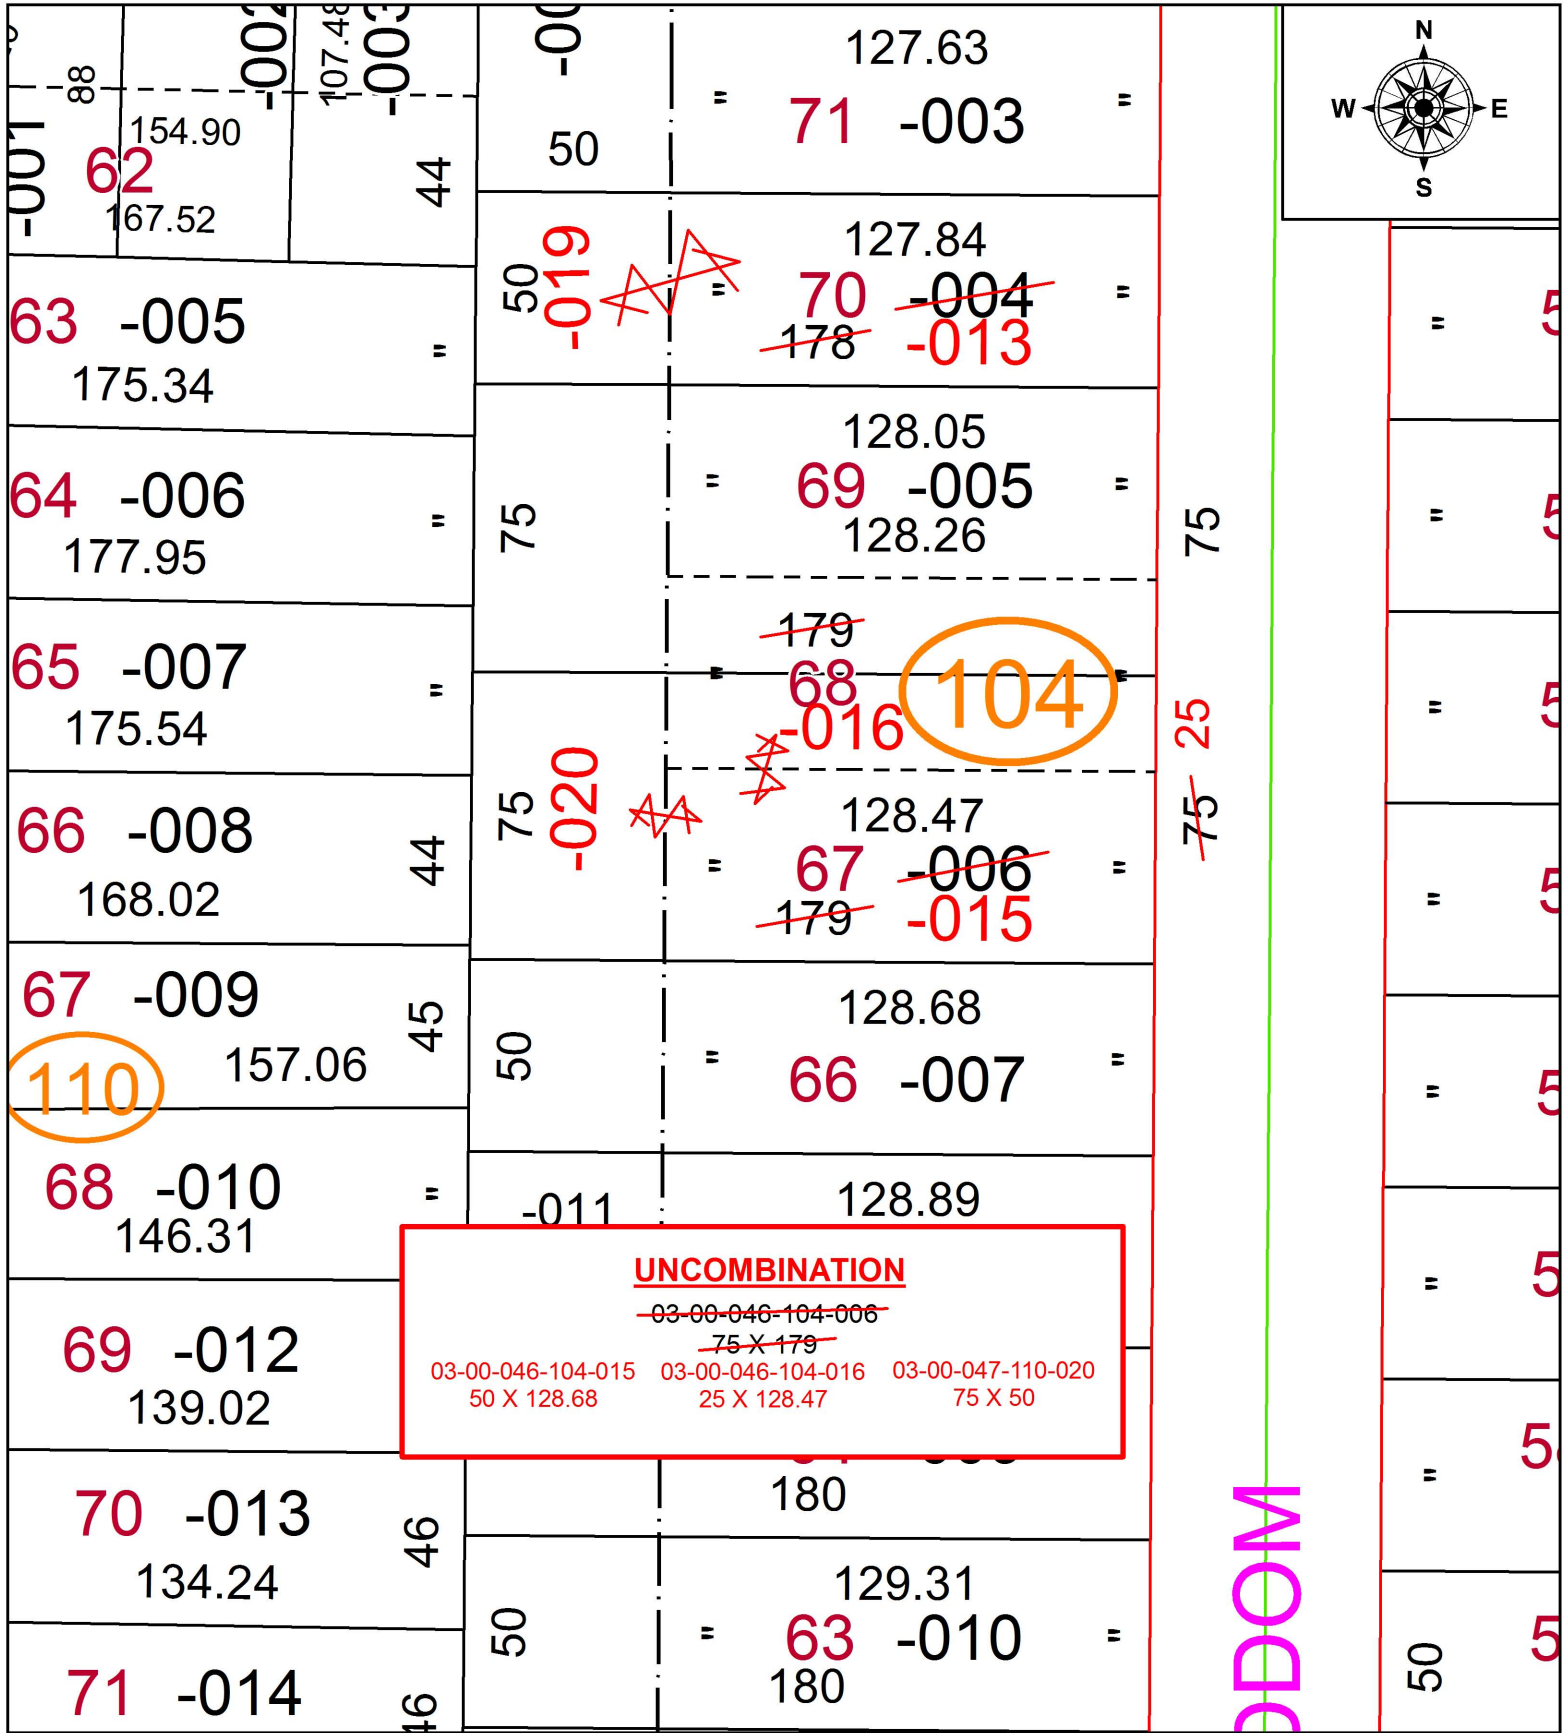

**UNCOMBINATION**  
~~03-00-046-104-006~~  
~~75 X 179~~  
 03-00-046-104-015 50 X 128.68    03-00-046-104-016 25 X 128.47    03-00-047-110-020 75 X 50

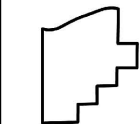

**SPLITS/DEEDS PROCESSED**  
 LORAIN COUNTY TAX MAP DEPARTMENT  
 226 MIDDLE AVE. ELYRIA, OH

SURVEYED BY: N/A  
 CLOSURE: N/A  
 MAP PAGE(S): 3-00-046  
 APPROVED BY: RRM DATE: 8-30-19  
 SCALE: 1" = 50' PRIOR INSTRUMENT: 20090313710