
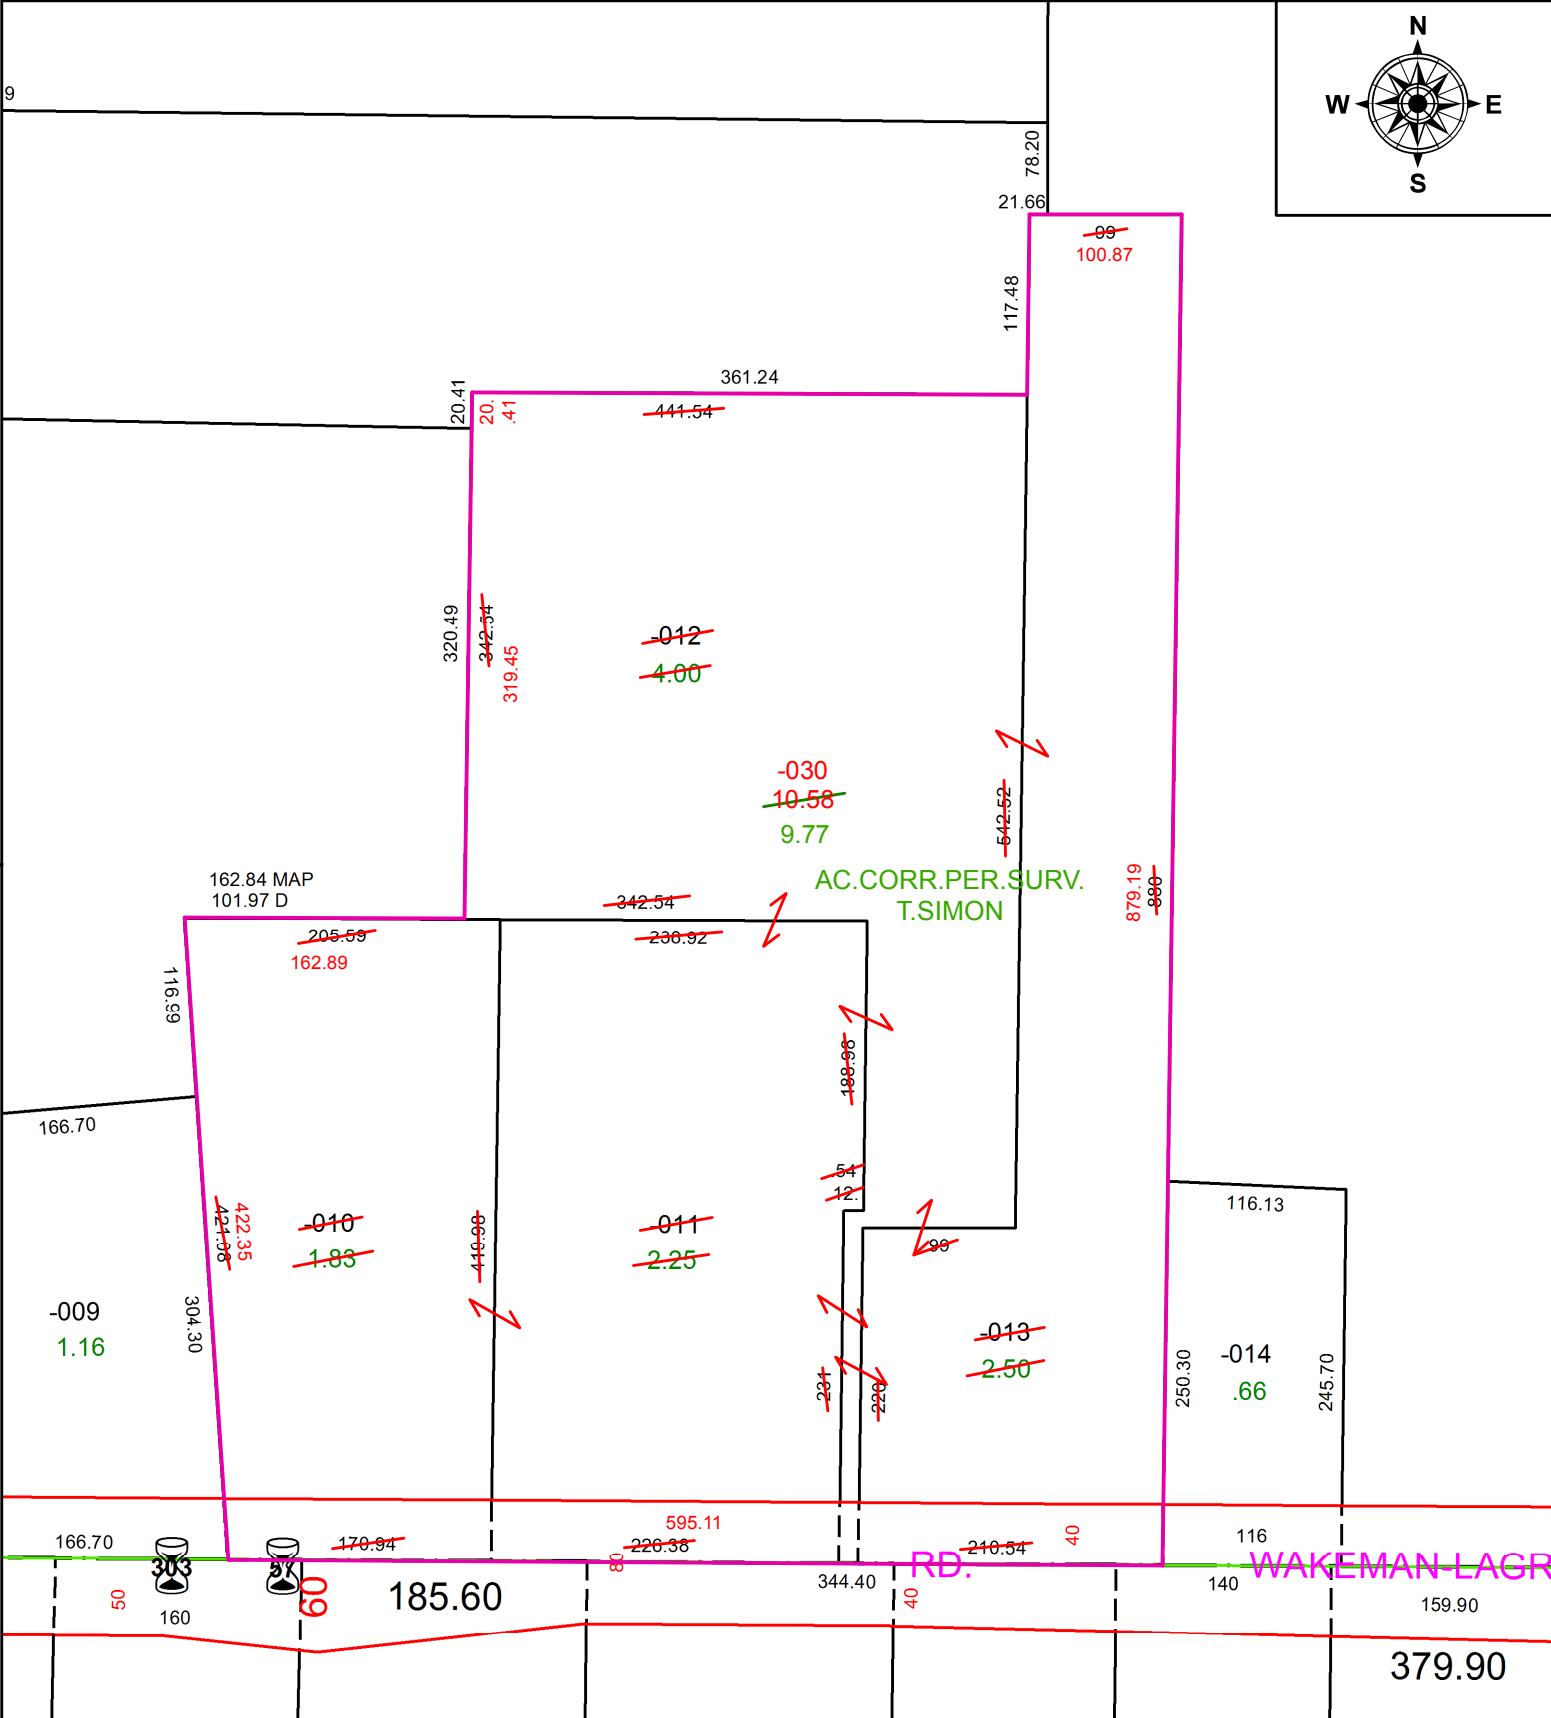


PARENT PARCEL: 16-00-046-000-010 THRU -013

CHILD PARCEL: 16-00-046-000-030

STARTING POINT: INTERSECTION OF C/L OF S.R. 303 AN C/L OF S.R. 83

20-04185

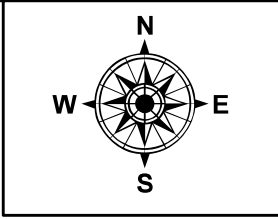

SPLITS/DEEDS PROCESSED
LORAIN COUNTY TAX MAP DEPARTMENT
226 MIDDLE AVE. ELYRIA, OH

SURVEYED BY: THOMAS A. SIMON
CLOSURE: 1:16,533
MAP PAGE(S): 16-00-046
APPROVED BY: RRM DATE: 10-7-20
SCALE: 1" = 125 PRIOR INSTRUMENT: 20200766854