


PARENT PARCEL: 12-00-015-000-010

CHILD PARCEL: **ACREAGE CORRECTION PER DEED INST.# 2014-0493945**

STARTING POINT: N.W. CORNER OF BAENA DV 364/219

19-04187-C

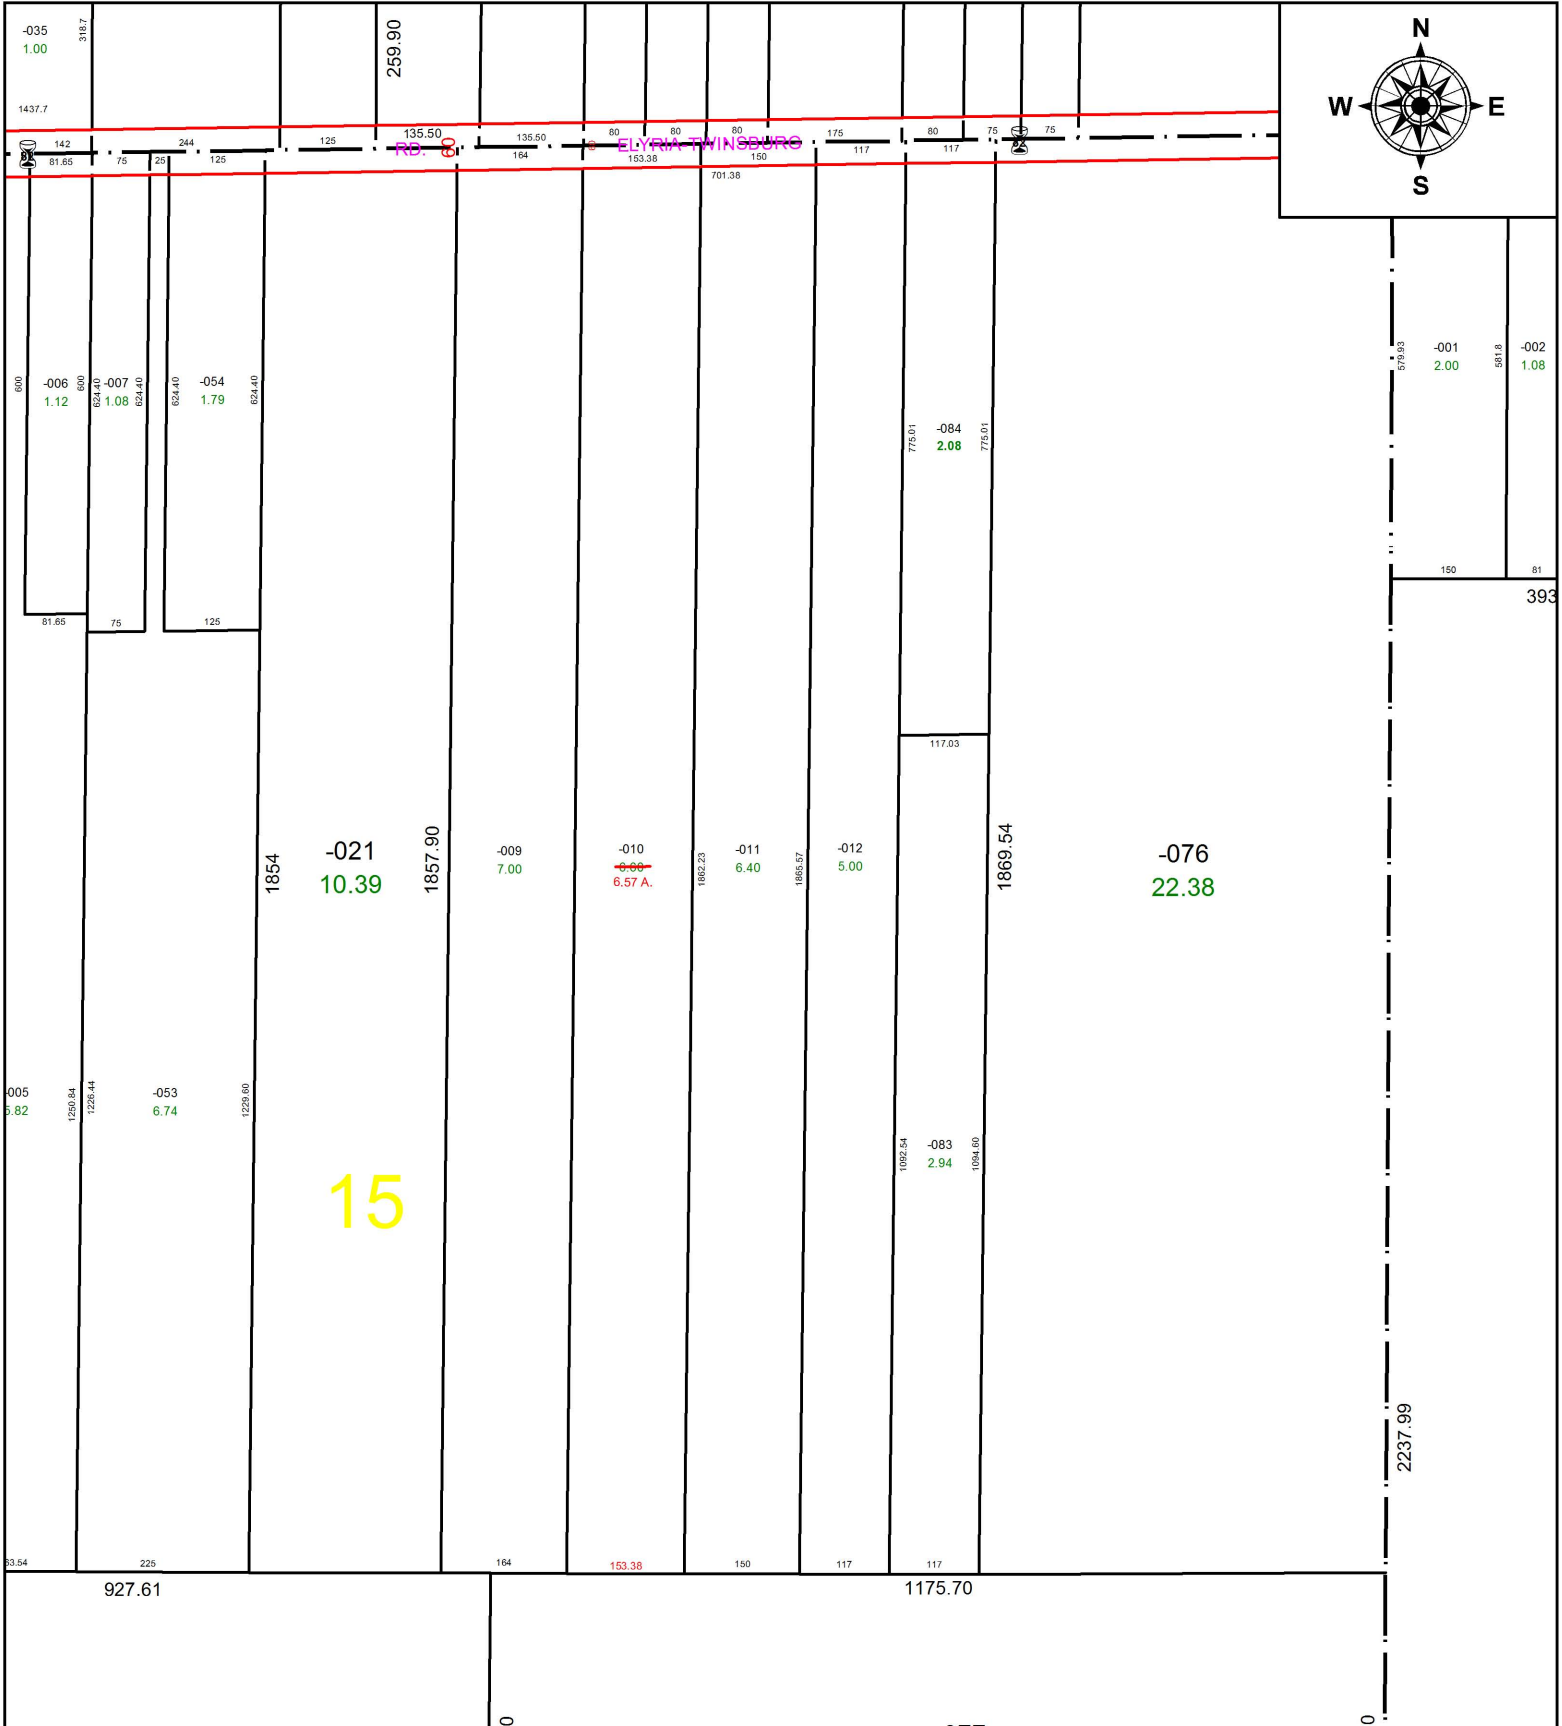

**SPLITS/DEEDS PROCESSED**  
 LORAIN COUNTY TAX MAP DEPARTMENT  
 226 MIDDLE AVE. ELYRIA, OH

SURVEYED BY: NA  
 CLOSURE: NA  
 MAP PAGE(S): 12-00-015  
 APPROVED BY: TJS DATE: 2/7/2020  
 SCALE: 1" = 250' PRIOR INSTRUMENT: 2014-0493945