
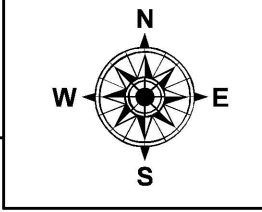


PARENT PARCEL: 18-00-021-106-031, -032, -033

CHILD PARCEL:

STARTING POINT: NORTHWEST CORNER OF S/L 34 IN ADAMS ADDITION

19-04188-C

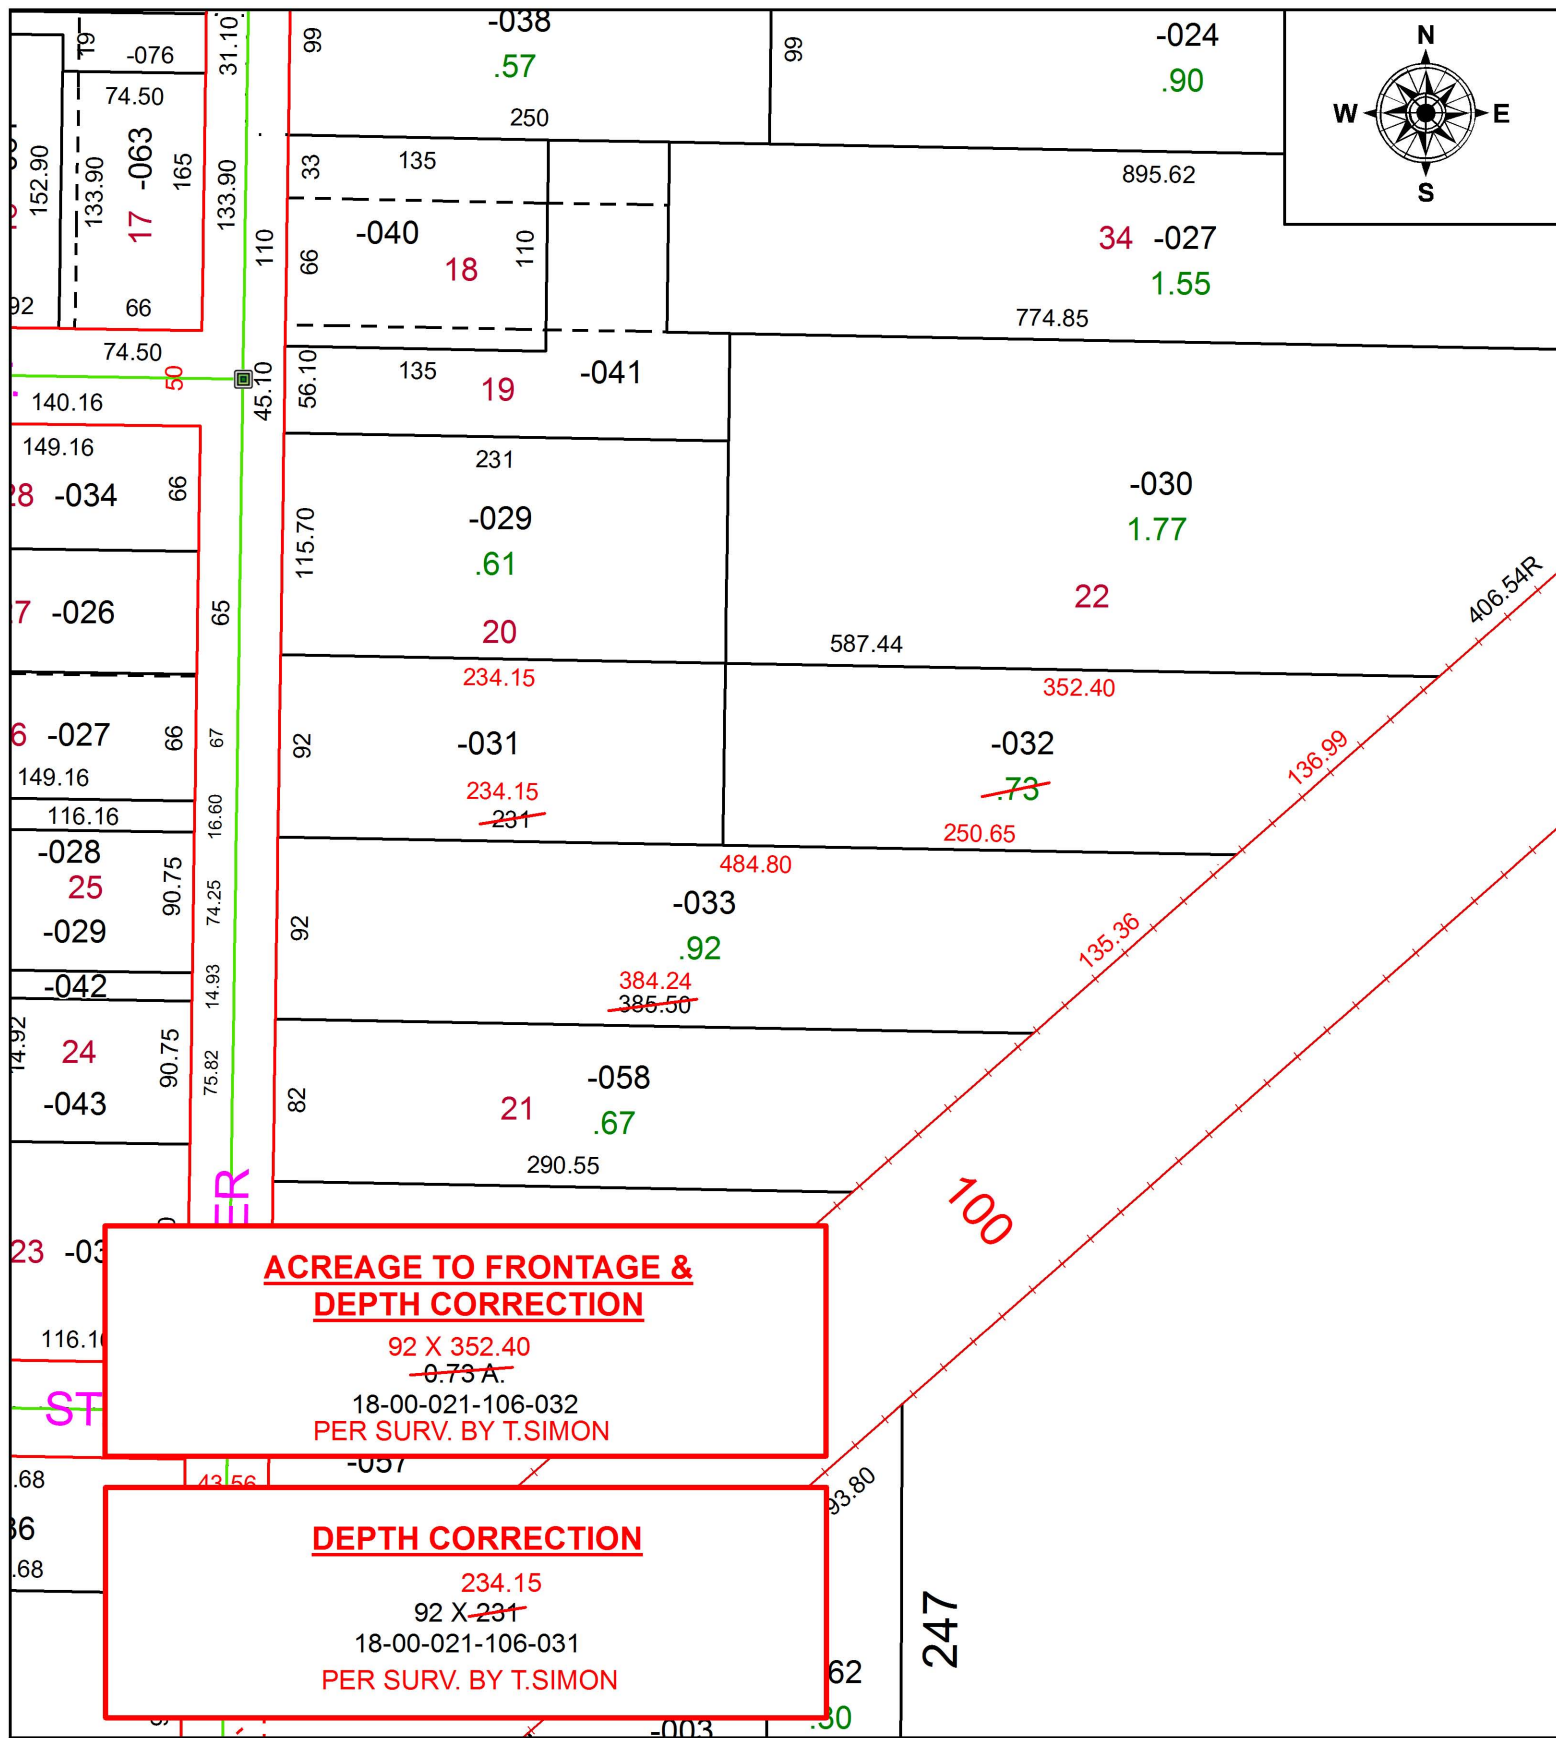

ACREAGE TO FRONTAGE & DEPTH CORRECTION
 92 X 352.40
~~0.73 A.~~
 18-00-021-106-032
 PER SURV. BY T.SIMON

DEPTH CORRECTION
 234.15
 92 X ~~231~~
 18-00-021-106-031
 PER SURV. BY T.SIMON

SPLITS/DEEDS PROCESSED
 LORAIN COUNTY TAX MAP DEPARTMENT
 226 MIDDLE AVE. ELYRIA, OH

SURVEYED BY: THOMAS A. SIMON
 CLOSURE: 1:452,100
 MAP PAGE(S): 18-00-021
 APPROVED BY: RRM DATE: 9-19-19
 SCALE: 1" = 100 PRIOR INSTRUMENT: 20190706120