
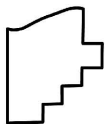


PARENT PARCEL: 04-00-001-103-042

CHILD PARCEL:

STARTING POINT: SOUTHWEST CORNER OF LAND CONVEYED TO MICHAEL J. & D.F. VERIB

19-04192-A

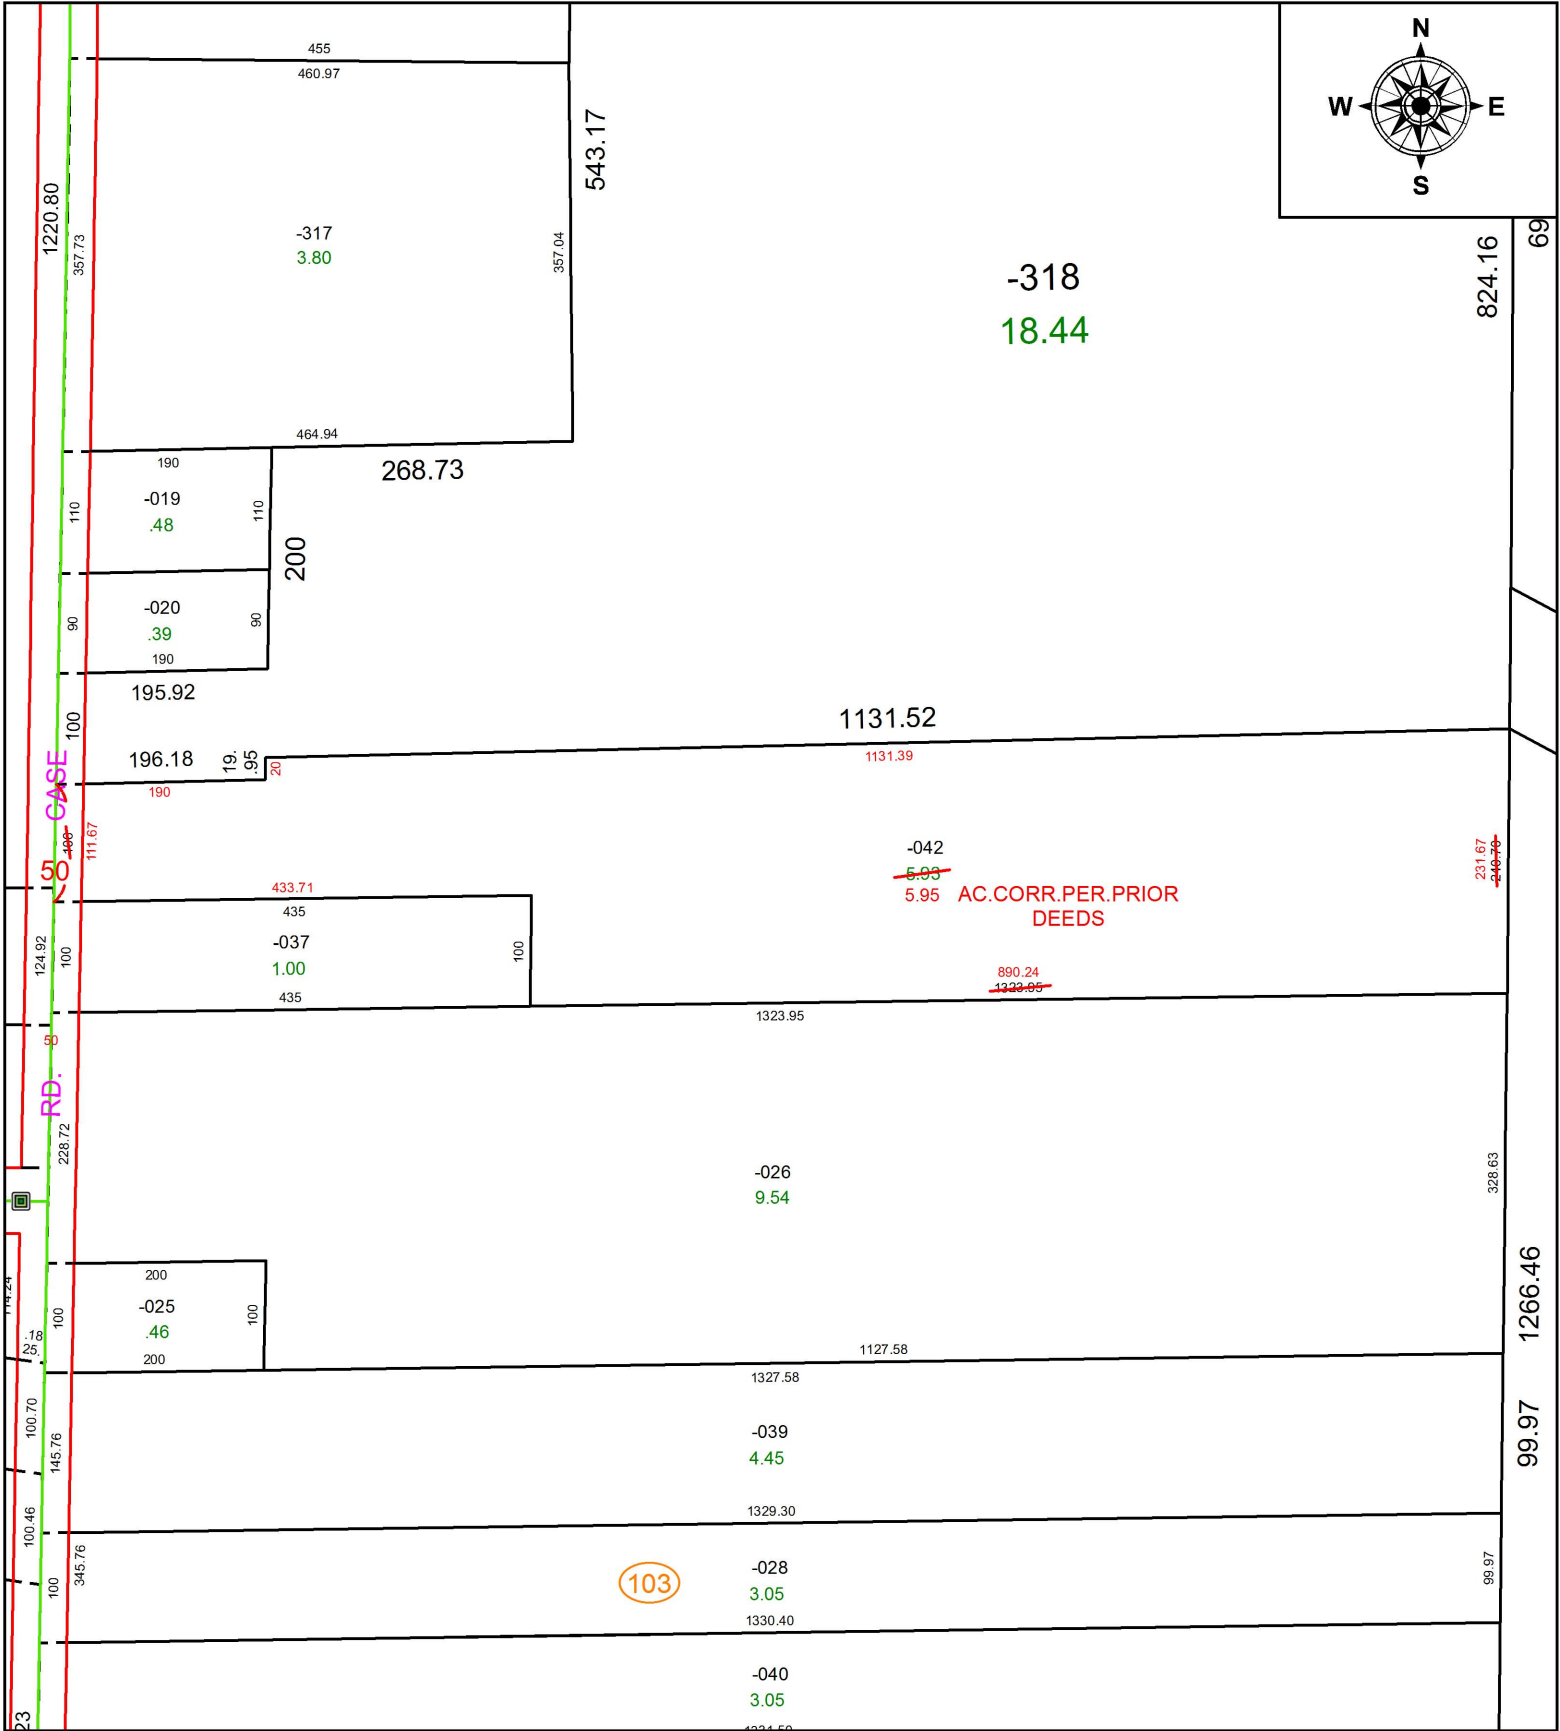

**SPLITS/DEEDS PROCESSED**  
 LORAIN COUNTY TAX MAP DEPARTMENT  
 226 MIDDLE AVE. ELYRIA, OH

SURVEYED BY: \_\_\_\_\_ N/A  
 CLOSURE: \_\_\_\_\_ 1:49,983  
 MAP PAGE(S): \_\_\_\_\_ 4-00-001  
 APPROVED BY: \_\_\_\_\_ RRM DATE: \_\_\_\_\_ 9-25-19  
 SCALE: \_\_\_\_\_ 1" = 175 \_\_\_\_\_ PRIOR INSTRUMENT: \_\_\_\_\_ 19980555468