
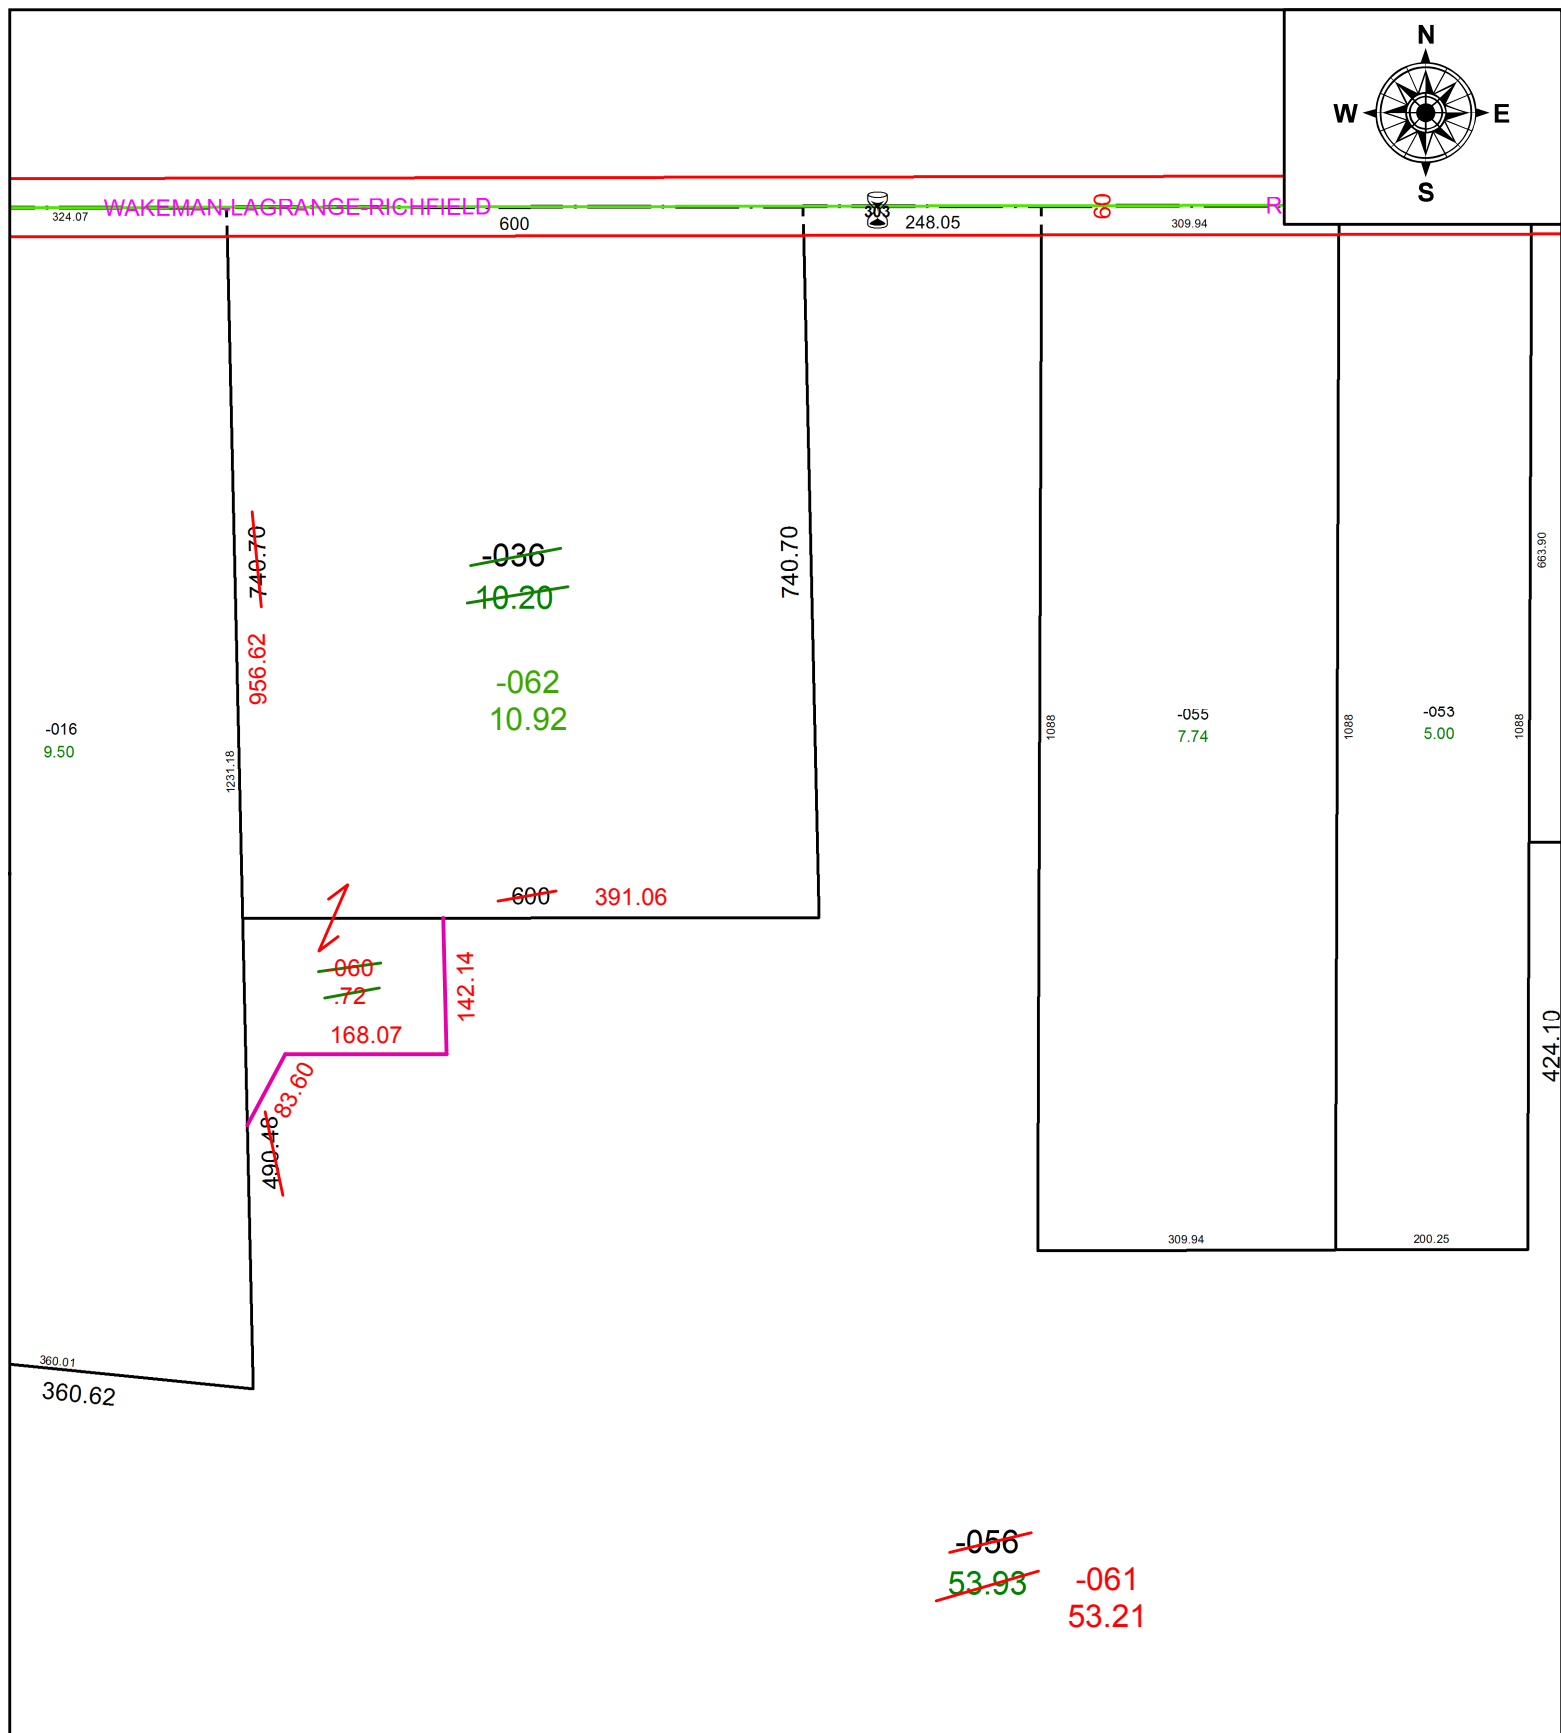


PARENT PARCEL: 15-00-058-000-036, -056

CHILD PARCEL: 15-00-058-000-060 THRU -062

STARTING POINT: NORTHWEST CORNER OF O.L.58

20-04192

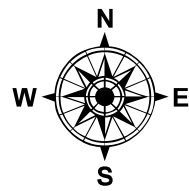

SPLITS/DEEDS PROCESSED
 LORAIN COUNTY TAX MAP DEPARTMENT
 226 MIDDLE AVE. ELYRIA, OH

SURVEYED BY: ALEX MARKS
 CLOSURE: 1:97,007
 MAP PAGE(S): 15-00-058
 APPROVED BY: RRM DATE: 10-14-20
 SCALE: 1" = 200 PRIOR INSTRUMENT: 20090289142