


PARENT PARCEL: 01-00-072-000-009, -010, 01-00-073-000-010, -018


CHILD PARCEL: 01-00-072-000-016, 01-00-073-000-023 THRU -025

STARTING POINT: INTERSECTION OF C/L OF NICHOLSON AVE. AND C/L OF LIBERTY AVE.

20-04193

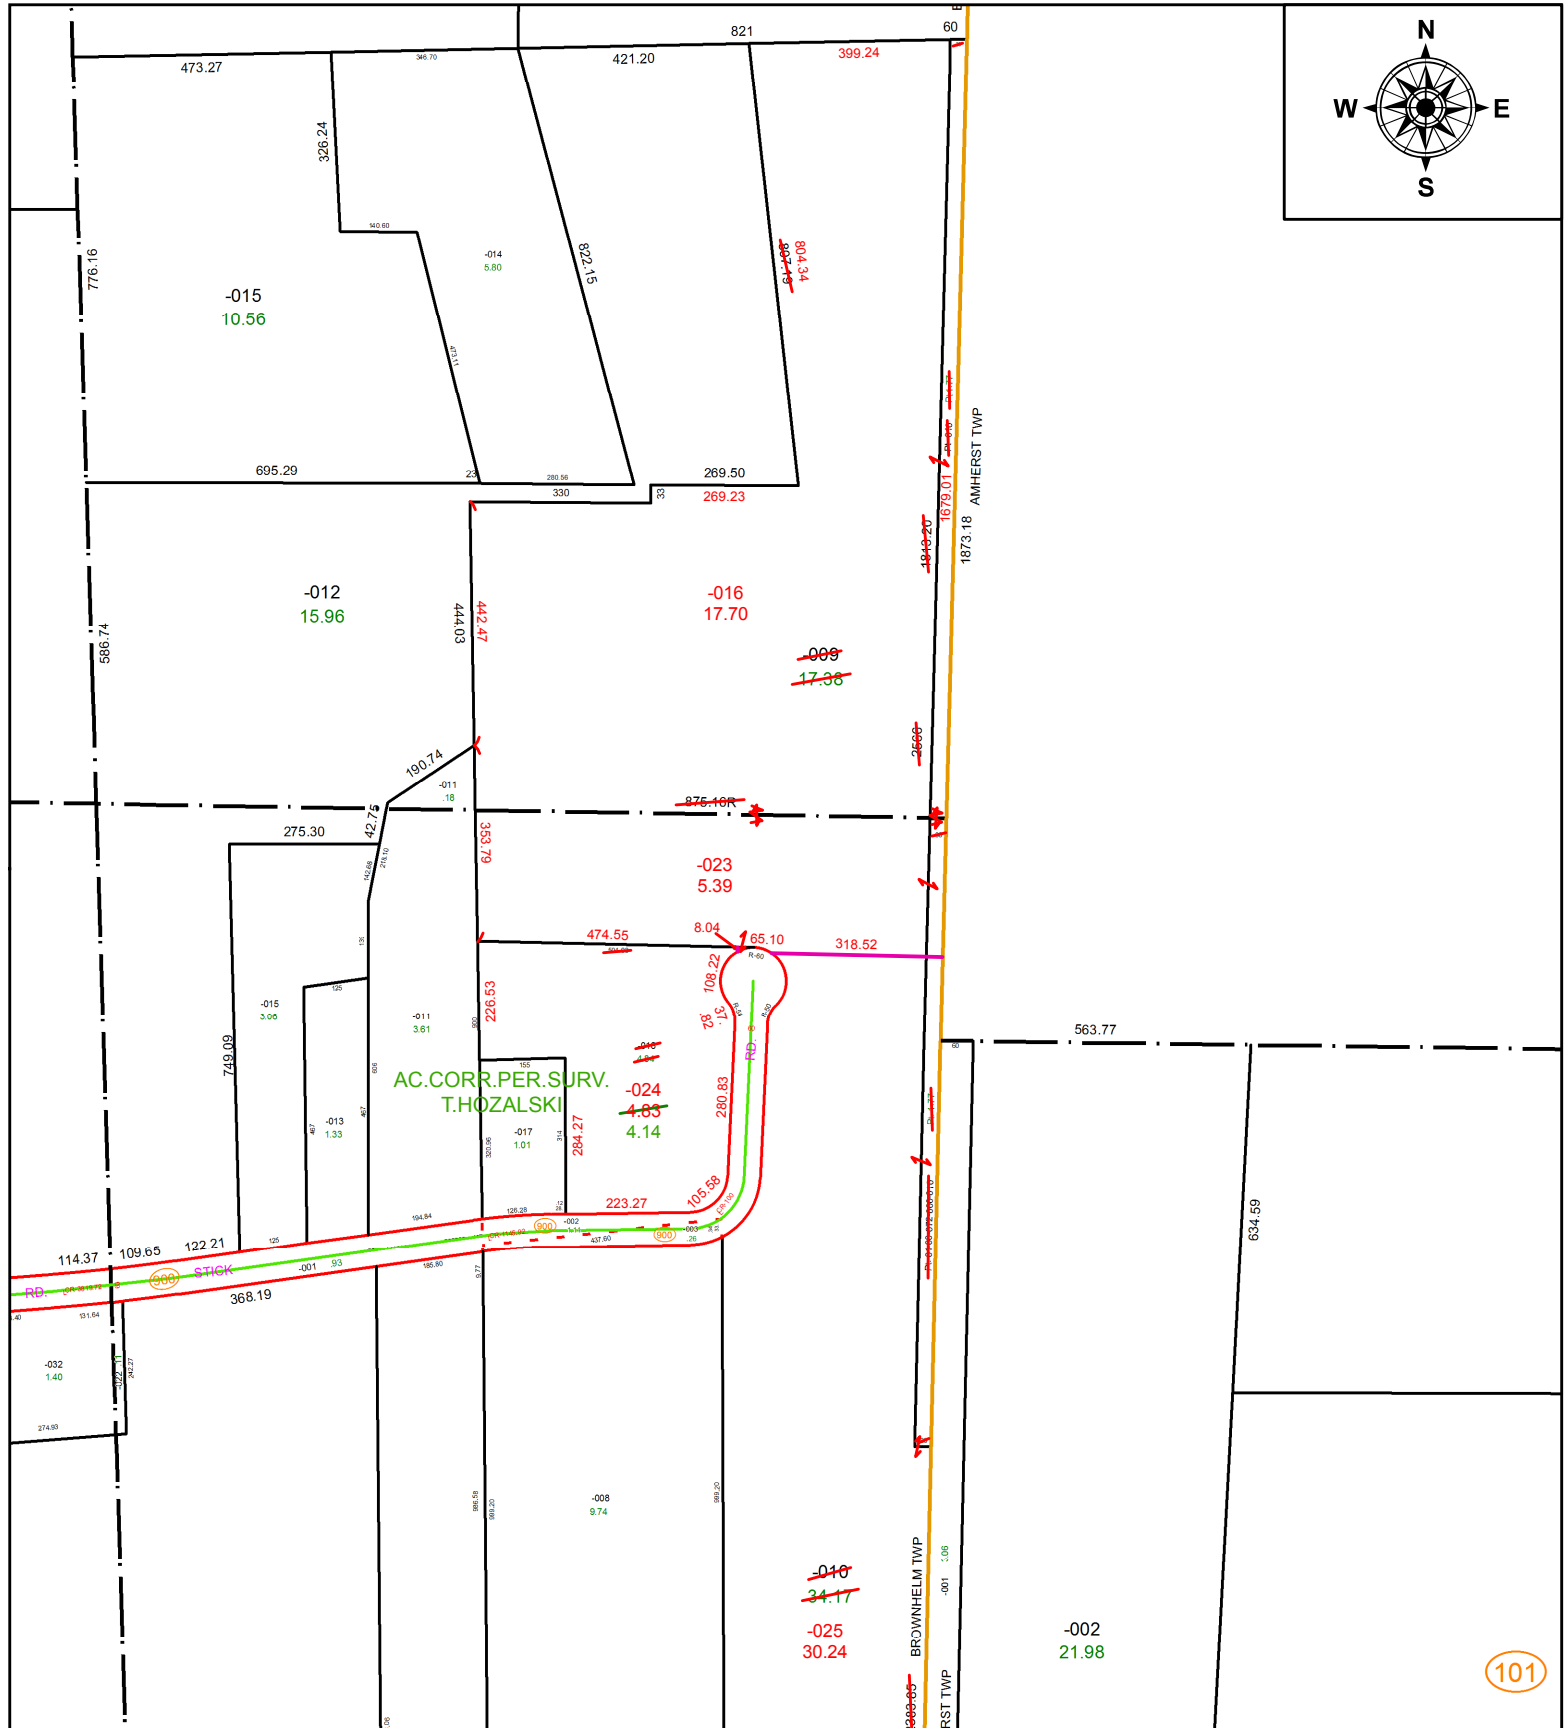

101

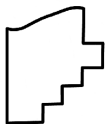

SPLITS/DEEDS PROCESSED
LORAIN COUNTY TAX MAP DEPARTMENT
226 MIDDLE AVE. ELYRIA, OH

SURVEYED BY: TIMOTHY D. HOZALSKI

CLOSURE: 1:259,486

MAP PAGE(S): 1-00-073

APPROVED BY: RRM DATE: 10-16-20

SCALE: 1" = 350 PRIOR INSTRUMENT: DV 1382/461