


PARENT PARCEL: 04-00-019-144-031

CHILD PARCEL:

STARTING POINT: INTERSECTION OF C/L OF LEAR RD. AND C/L OF WALKER RD.

19-04194-A

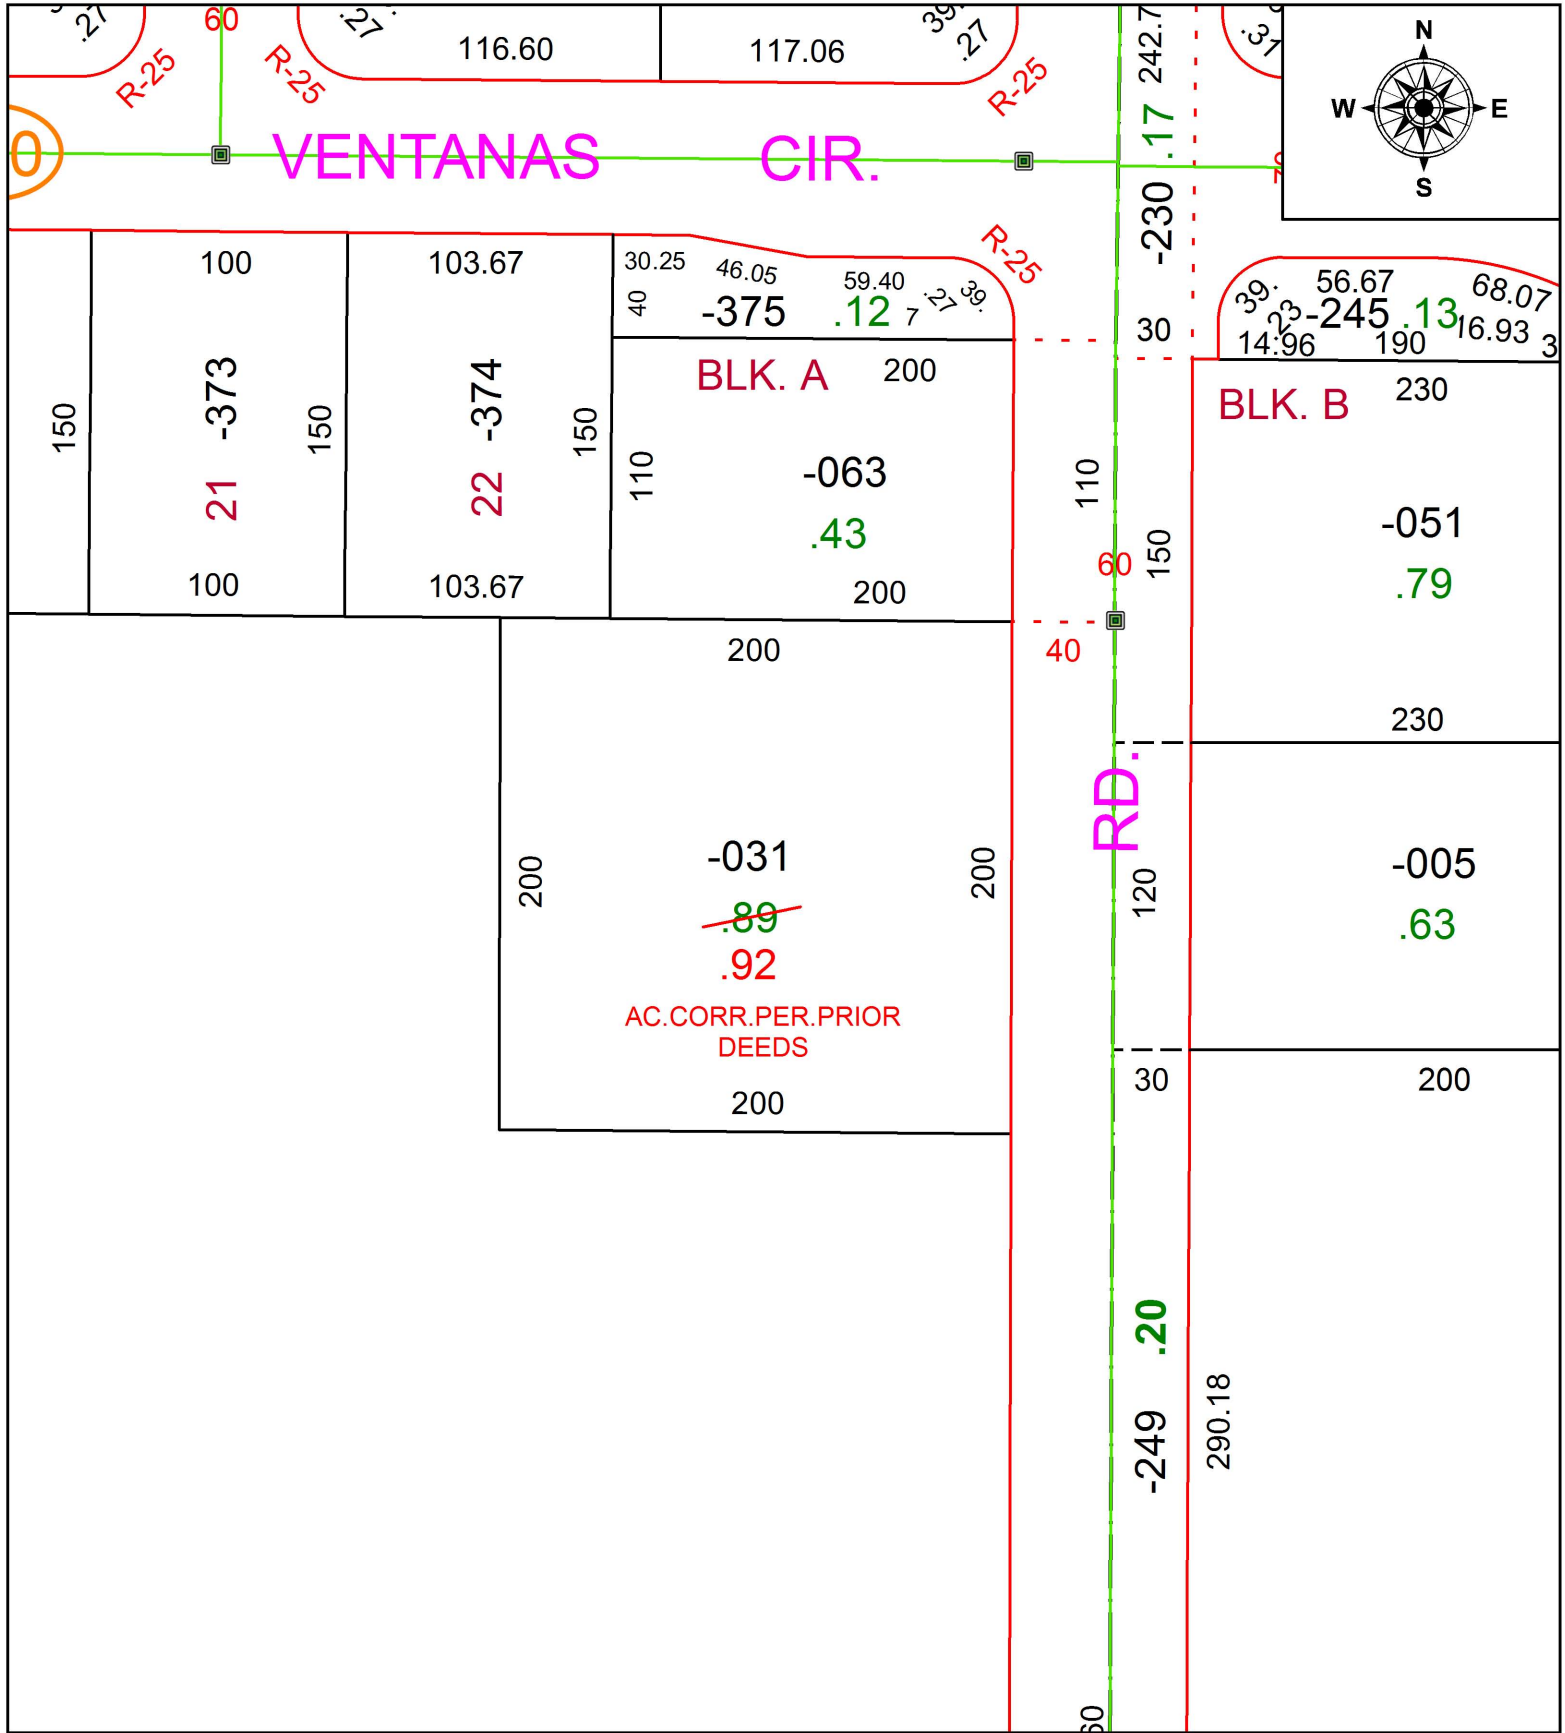

SPLITS/DEEDS PROCESSED
 LORAIN COUNTY TAX MAP DEPARTMENT
 226 MIDDLE AVE. ELYRIA, OH

SURVEYED BY: _____ N/A
 CLOSURE: 1:2147483648
 MAP PAGE(S): 4-00-019
 APPROVED BY: RRM DATE: 9-25-19
 SCALE: 1" = 75' PRIOR INSTRUMENT: 2019091207