


PARENT PARCEL: 01-00-043-000-004, 01-00-044-000-045, -046

CHILD PARCEL: 01-00-043-000-073, -074, 01-00-044-000-054 THRU -056

STARTING POINT: INTERSECTION OF C/L OF CLAUS RD. AND C/L OF NORTH RIDGE RD.

20-04194

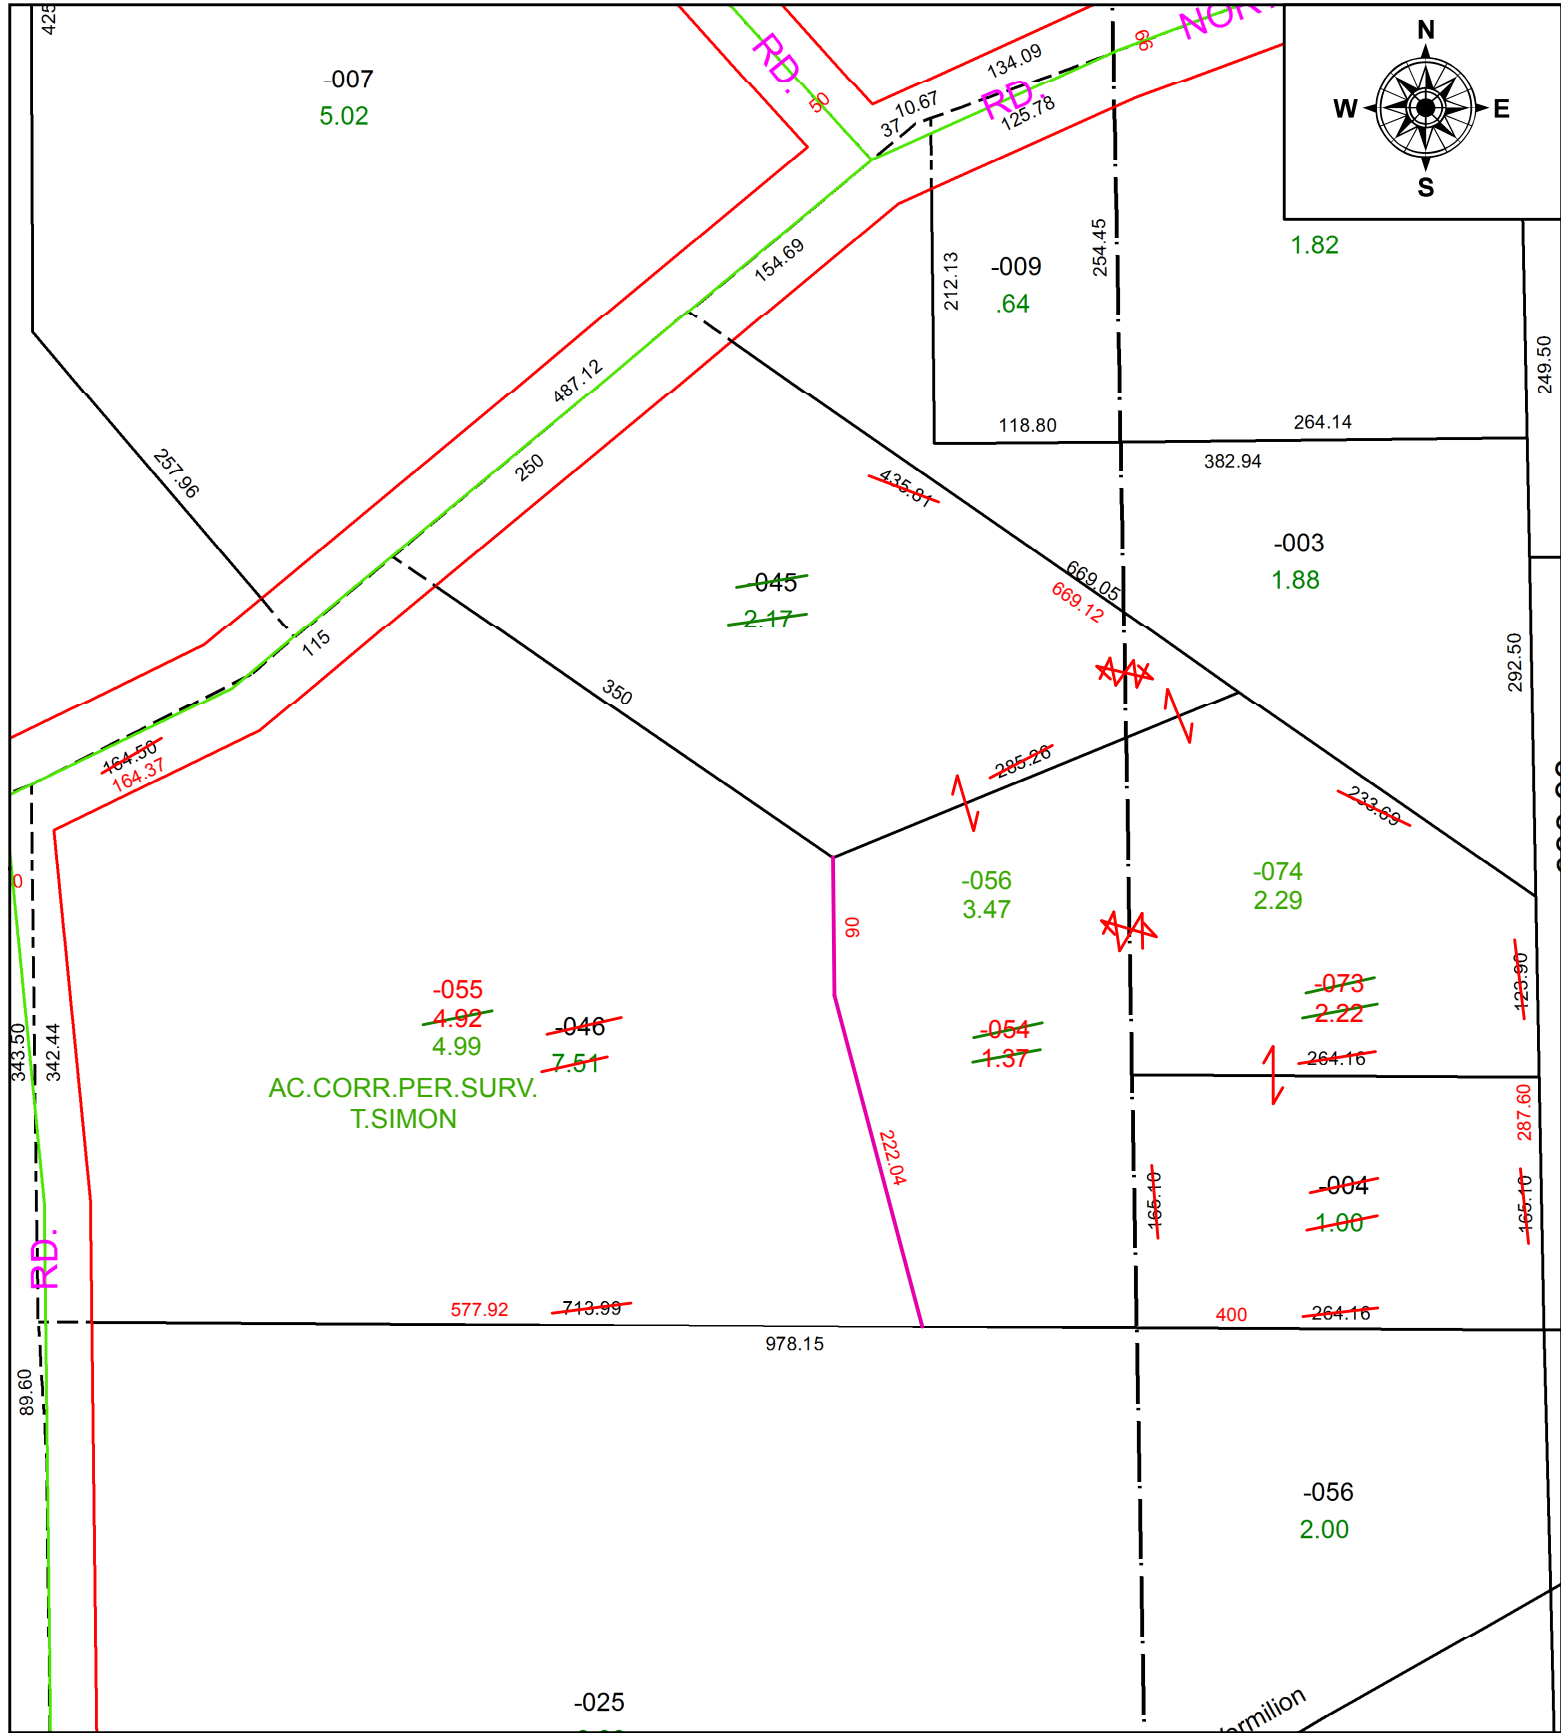

SPLITS/DEEDS PROCESSED
 LORAIN COUNTY TAX MAP DEPARTMENT
 226 MIDDLE AVE. ELYRIA, OH

SURVEYED BY: THOMAS A. SIMON
CLOSURE: 1:323,657
MAP PAGE(S): 1-00-044
APPROVED BY: RRM **DATE:** 10-14-20
SCALE: 1" = 125 **PRIOR INSTRUMENT:** 20200758088