


PARENT PARCEL: 07-00-038-000-039

CHILD PARCEL:

STARTING POINT: INTERSECTION OF C/L OF RACE RD. AND C/L OF SUGAR RIDGE RD.

19-04195-A

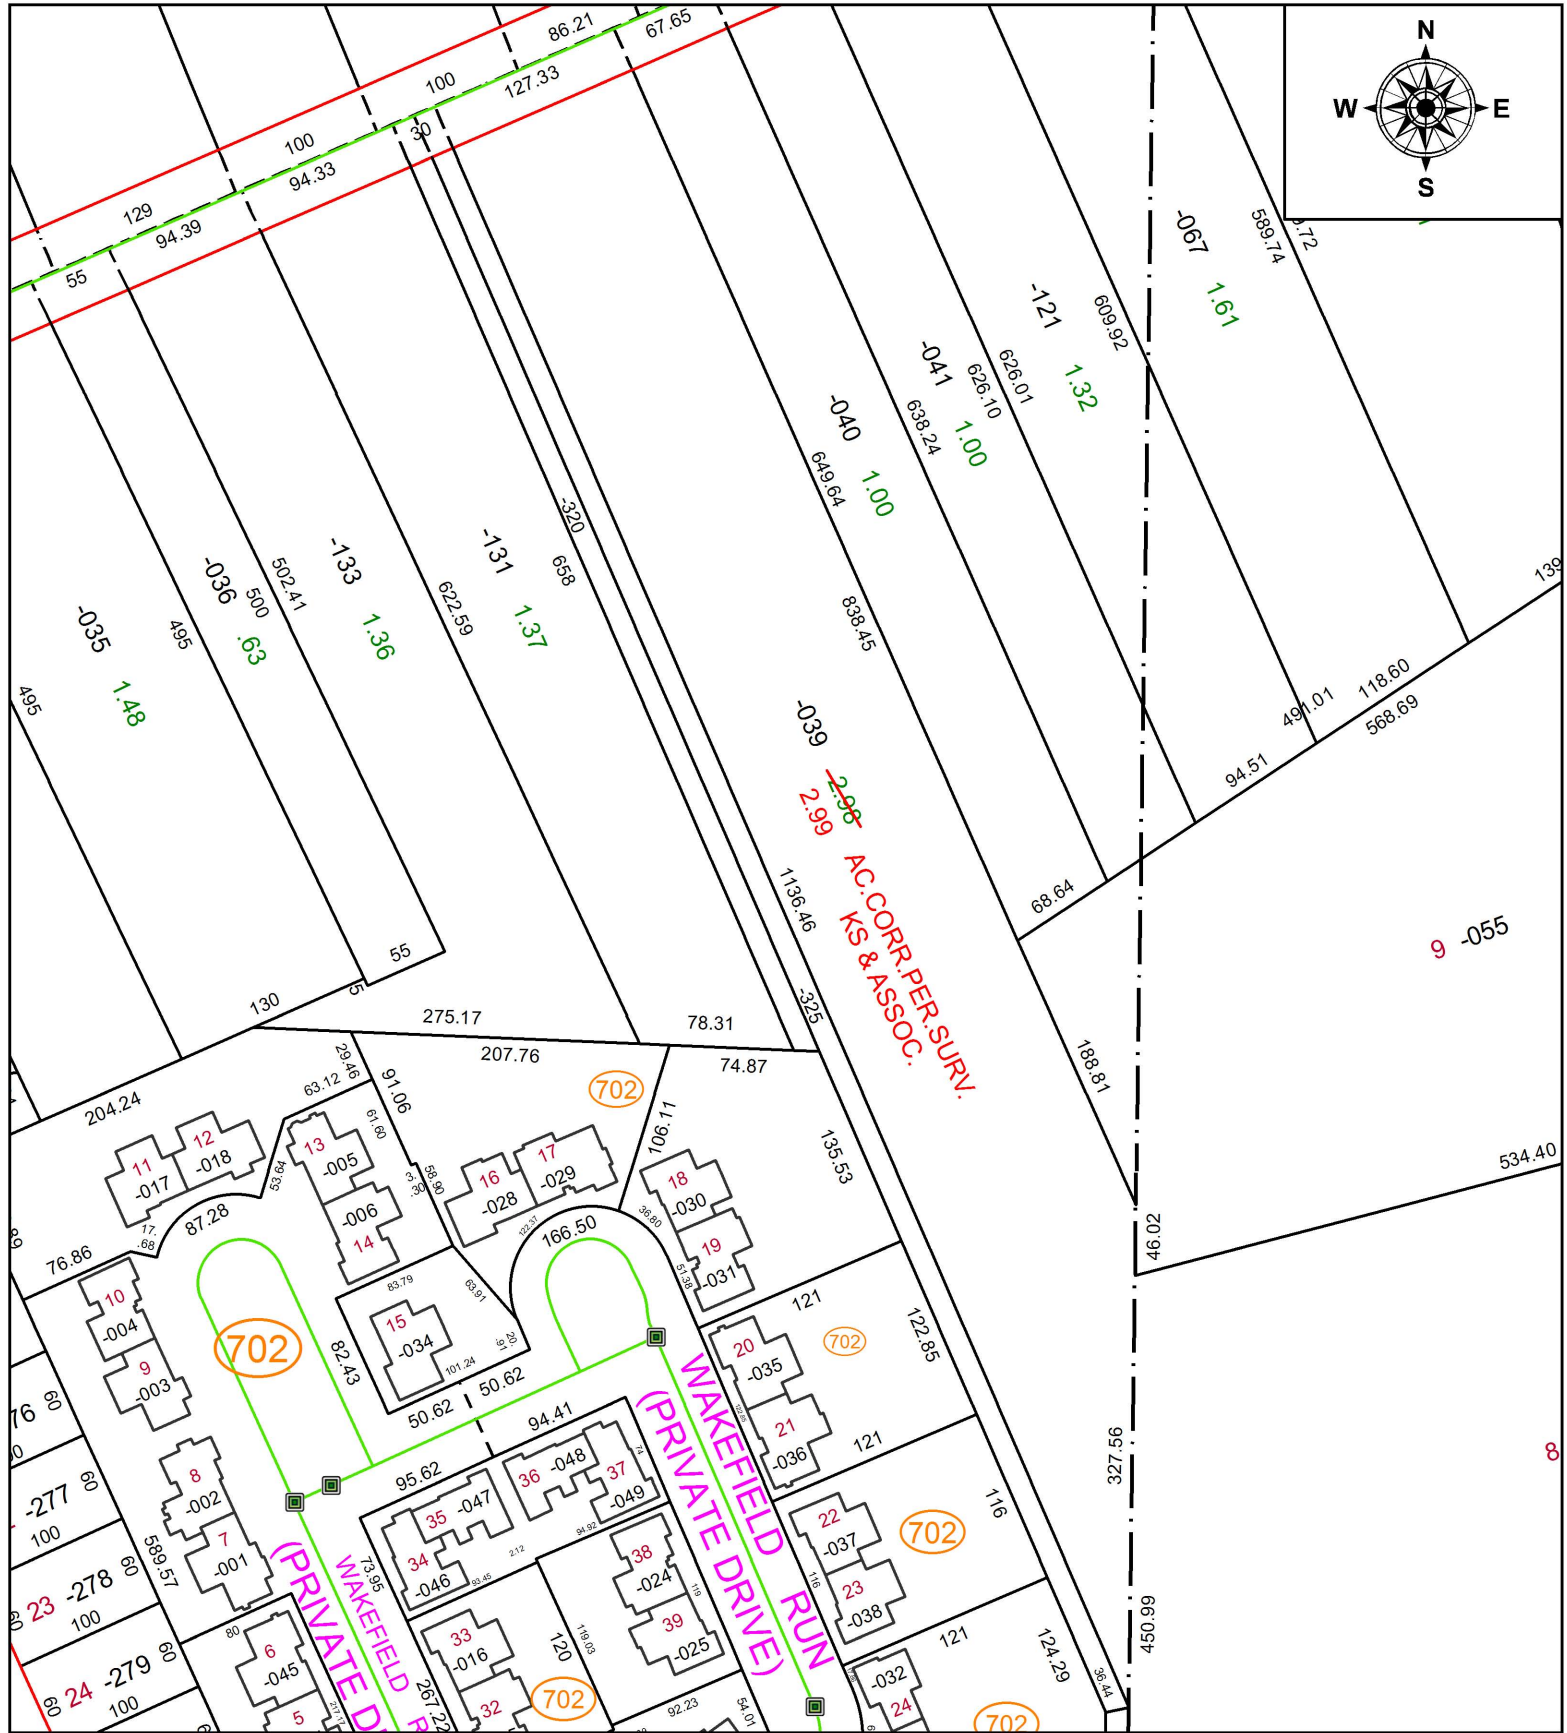

SPLITS/DEEDS PROCESSED

LORAIN COUNTY TAX MAP DEPARTMENT
226 MIDDLE AVE. ELYRIA, OH

SURVEYED BY: KS & ASSOC.

CLOSURE: 1:957,782

MAP PAGE(S): 7-00-038

APPROVED BY: RRM DATE: 9-25-19

SCALE: 1" = 125 PRIOR INSTRUMENT: 2019093069