


PARENT PARCEL: 11-00-093-101-001

CHILD PARCEL:

STARTING POINT: INTERSECTION OF C/L CHESTNUT RIDGE RD. AND C/L OF DEWHURST RD.

19-04203-A

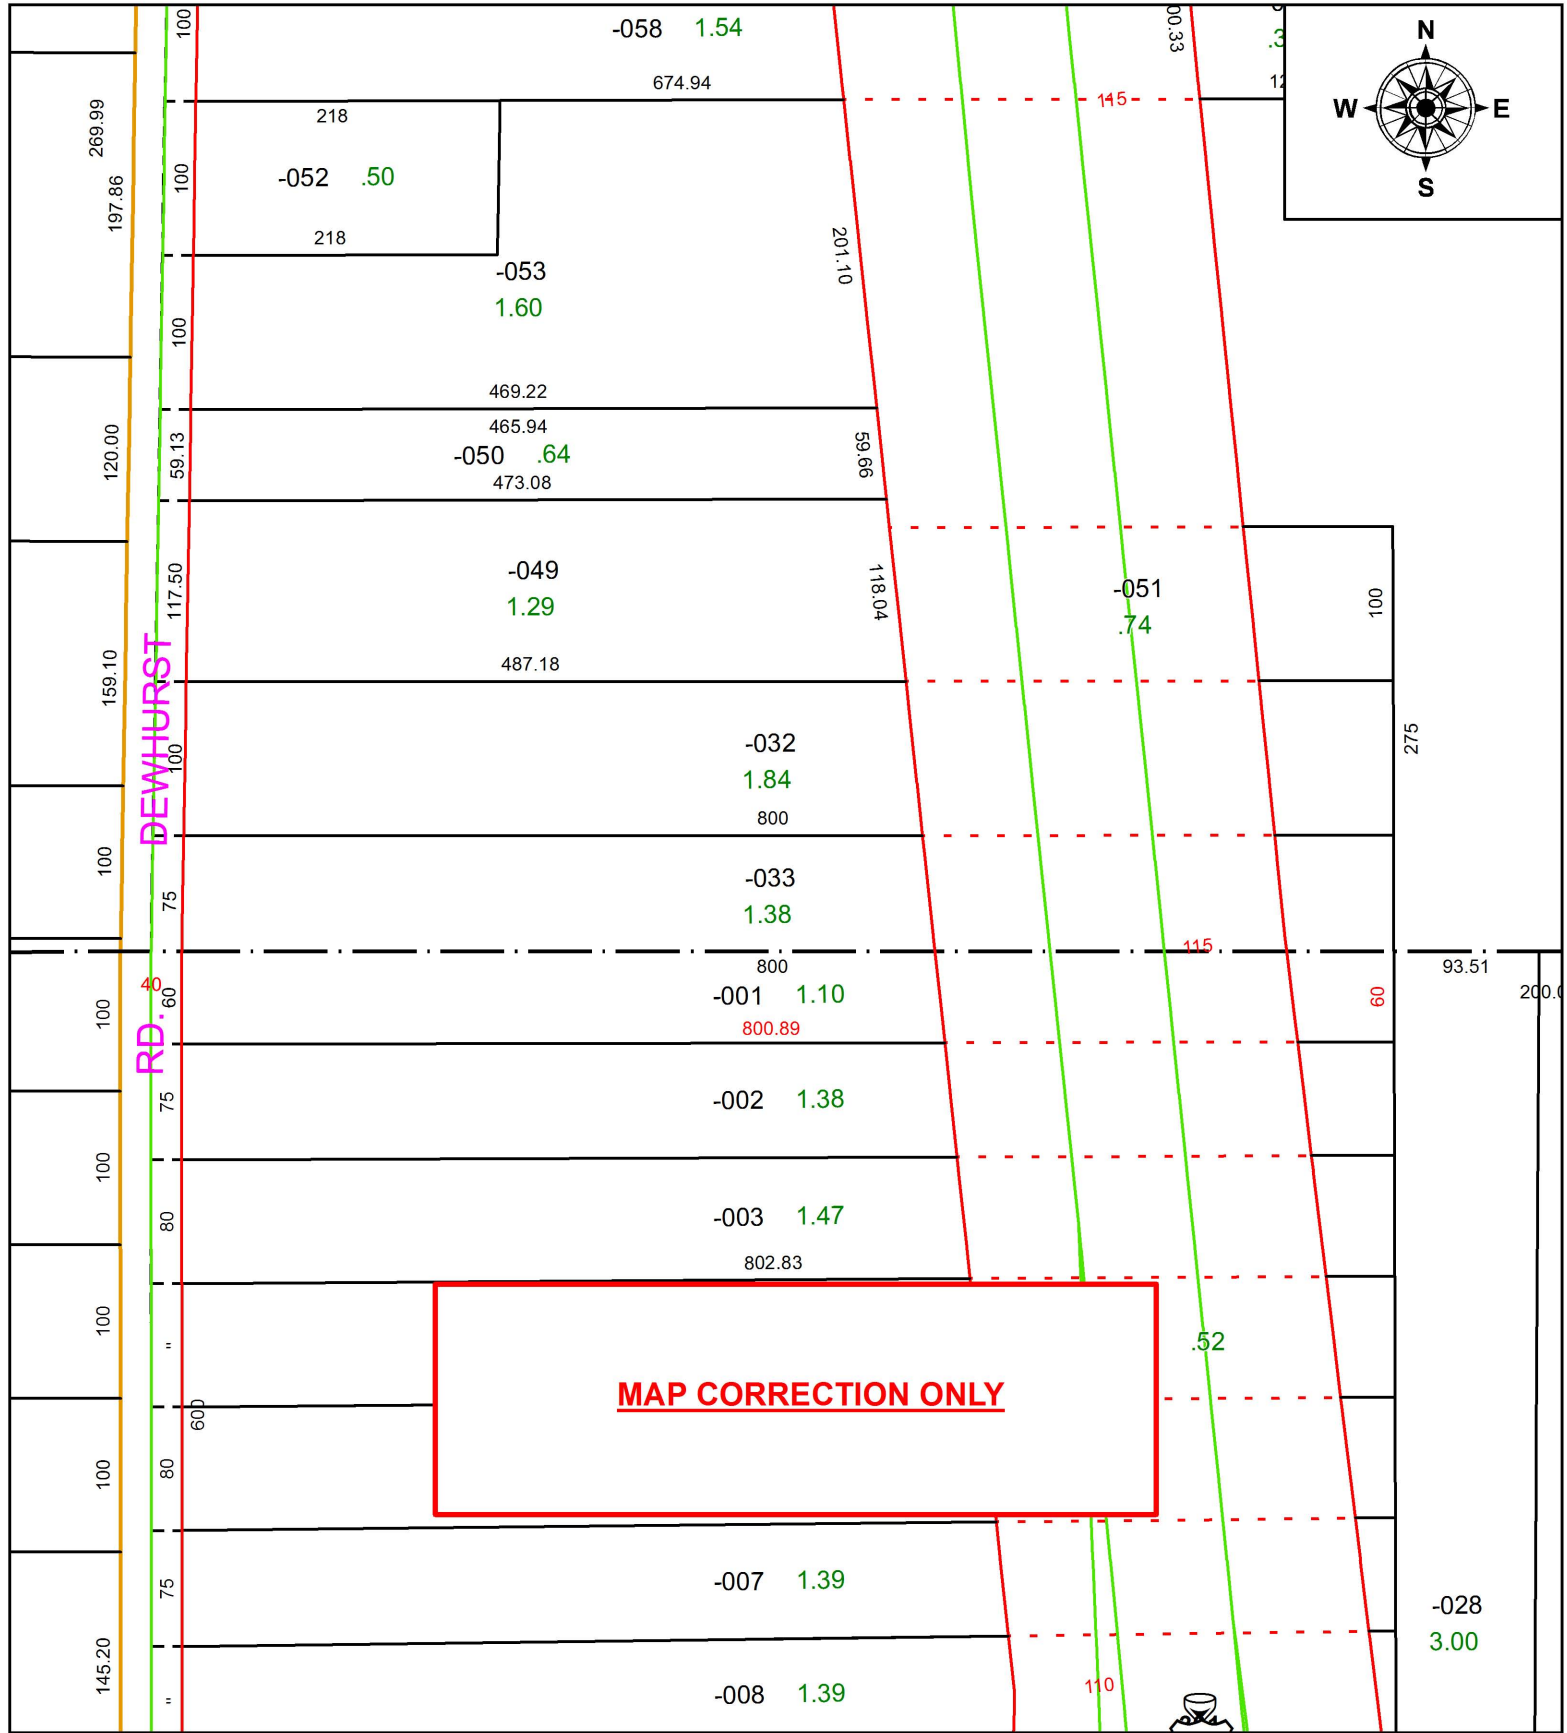

SPLITS/DEEDS PROCESSED
 LORAIN COUNTY TAX MAP DEPARTMENT
 226 MIDDLE AVE. ELYRIA, OH

SURVEYED BY: RICHARD METZKER
 CLOSURE: 1:592,243
 MAP PAGE(S): 11-00-093
 APPROVED BY: RRM DATE: 10-10-19
 SCALE: 1" = 125 PRIOR INSTRUMENT: 20180696258