
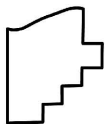


PARENT PARCEL: 10-00-015-112-016

CHILD PARCEL:

STARTING POINT: NORTHWEST CORNER OF S/L 203 IN BRENTWOOD ALLOTMENT NO.5

19-04205-C

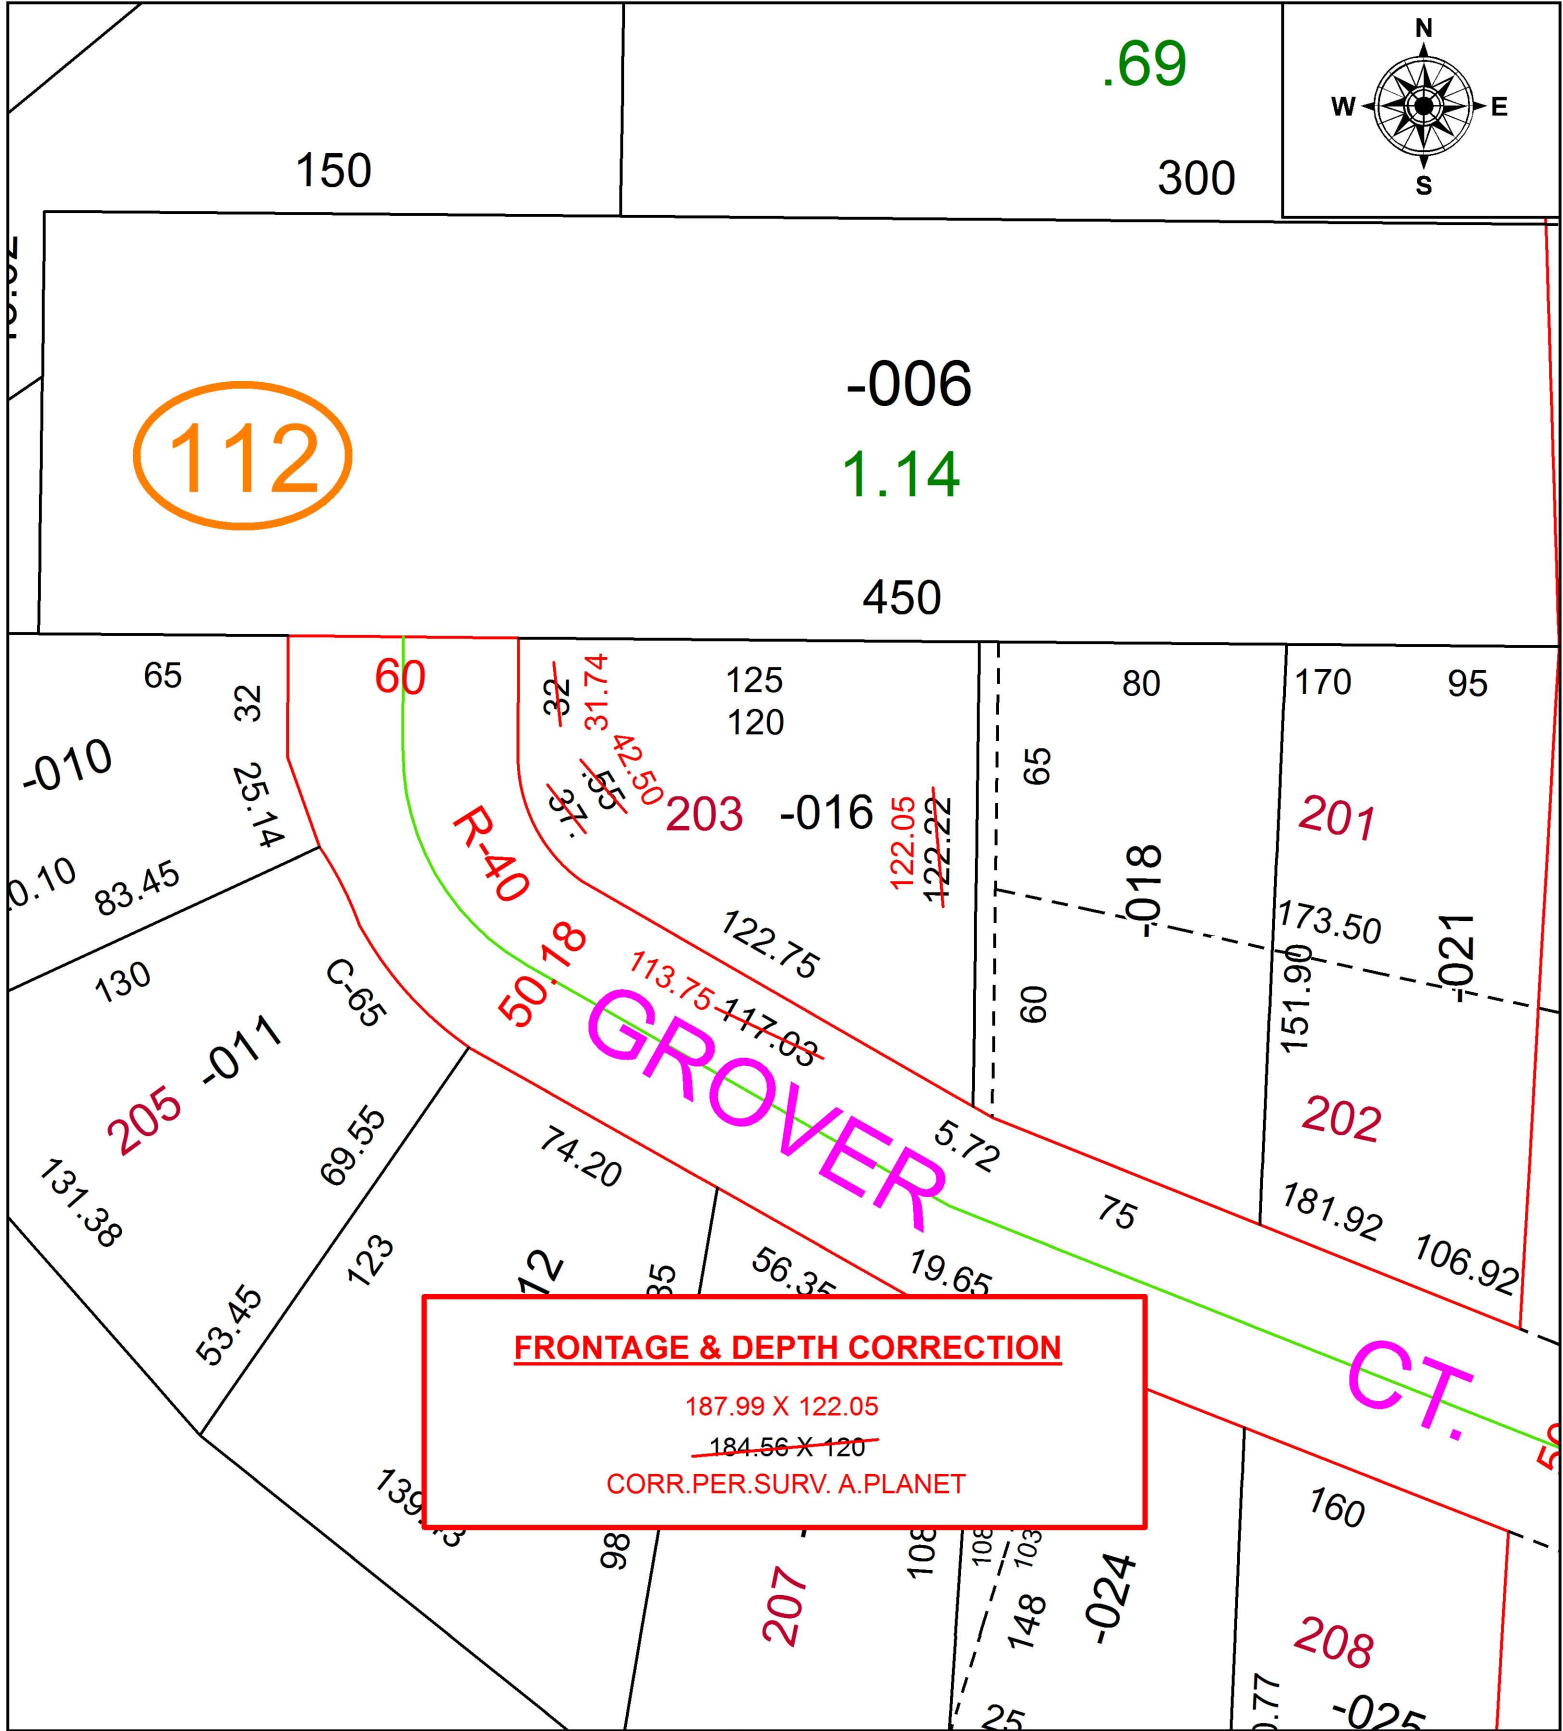

SPLITS/DEEDS PROCESSED
 LORAIN COUNTY TAX MAP DEPARTMENT
 226 MIDDLE AVE. ELYRIA, OH

SURVEYED BY: ANDREW G. PLANET
 CLOSURE: 1:99,700
 MAP PAGE(S): 10-00-015
 APPROVED BY: RRM DATE: 10-16-19
 SCALE: 1" = 50' PRIOR INSTRUMENT: 20130489603