

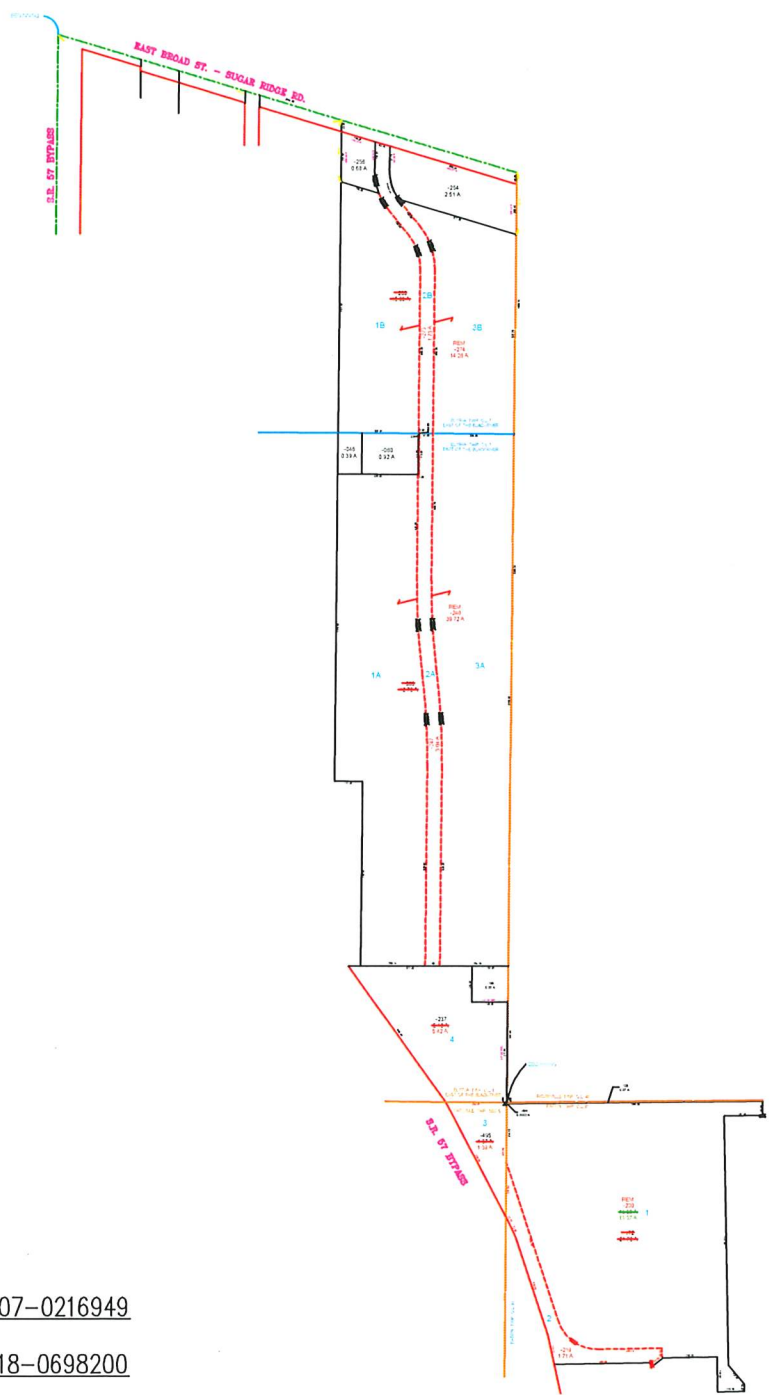


PARENT PARCEL: 06-25-001-000-063, -237, 06-25-007-000-225,
 PARENT PARCEL: 10-00-005-102-495, & 11-00-091-000-172
 CHILD PARCEL: 11-00-091-000-219 & -220, 06-25-001-000-247, -248, & 06-25-007-000-273, -274
 STARTING POINT: N.W. CORNER OF EATON TWP. LOT 91
 STARTING POINT: 1" I.P. MON. BOX, CL OF EAST BROAD ST. & CL OF S.R. 57

20-04206

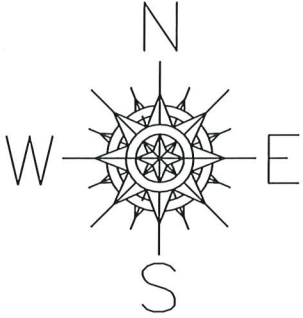

PRIOR INSTRUMENT: 2007-0216949
 PRIOR INSTRUMENT: 2018-0698200

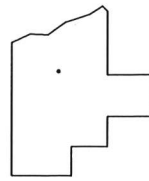

SPLITS/DEEDS PROCESSED

LORAIN COUNTY TAX MAP DEPARTMENT
 226 MIDDLE AVE. ELYRIA, OHIO

SURVEYED BY: I. BIXLER
 CLOSURE: 0.01 : 10,000
 MAP PAGE(S): XX-XX-XXX
 APPROVED BY: TJS DATE: 11/19/2020
 SCALE: 1" = 800