
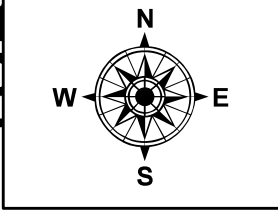


PARENT PARCEL: 04-00-017-112-011

CHILD PARCEL: 04-00-017-112-013, -014

STARTING POINT: S/L'S 130 AND 131 IN AVON CENTER ESTATES NO.2

20-04209

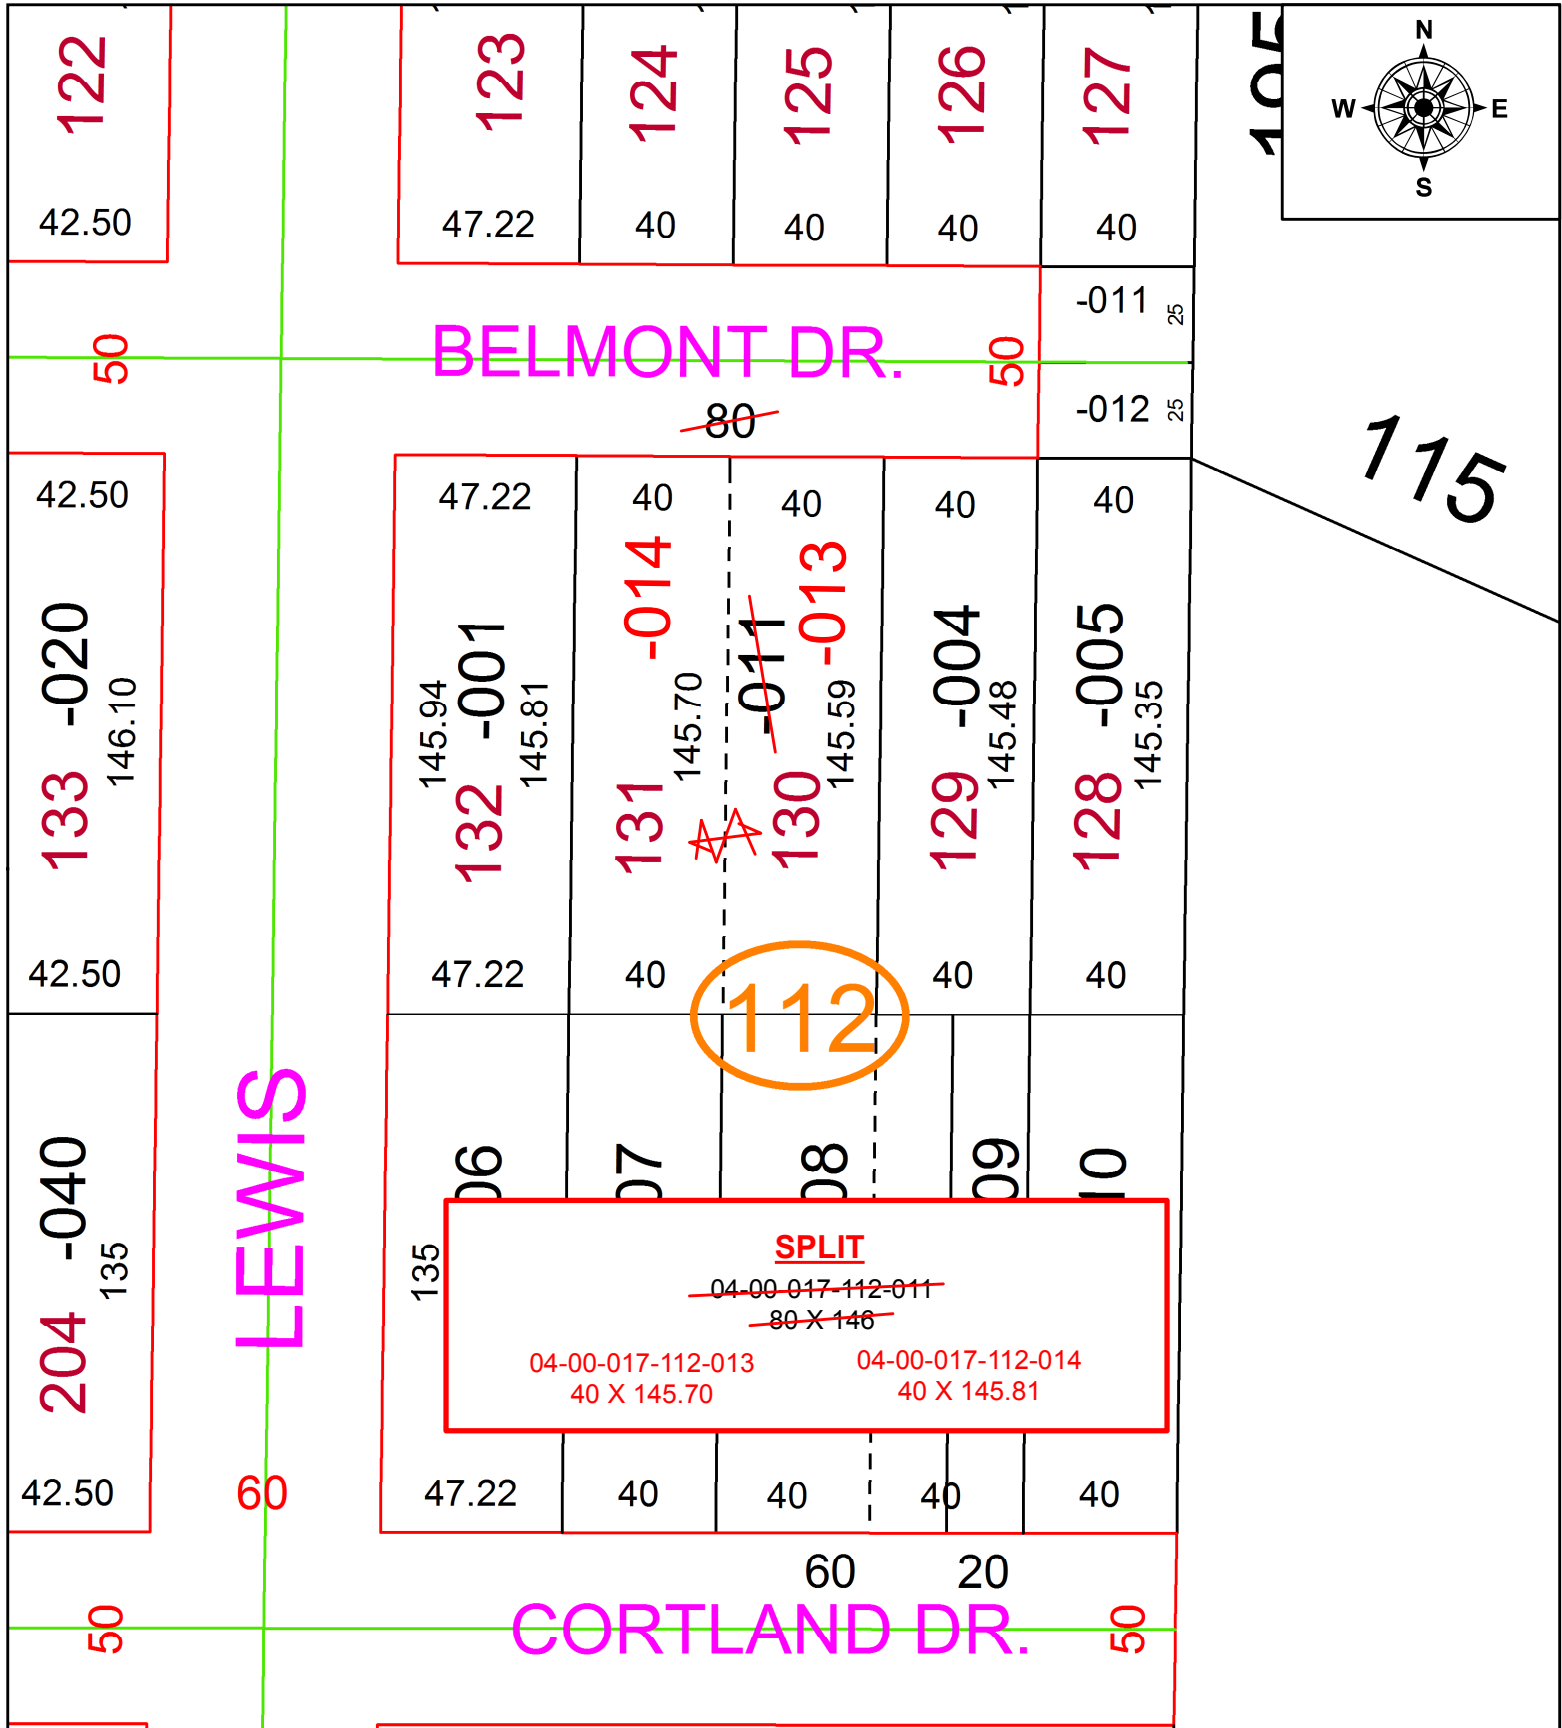


10E

115

SPLIT

~~04-00-017-112-011~~
~~80 X 146~~

04-00-017-112-013 04-00-017-112-014
40 X 145.70 40 X 145.81

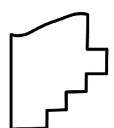

SPLITS/DEEDS PROCESSED
LORAIN COUNTY TAX MAP DEPARTMENT
226 MIDDLE AVE. ELYRIA, OH

SURVEYED BY: WARDEN & LAUNDON
CLOSURE: N/A
MAP PAGE(S): 4-00-017
APPROVED BY: RRM **DATE:** 11-9-20
SCALE: 1" = 50 **PRIOR INSTRUMENT:** 20180657775