


PARENT PARCEL: 06-24-053-102-004

CHILD PARCEL:

STARTING POINT: INTERSECTION OF SOUTH LINE OF FOSTER AVE. AND WEST LINE OF HAYES AVE.

19-04213-D

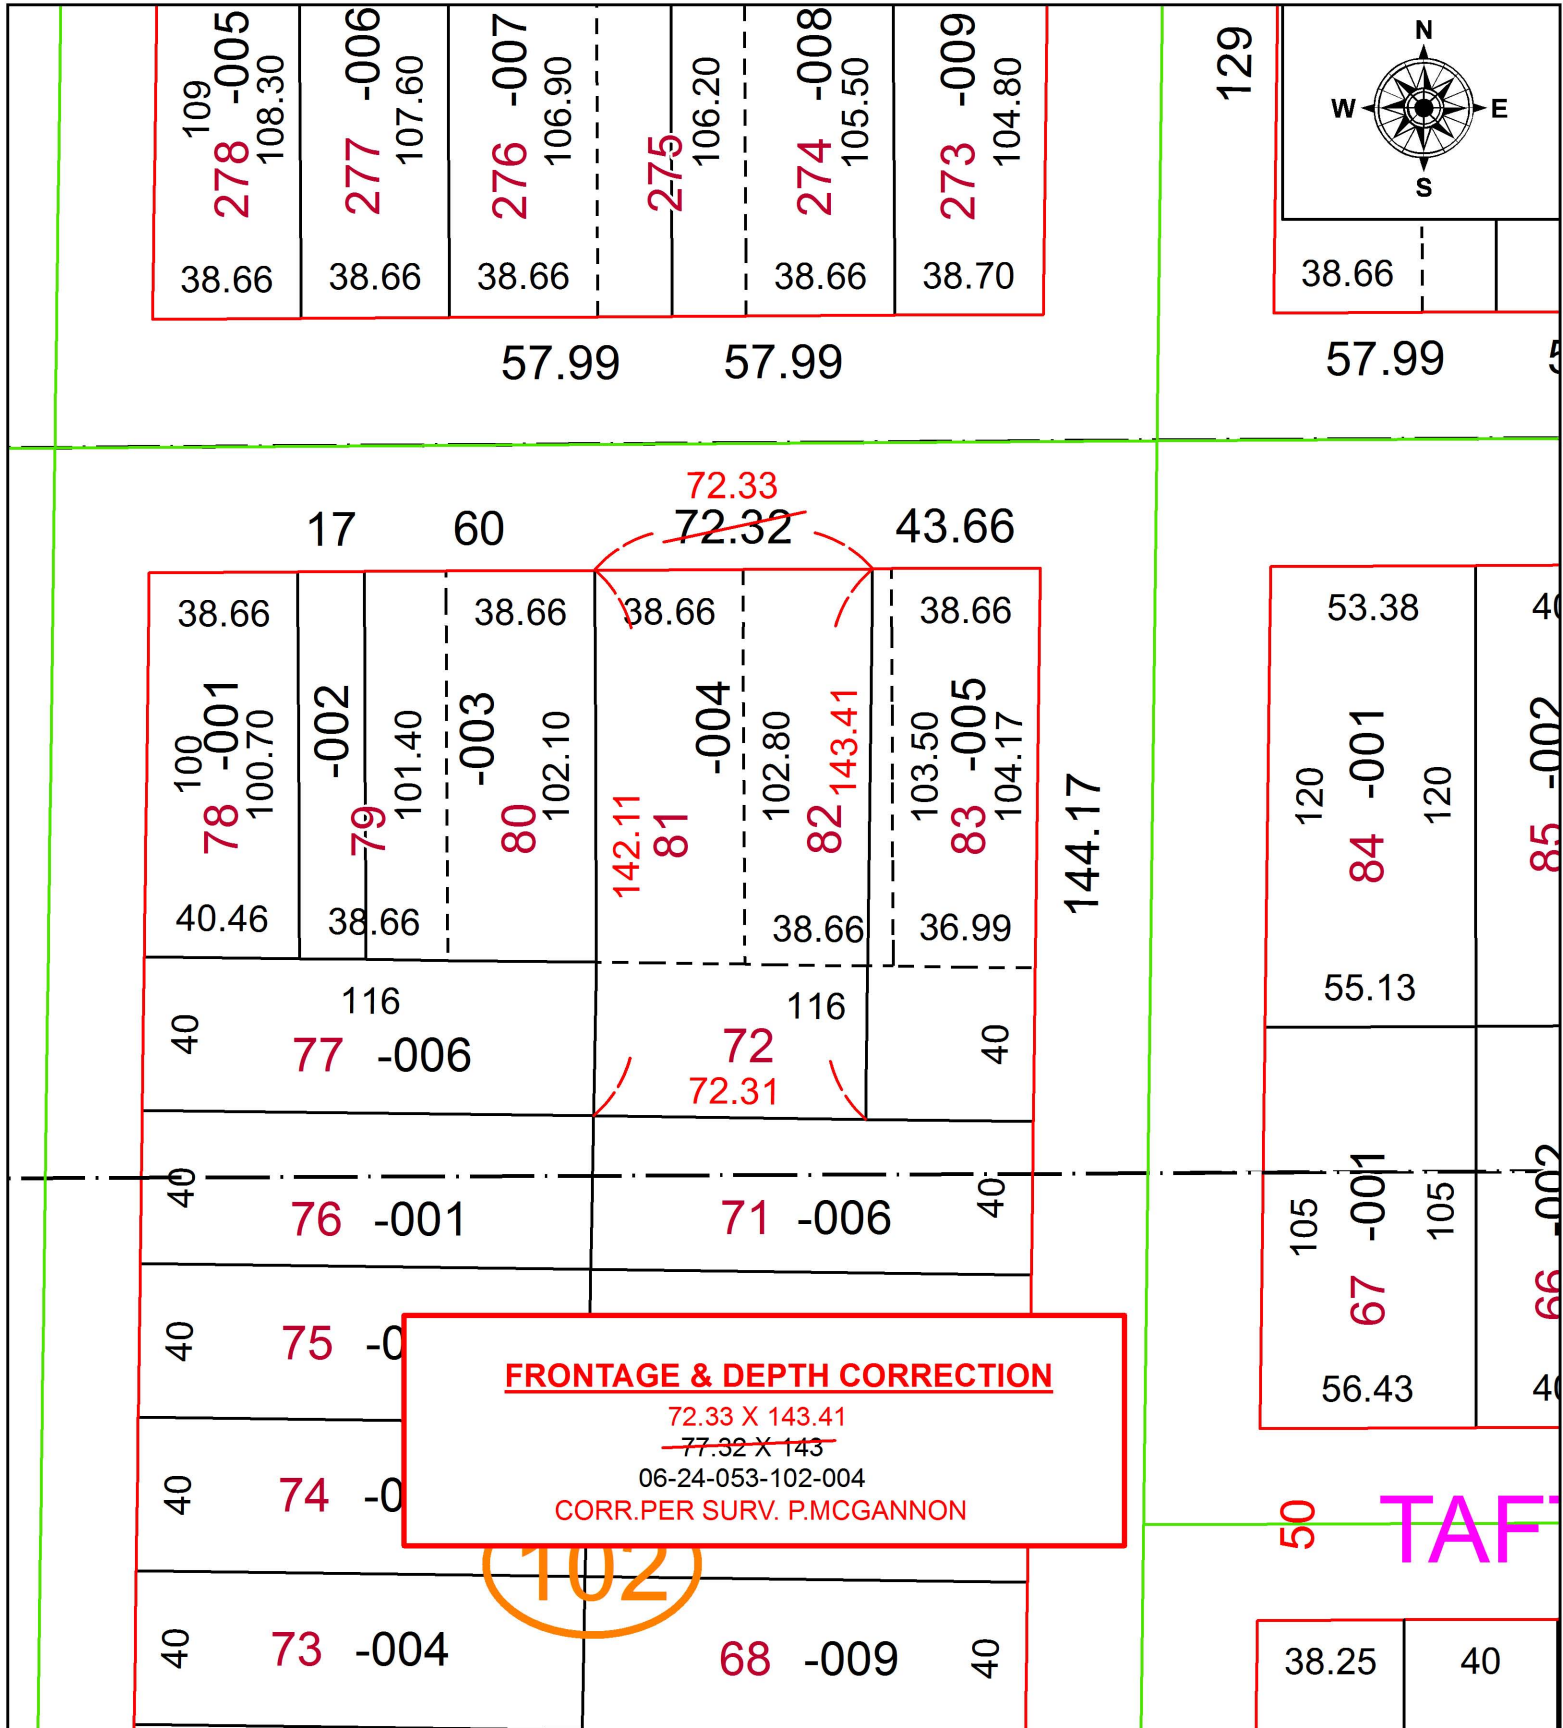

**SPLITS/DEEDS PROCESSED**  
LORAIN COUNTY TAX MAP DEPARTMENT  
226 MIDDLE AVE. ELYRIA, OH

SURVEYED BY: PATRICK A. MCGANNON

CLOSURE: 1:426,297

MAP PAGE(S): 6-24-053

APPROVED BY: RRM DATE: 10-28-19

SCALE: 1" = 50 PRIOR INSTRUMENT: 20190724099