


PARENT PARCEL: 06-22-018-110-032, -034
 CHILD PARCEL: 06-22-018-110-041 THRU -053
 STARTING POINT: S/L'S 70 THRU 79 IN CLEAR VIEW SUB. AND S/L'S 298 THRU 300 IN WILBUR HEIGHTS

19-04220-U

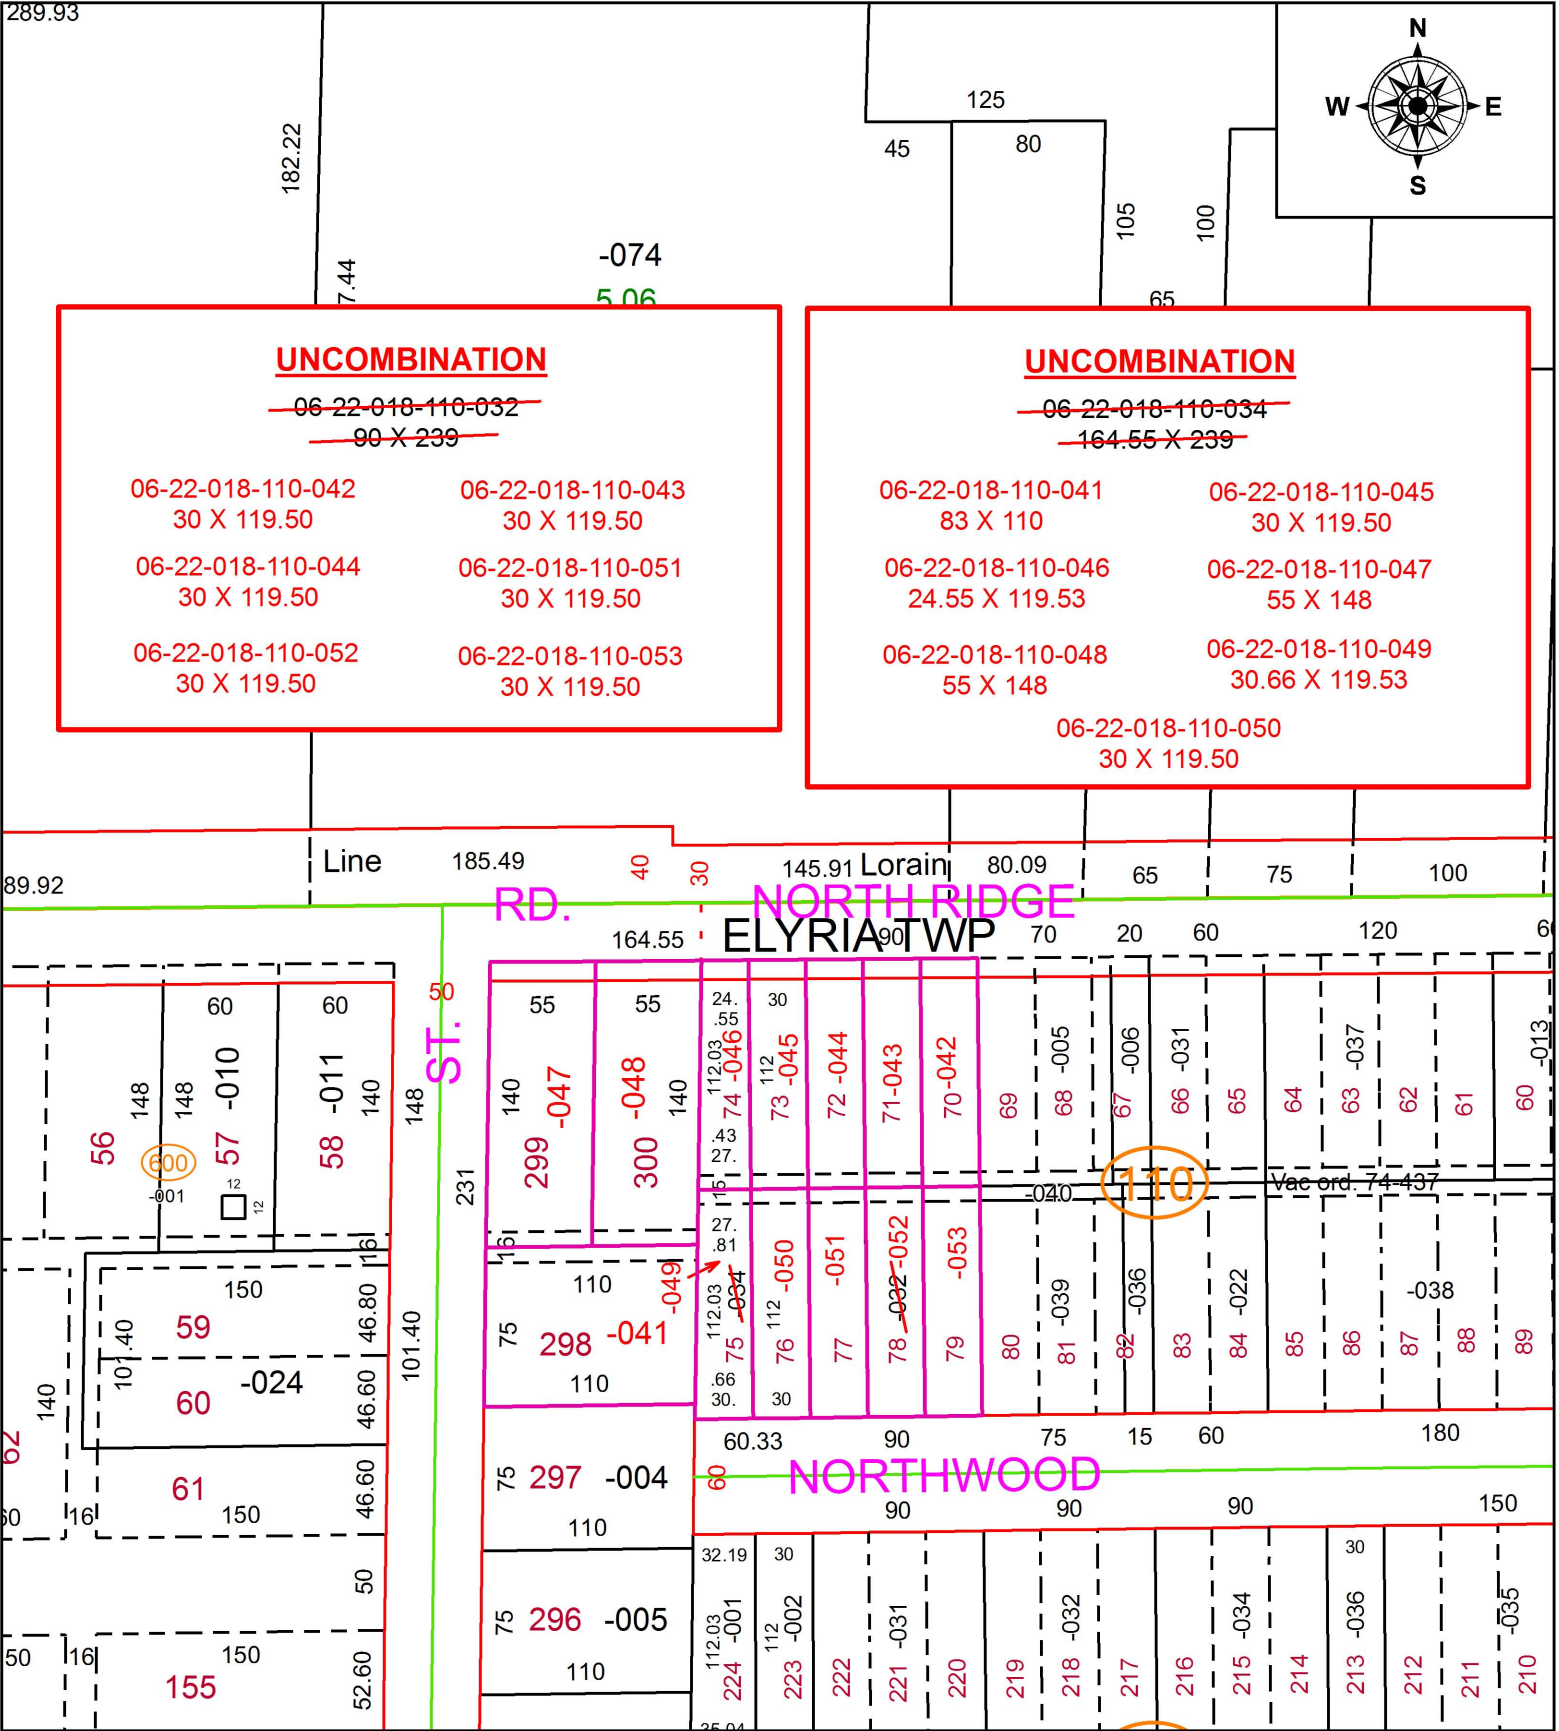

SPLITS/DEEDS PROCESSED
 LORAIN COUNTY TAX MAP DEPARTMENT
 226 MIDDLE AVE. ELYRIA, OH

SURVEYED BY: N/A
 CLOSURE: N/A
 MAP PAGE(S): 6-22-018
 APPROVED BY: RRM DATE: 11-6-19
 SCALE: 1" = 100 PRIOR INSTRUMENT: OR 828/797