
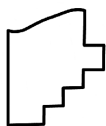


PARENT PARCEL: 01-00-015-000-092

CHILD PARCEL: 01-00-015-000-093, -094

STARTING POINT: SOUTHWEST CORNER OF O.L. 15

20-04220

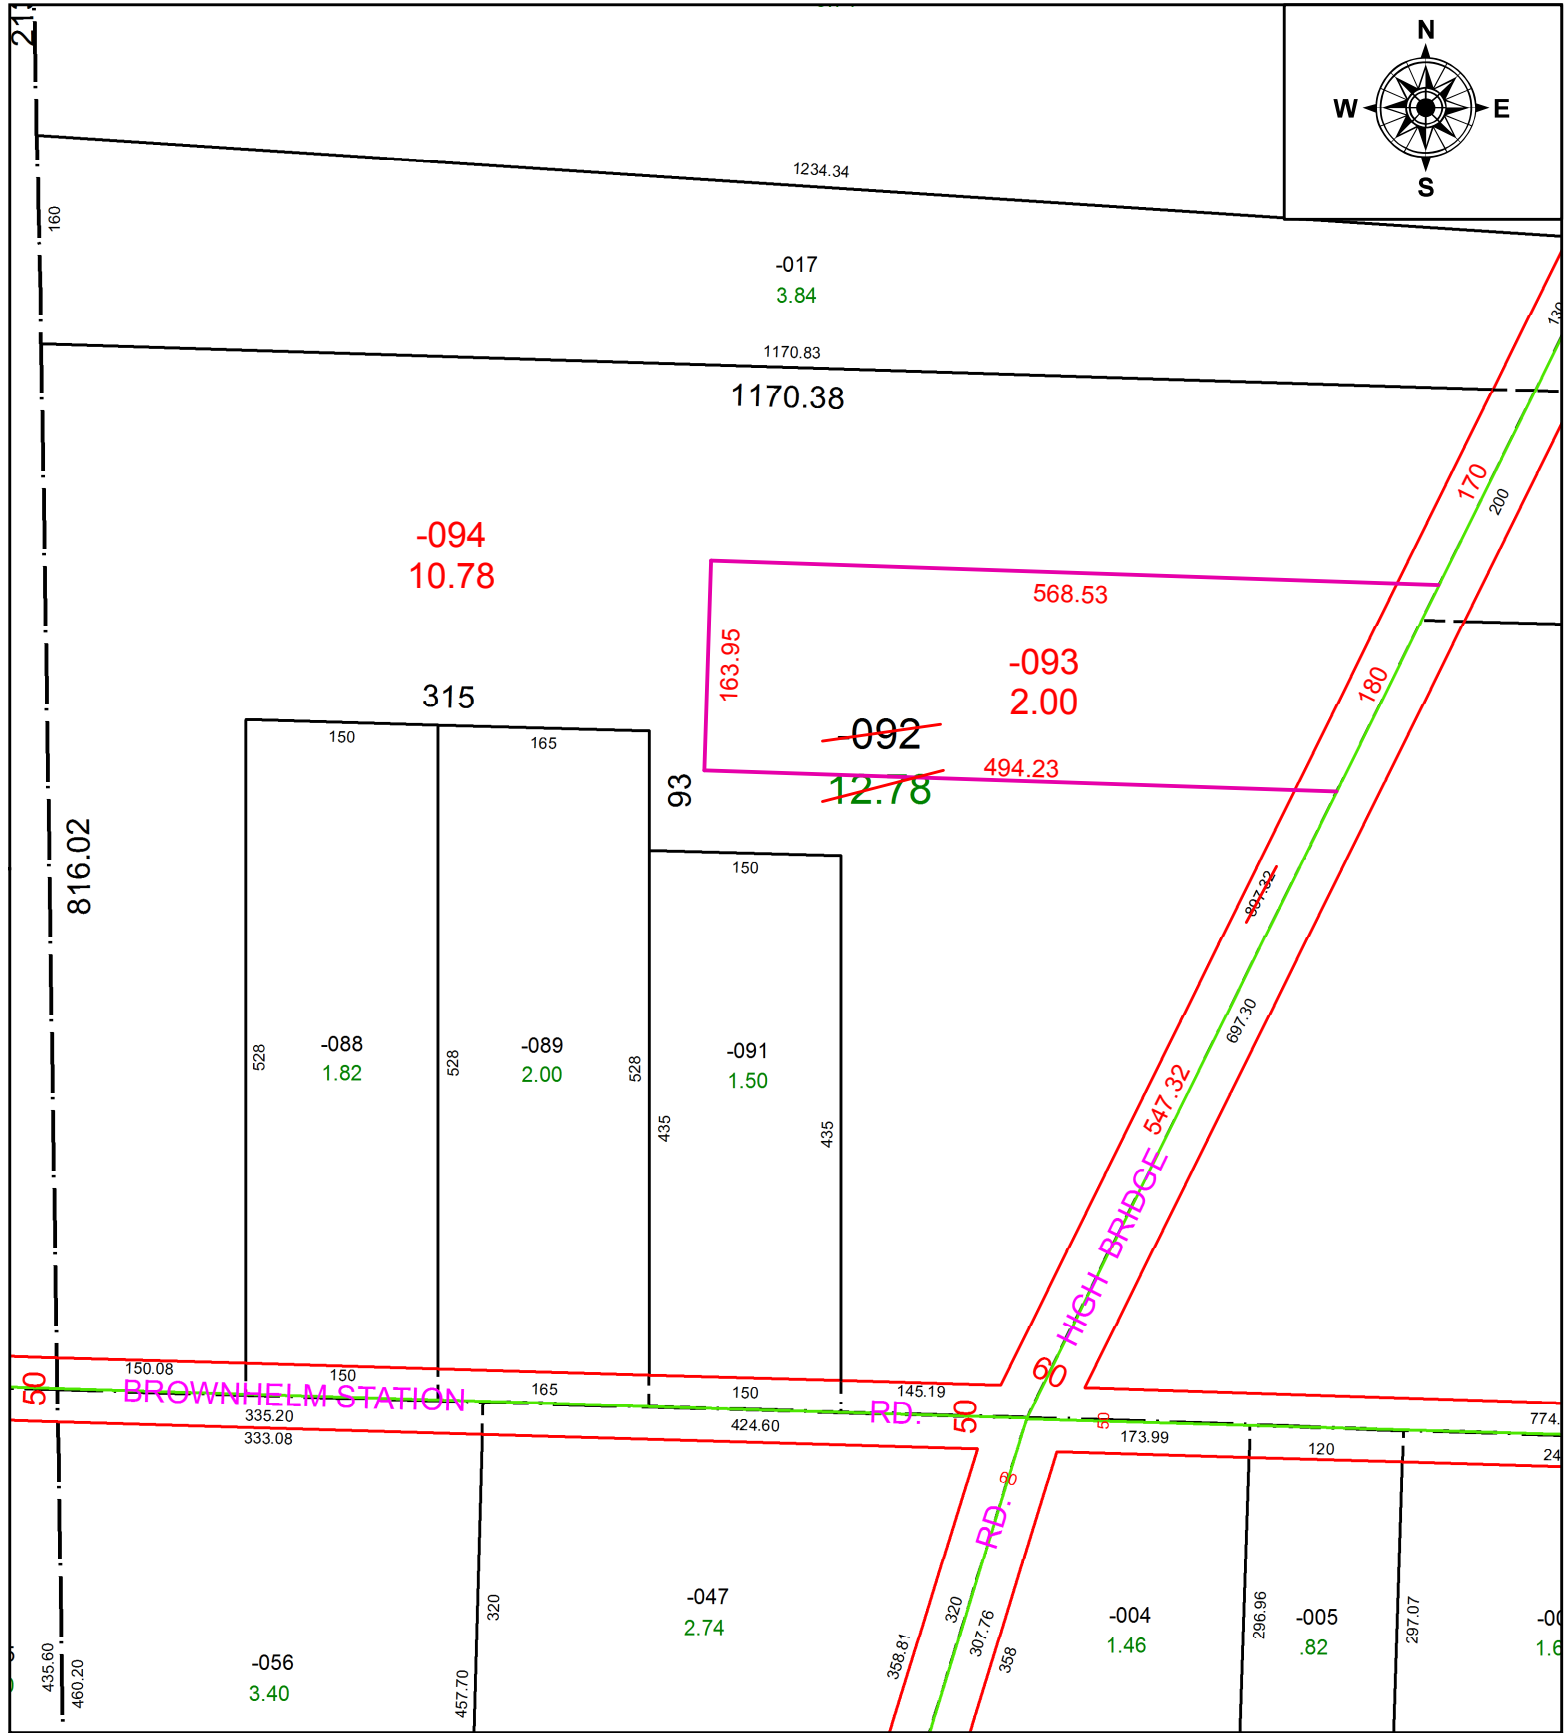

**SPLITS/DEEDS PROCESSED**  
LORAIN COUNTY TAX MAP DEPARTMENT  
226 MIDDLE AVE. ELYRIA, OH

SURVEYED BY: ALEX E. MARKS

CLOSURE: 1:1,723,556

MAP PAGE(S): 1-00-015

APPROVED BY: RRM DATE: 12-3-20

SCALE: 1" = 150 PRIOR INSTRUMENT: 20200761305