


PARENT PARCEL: 02-01-001-108-026

CHILD PARCEL: 02-01-001-108-030, -031

STARTING POINT: INTERSECTION OF C/L OF BASCULE DR. AND C/L OF ARIZONA AVE.

20-04222

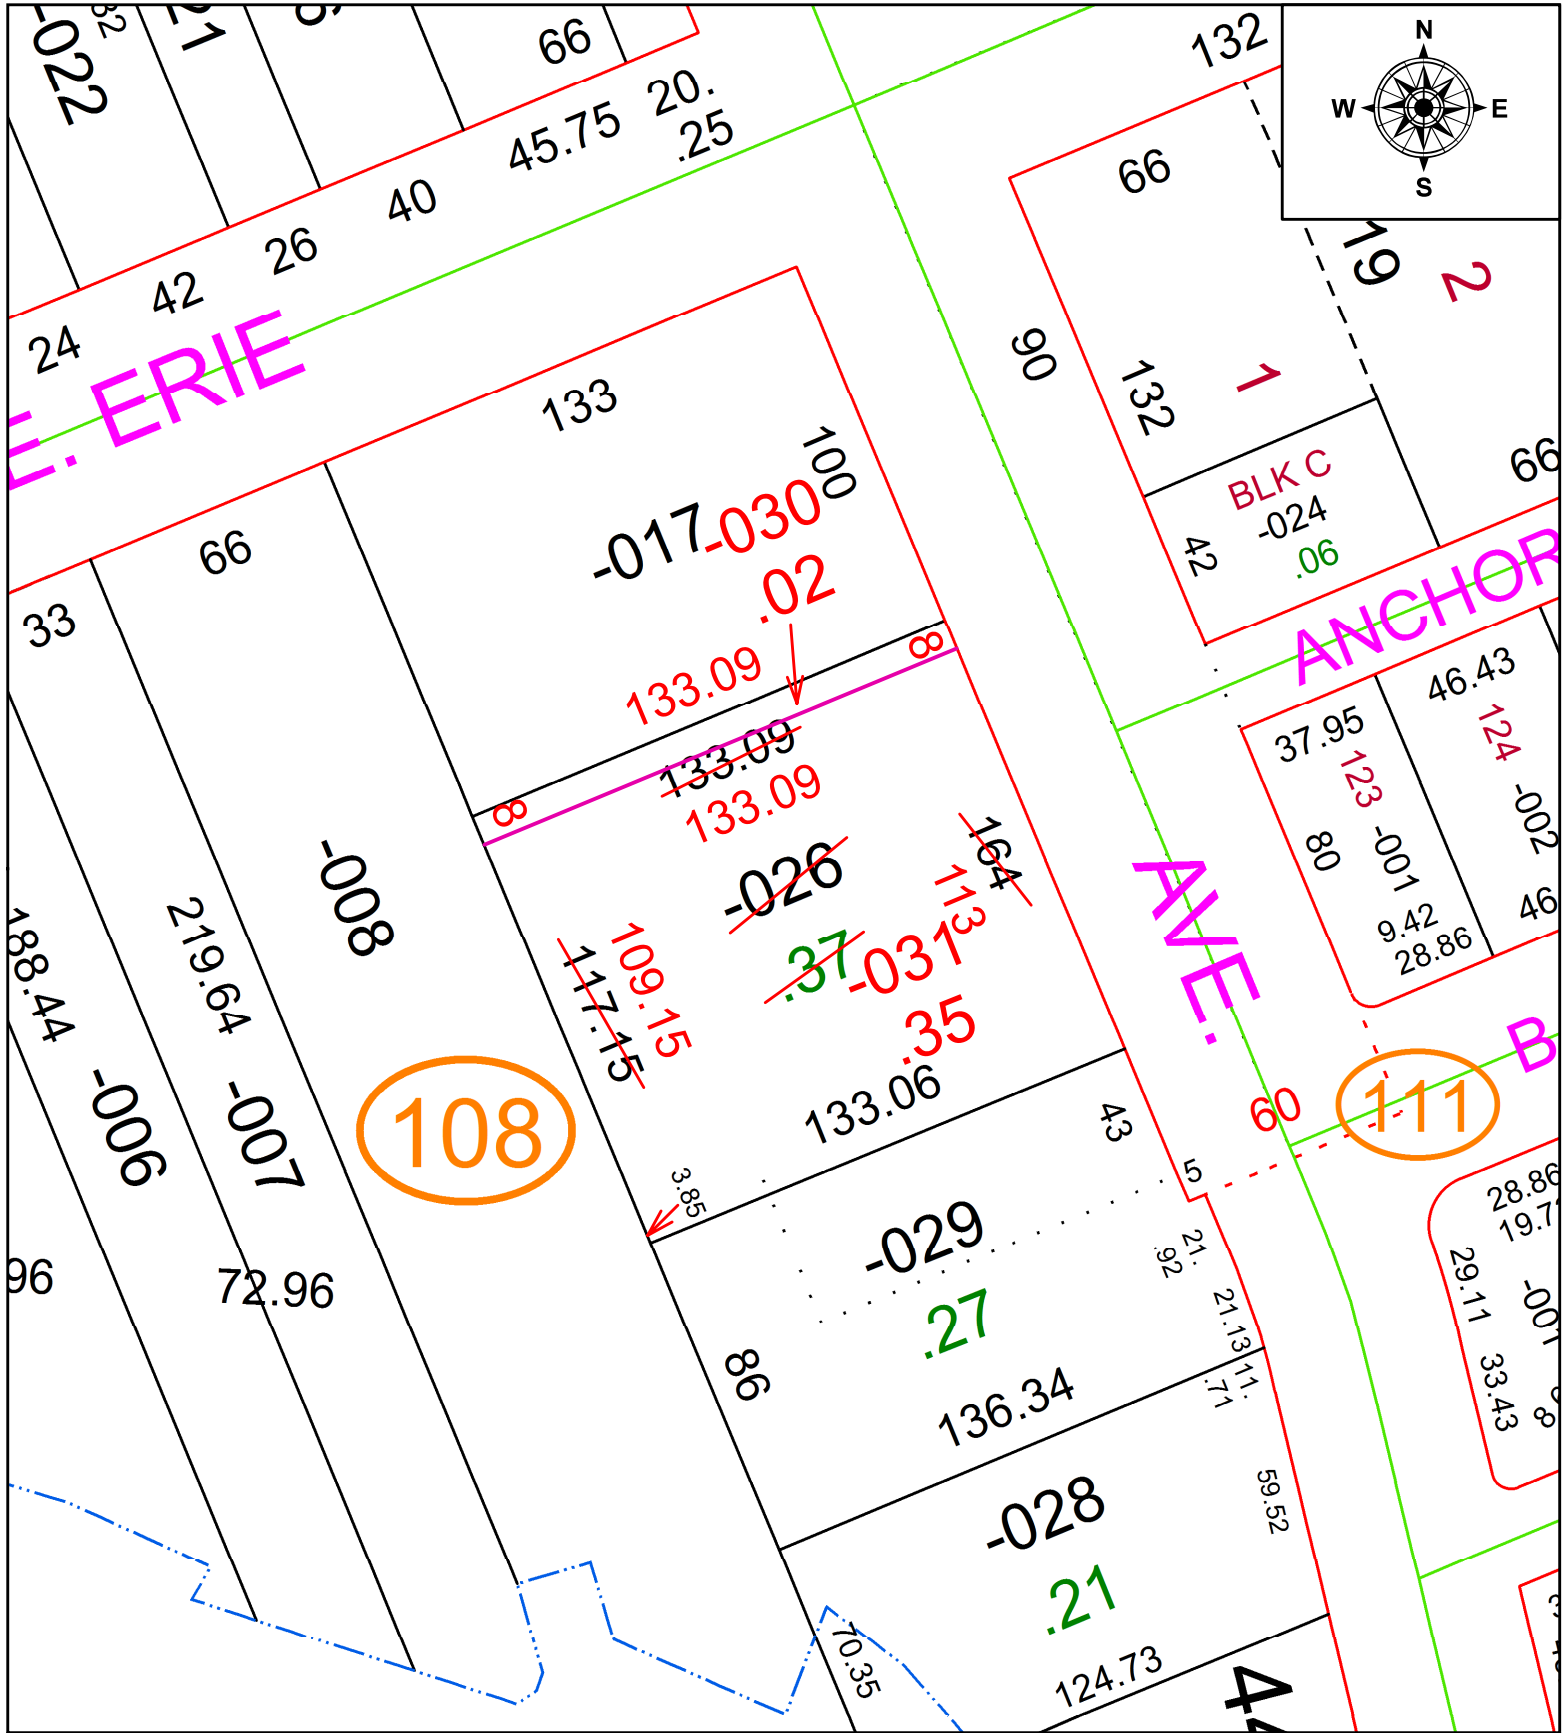

SPLITS/DEEDS PROCESSED
 LORAIN COUNTY TAX MAP DEPARTMENT
 226 MIDDLE AVE. ELYRIA, OH

SURVEYED BY: PATRICK A. MCGANNON
 CLOSURE: 1:43,411
 MAP PAGE(S): 2-01-001
 APPROVED BY: RRM DATE: 12-7-20
 SCALE: 1" = 50 PRIOR INSTRUMENT: 20190709248