


PARENT PARCEL: 04-00-013-000-481, -482, -583

CHILD PARCEL: 04-00-013-000-616 THRU -620


STARTING POINT: INTERSECTION OF C/L OF MILLS RD. AND C/L OF CENTER RD.

20-04232

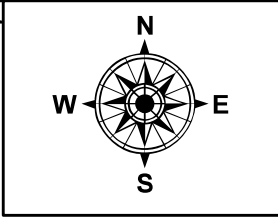

-168
10.56

1835.93

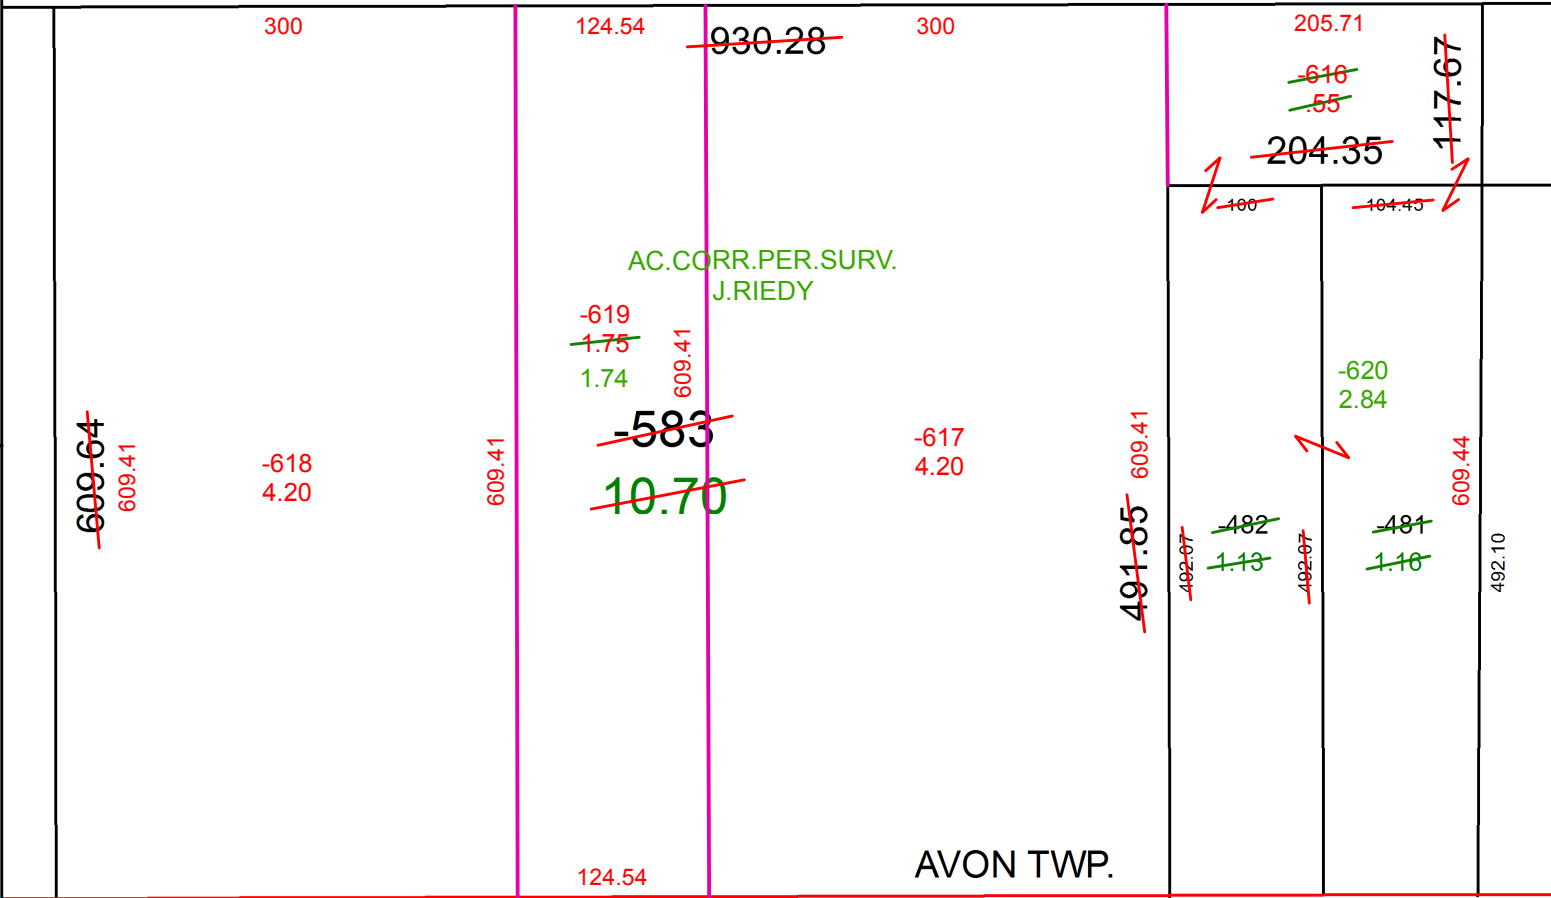


AVON TWP.

RD. Line 300 Avon Mills North Ridgeville 980.28 Corp. 120 200 100

RIDGEVILLE TWP

360						690			
330						330			
55	55	55	55	55	55	55	55	55	55
90	90	90	90	90	90	90	90	90	90
42	41	40	39	38	37	47	48	49	50
141	140	139	138	137	136	184	185	186	187
55	55	55	55	55	55	55	55	55	55
330						330			

(PRIVATE DEED)

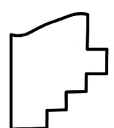

SPLITS/DEEDS PROCESSED
LORAIN COUNTY TAX MAP DEPARTMENT
226 MIDDLE AVE. ELYRIA, OH

SURVEYED BY: JOSHUA S. RIEDY
CLOSURE: 1: 401,517
MAP PAGE(S): 4-00-013
APPROVED BY: RRM DATE: 1-7-21
SCALE: 1" = 125 PRIOR INSTRUMENT: 20170620506