


PARENT PARCEL: 15-00-099-103-080, -081

CHILD PARCEL: 15-00-099-103-081, -181, -182

STARTING POINT: NORTHWEST CORNER OF S/L 60 IN PHEASANT RUN VILLAGE PH.1

21-04234

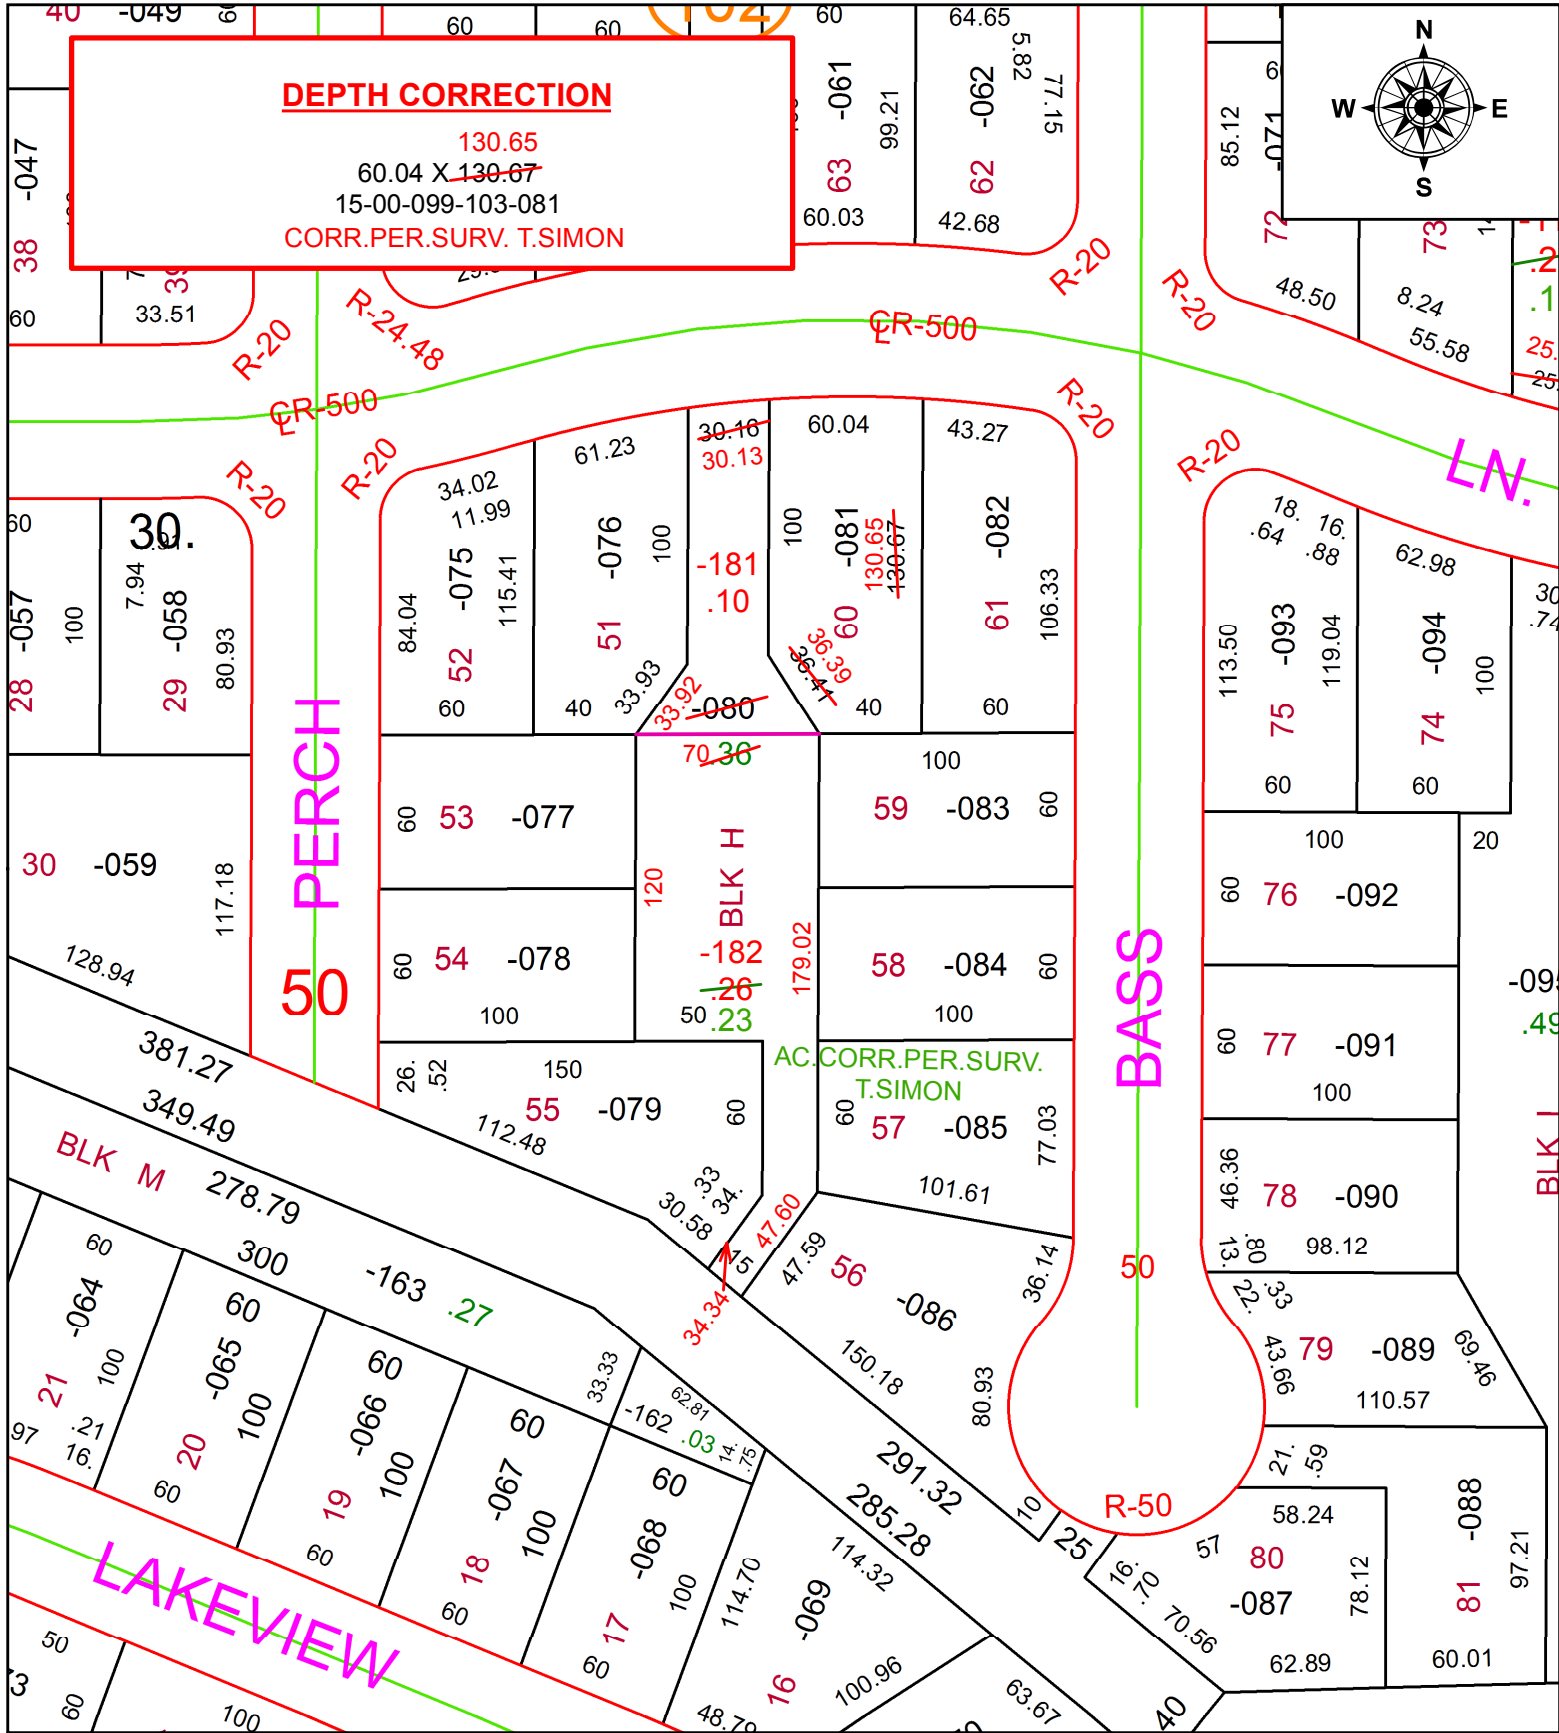

SPLITS/DEEDS PROCESSED
 LORAIN COUNTY TAX MAP DEPARTMENT
 226 MIDDLE AVE. ELYRIA, OH

SURVEYED BY: THOMAS A. SIMON
CLOSURE: 1: 76,067
MAP PAGE(S): 15-00-099
APPROVED BY: RRM **DATE:** 1-7-21
SCALE: 1" = 75 **PRIOR INSTRUMENT:** 20200745246