

PARENT PARCEL: 01-00-004-710-015 & -016

CHILD PARCEL: CERTIFICATE OF CORRECTION - UNIT NUMBER CHANGE & TIE-IN CORRECTION

STARTING POINT: VERMILION SHORES CONDO. NO. 2 PH. 3 PV. 107 PG. 52-55

19-04238-C

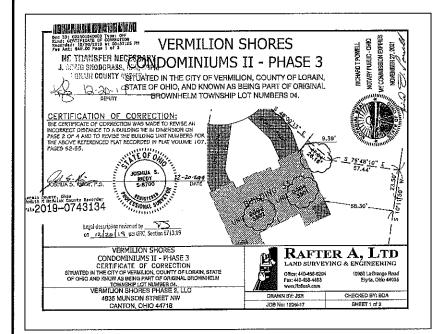

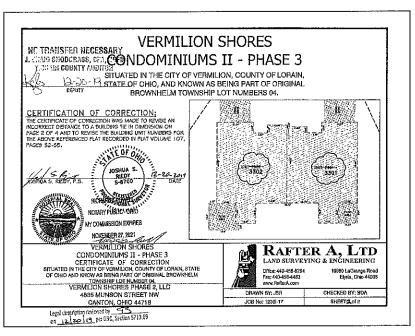

AFFIDAVIT of Facts Relating to Title (\$301,252 O.R.C.)

STATE OF OHIO

COUNTY OF LORAIN

BEFORE ME, u Notary Public in for said County and State, have Joshua S. Rikdy, P.S. who acknowledged that he did sign two separate CERTIFICATION OF CORRECTION, Page 1 of 2 and Page 2 of 2 and that the same is his free not and deed.

IN TESTIMONY WHEREOF, I have hereunto subscribed my name and affixed my official seal at $\frac{\sqrt{5} \sqrt{y} r^3 \kappa}{20}$. Ohio, this $\frac{20^{15}}{100}$ day of December, 2019.

tina J. Pavell

RICHARD T POWELL

NOTARY PUBLIC - CHBO

MY COMMISSION EXPIRES

NOVEMBER 27, 2021

JOSHUA S RIEUY PS 700 OBERLIN ELYRIA RE

SPLITS/DEEDS PROCESSED

LORAIN COUNTY TAX MAP DEPARTMENT 226 MIDDLE AVE. ELYRIA, OHIO

SURVEYED BY: JOSHUA RIEDY
CLOSURE: NA
MAP PAGE(S): 01-00-004
APPROVED BY: TJS DATE: 12/20/19
SCALE: 1"= 100 PRIOR INST.: DV XXXX/XXX