

PARENT PARCEL:

ADD TO DUP.



CHILD PARCEL:

03-00-033-107-070

STARTING POINT:

INTERSECTION OF C/L OF ABBE RD. AND C/L OF HAWTHORNE AVE.

20-04240-V

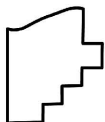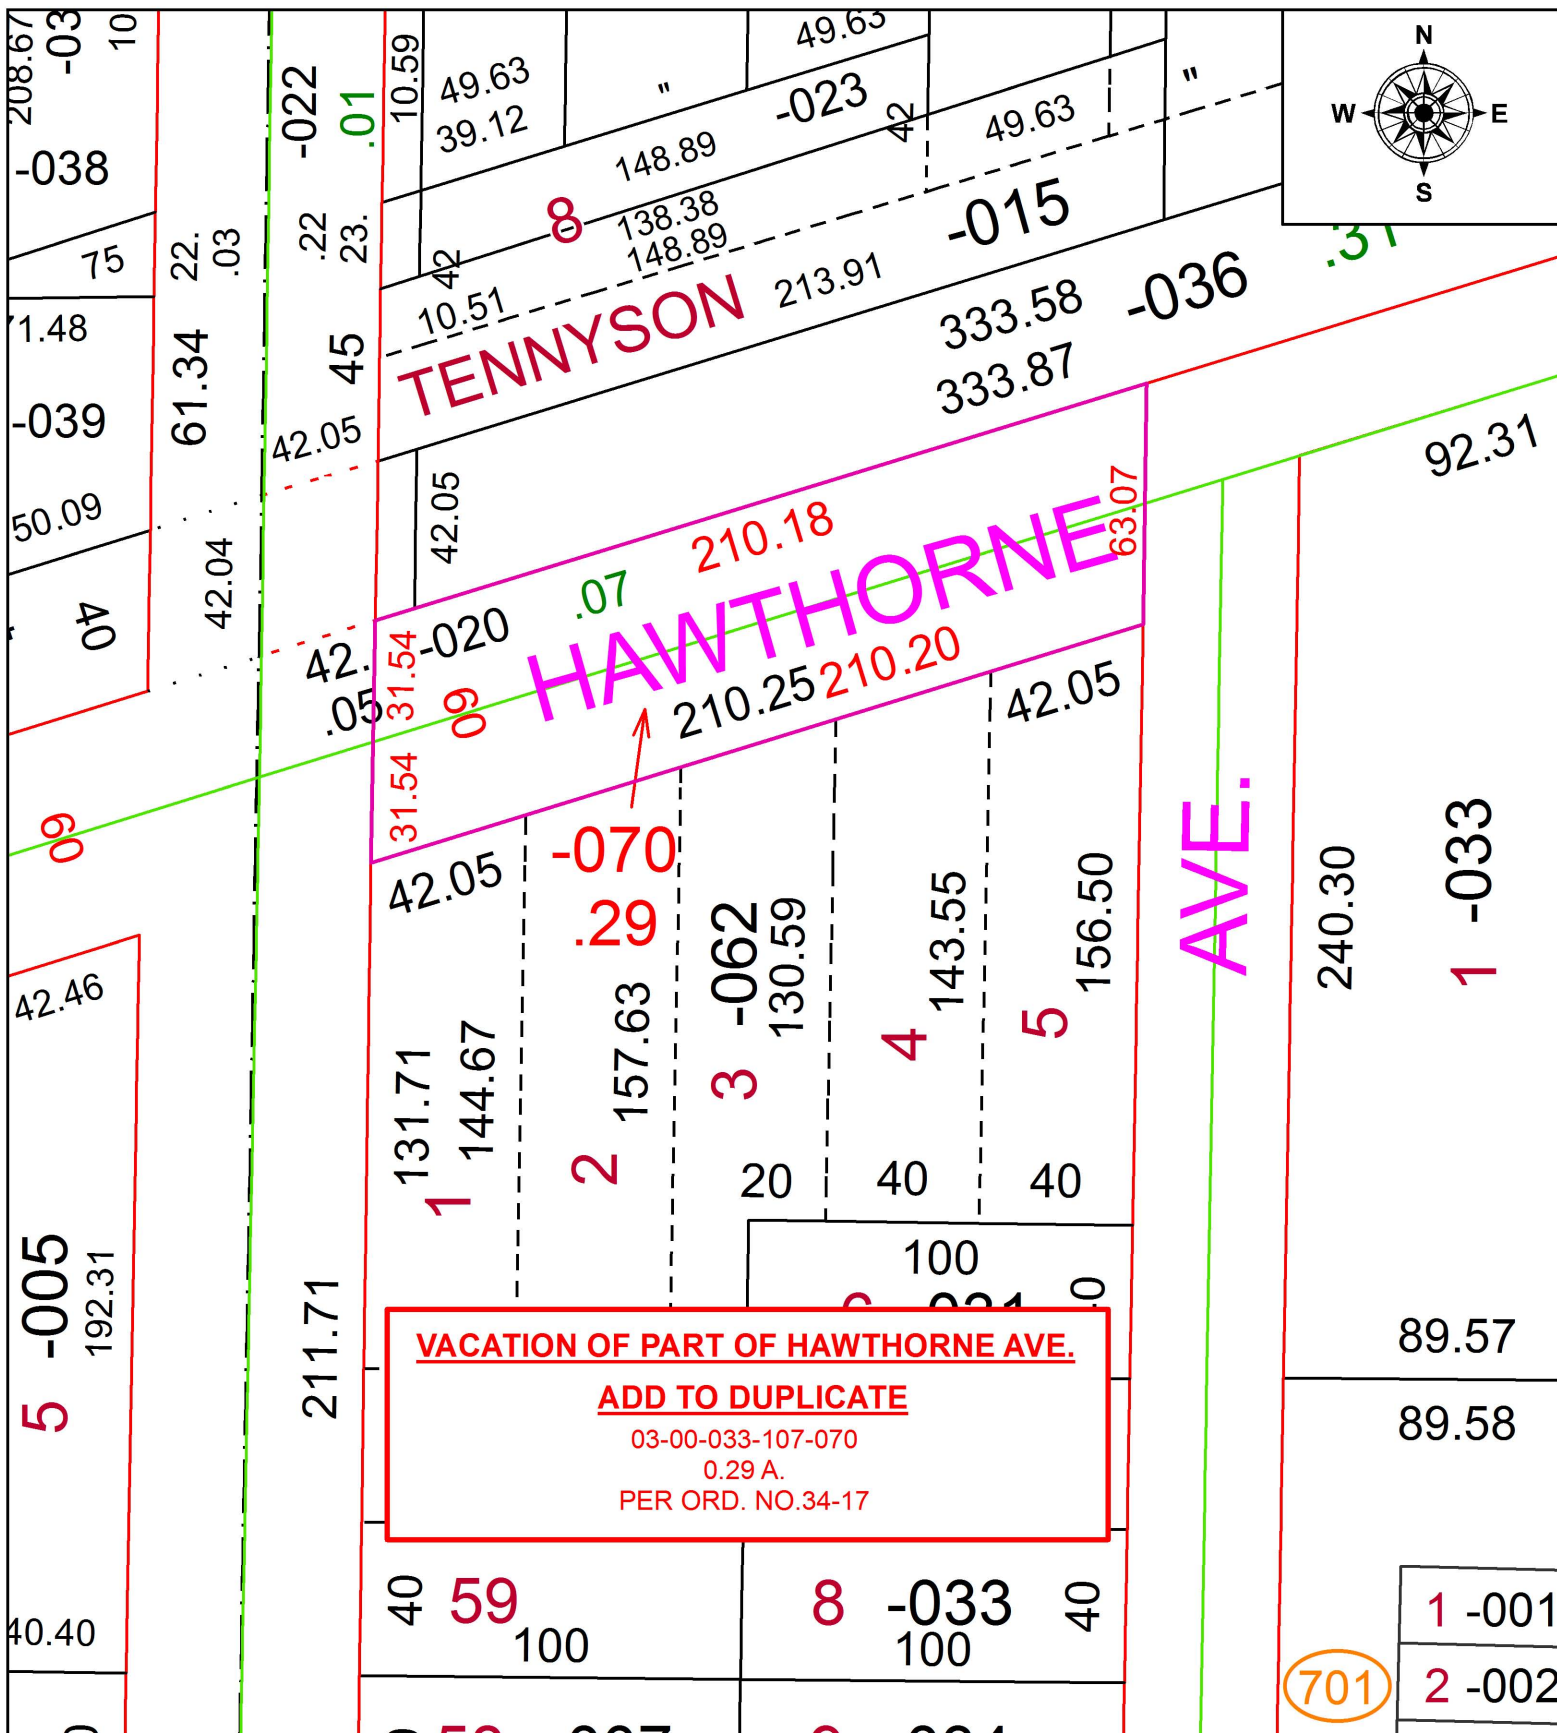

**SPLITS/DEEDS PROCESSED**  
 LORAIN COUNTY TAX MAP DEPARTMENT  
 226 MIDDLE AVE. ELYRIA, OH

SURVEYED BY: AMY M. KELLY  
 CLOSURE: 1:119,234  
 MAP PAGE(S): 3-00-033  
 APPROVED BY: RRM DATE: 1-2-20  
 SCALE: 1" = 50' PRIOR INSTRUMENT: N/A