


PARENT PARCEL: 20-05-017-104-015
 CHILD PARCEL: 20-05-017-104-016 THRU -023
 STARTING POINT:


20-04242-U

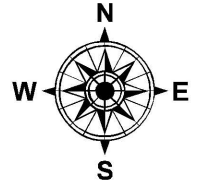

UNCOMBINATION

~~20-05-017-104-015~~
~~271.92 X 353.76~~

| | |
|-------------------------------------|-------------------------------------|
| 20-05-017-104-016 90.42 X 98.75 | 20-05-017-104-020 66 X 136.95 |
| 20-05-017-104-017 89.76 X 106.92 | 20-05-017-104-021 66 X 136.95 |
| 20-05-017-104-018 85.80 X 104.14 | 20-05-017-104-022 66 X 136.95 |
| 20-05-017-104-019 87.78 X 101.48 | 20-05-017-104-023 67.98 X 136.95 |

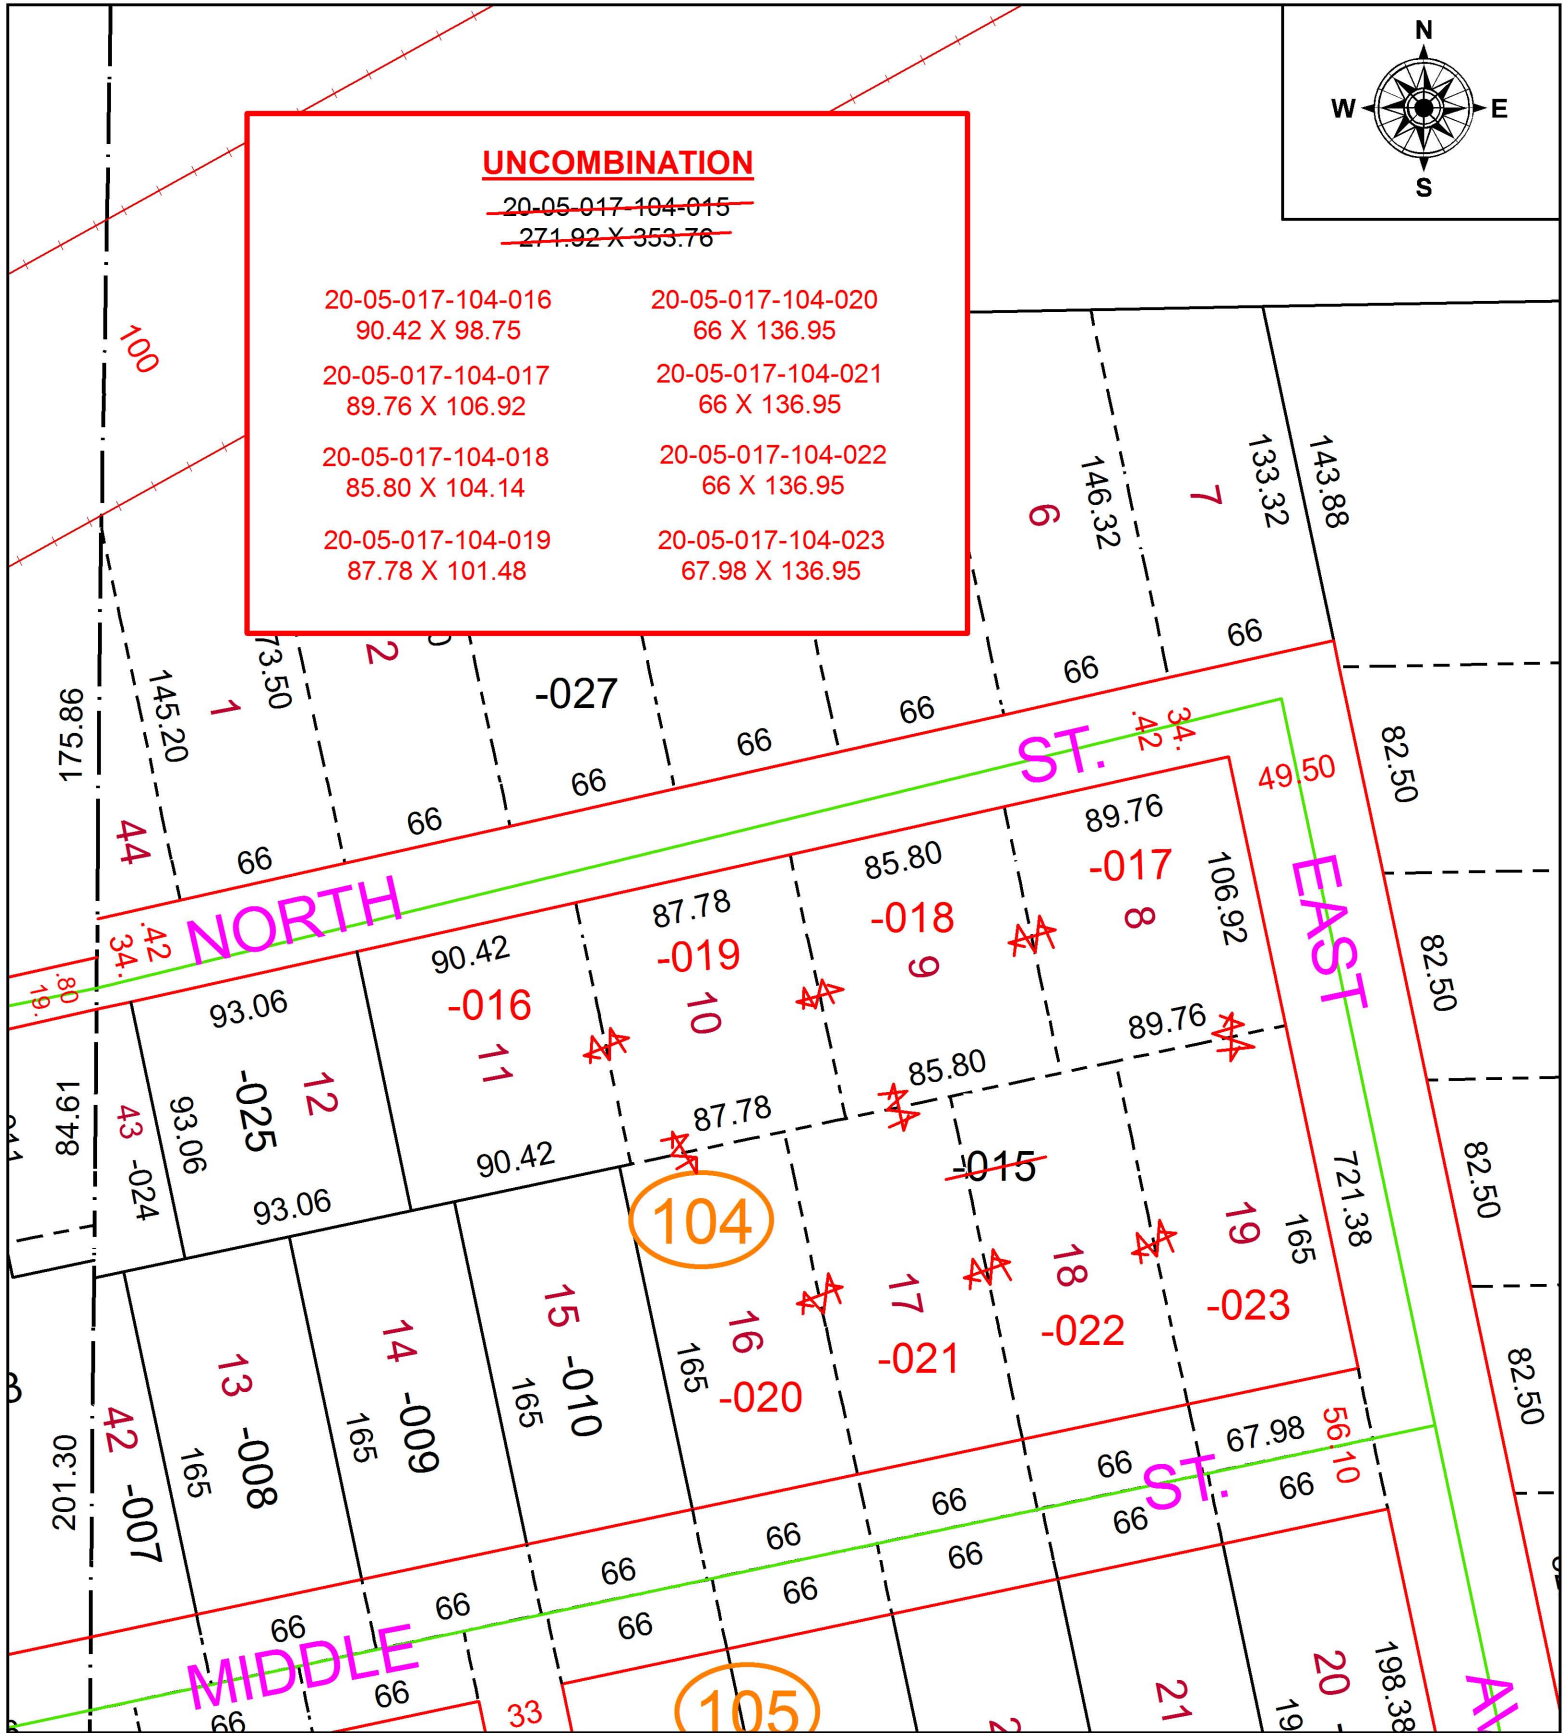

SPLITS/DEEDS PROCESSED
 LORAIN COUNTY TAX MAP DEPARTMENT
 226 MIDDLE AVE. ELYRIA, OH

SURVEYED BY: N/A
 CLOSURE: N/A
 MAP PAGE(S): 20-05-017
 APPROVED BY: RRM DATE: 1-31-20
 SCALE: 1" = 75' PRIOR INSTRUMENT: 20150547506