



PARENT PARCEL: 11-00-004-000-001
 CHILD PARCEL: 11-00-004-000-016, -017
 STARTING POINT: NORTHWEST CORNER OF O.L.4

21-04244

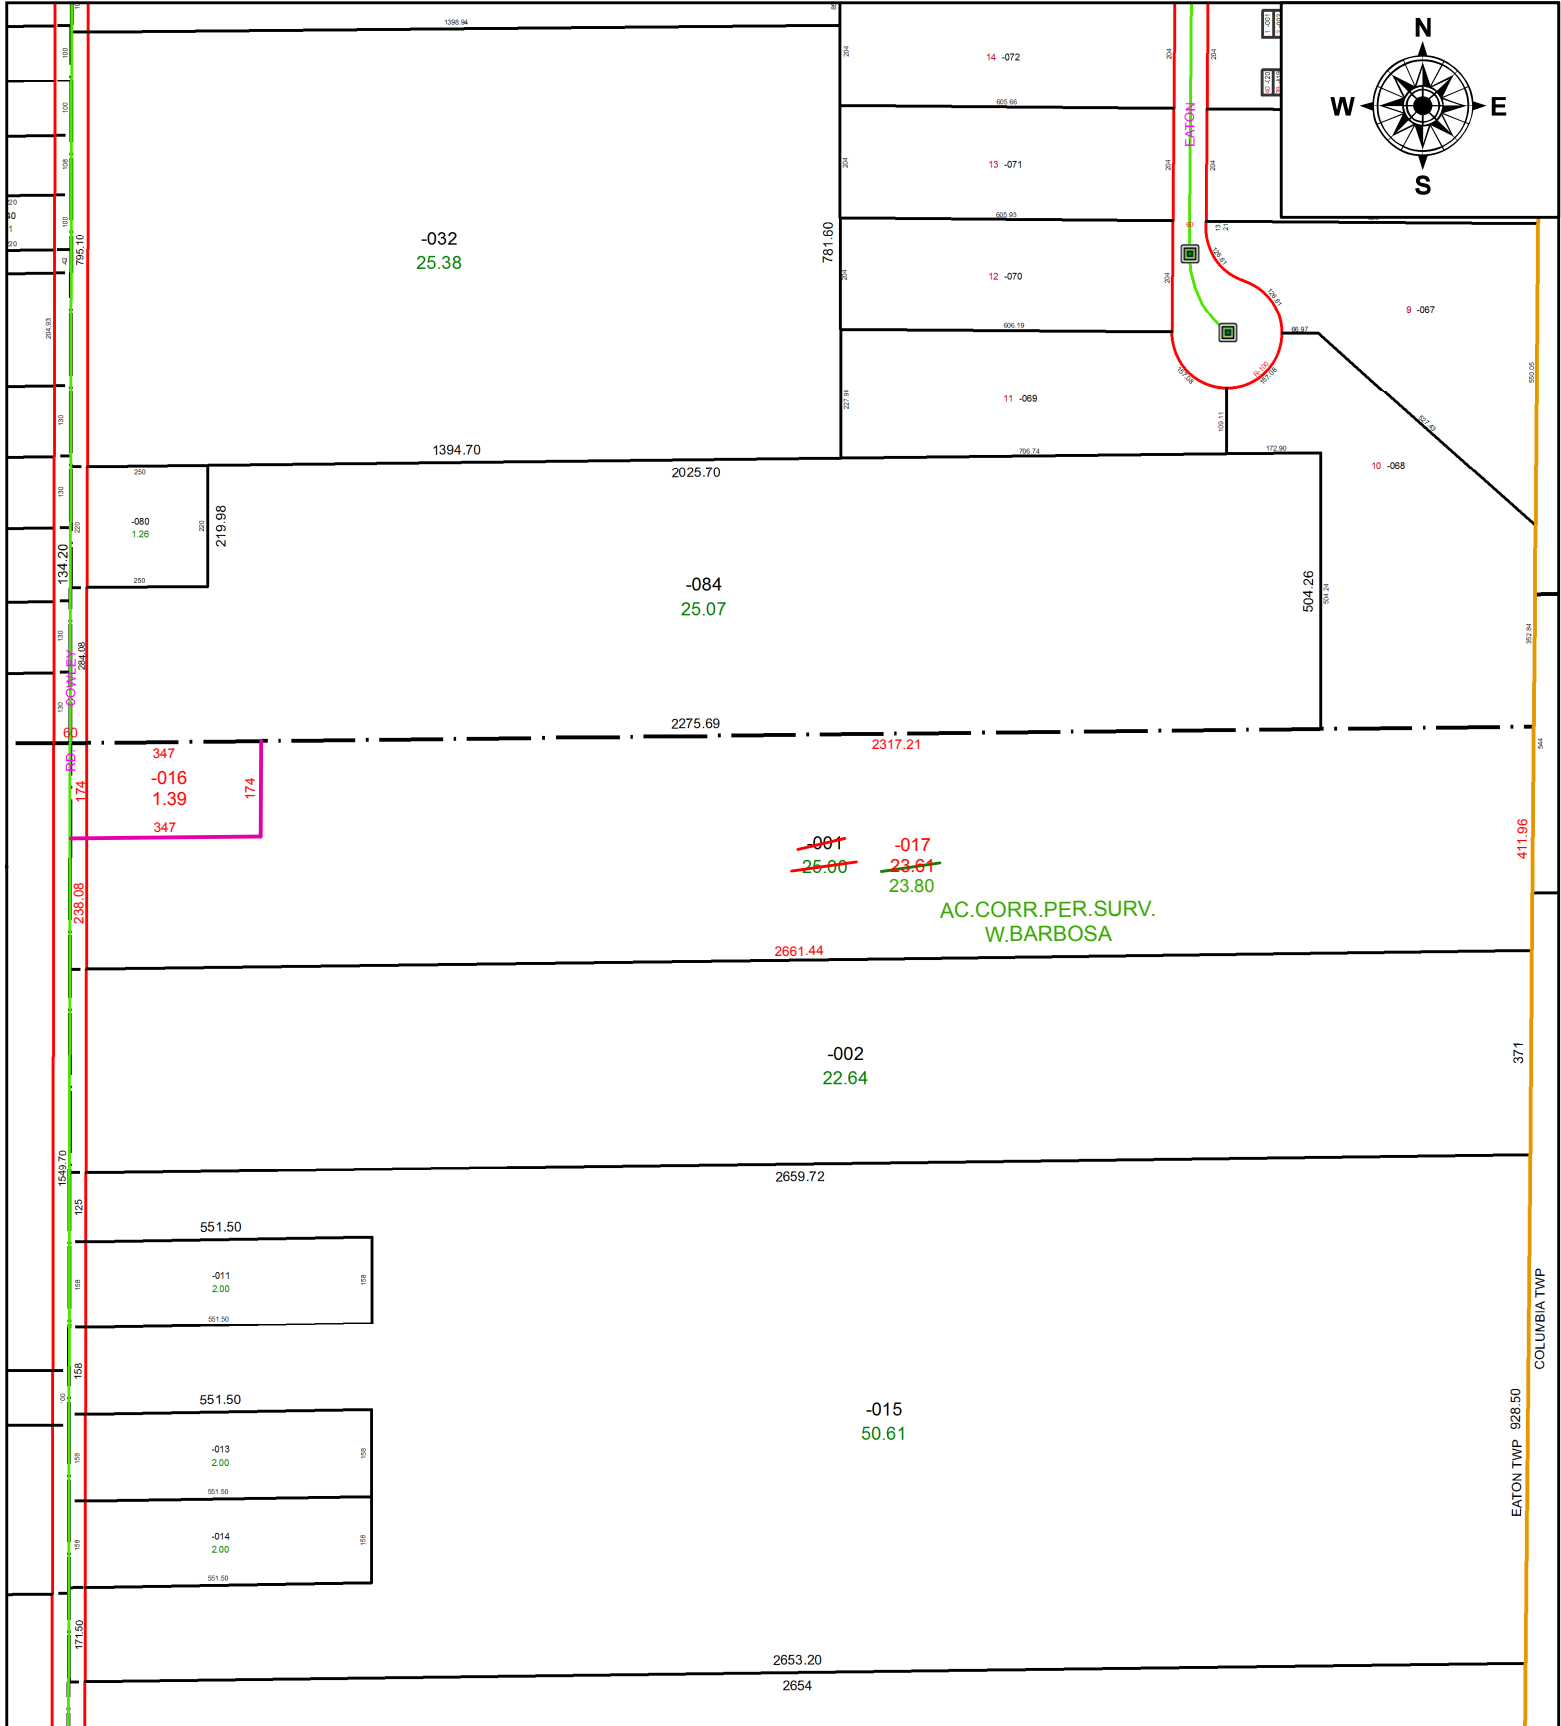

AC.CORR.PER.SURV.
 W.BARBOSA

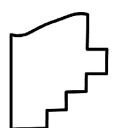

SPLITS/DEEDS PROCESSED
 LORAIN COUNTY TAX MAP DEPARTMENT
 226 MIDDLE AVE. ELYRIA, OH

SURVEYED BY: WILFREDO BARBOSA
 CLOSURE: 1: 1,739,089
 MAP PAGE(S): 11-00-004
 APPROVED BY: RRM DATE: 1-28-21
 SCALE: 1" = 350 PRIOR INSTRUMENT: 20010753934