


PARENT PARCEL: 04-00-006-104-001, -002

CHILD PARCEL: 04-00-006-104-053

STARTING POINT: INTERSECTION OF C/L OF LAKE RD. AND WEST LINE OF SEC. 6

21-04252

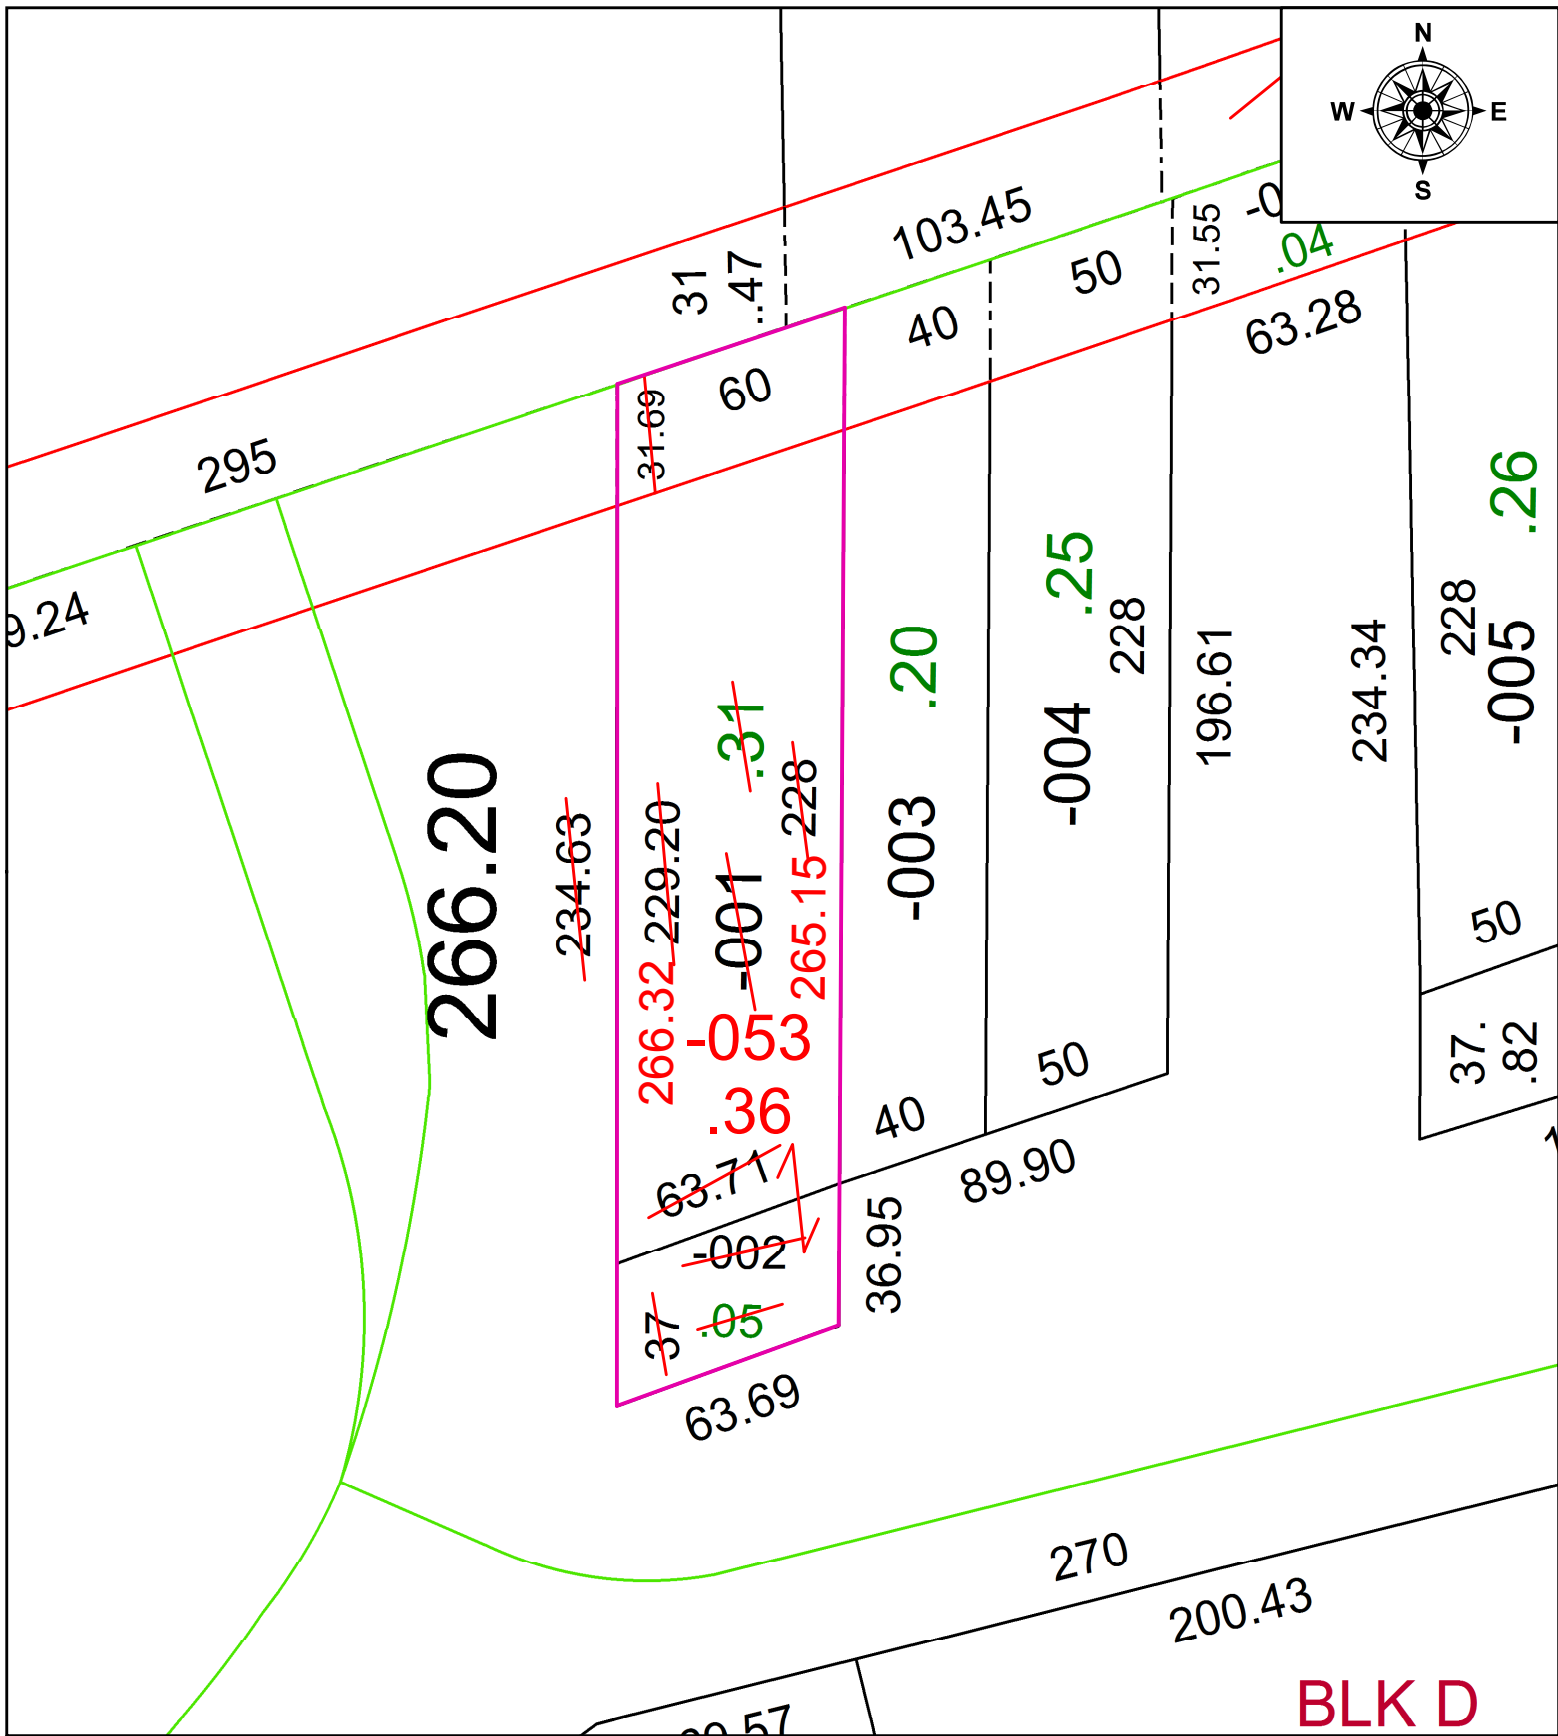

BLK D



SPLITS/DEEDS PROCESSED
LORAIN COUNTY TAX MAP DEPARTMENT
226 MIDDLE AVE. ELYRIA, OH

SURVEYED BY:	SEAN A. BOLAND		
CLOSURE:	1: 133,108		
MAP PAGE(S):	4-00-006		
APPROVED BY:	RRM	DATE:	2-9-21
SCALE:	1" = 50	PRIOR INSTRUMENT:	20170646927