


PARENT PARCEL: 07-00-009-120-152

CHILD PARCEL:


STARTING POINT: INTERSECTION OF C/L OF LEAR NAGLE RD. AND C/L OF FLORALINE AVE.

20-04253-A

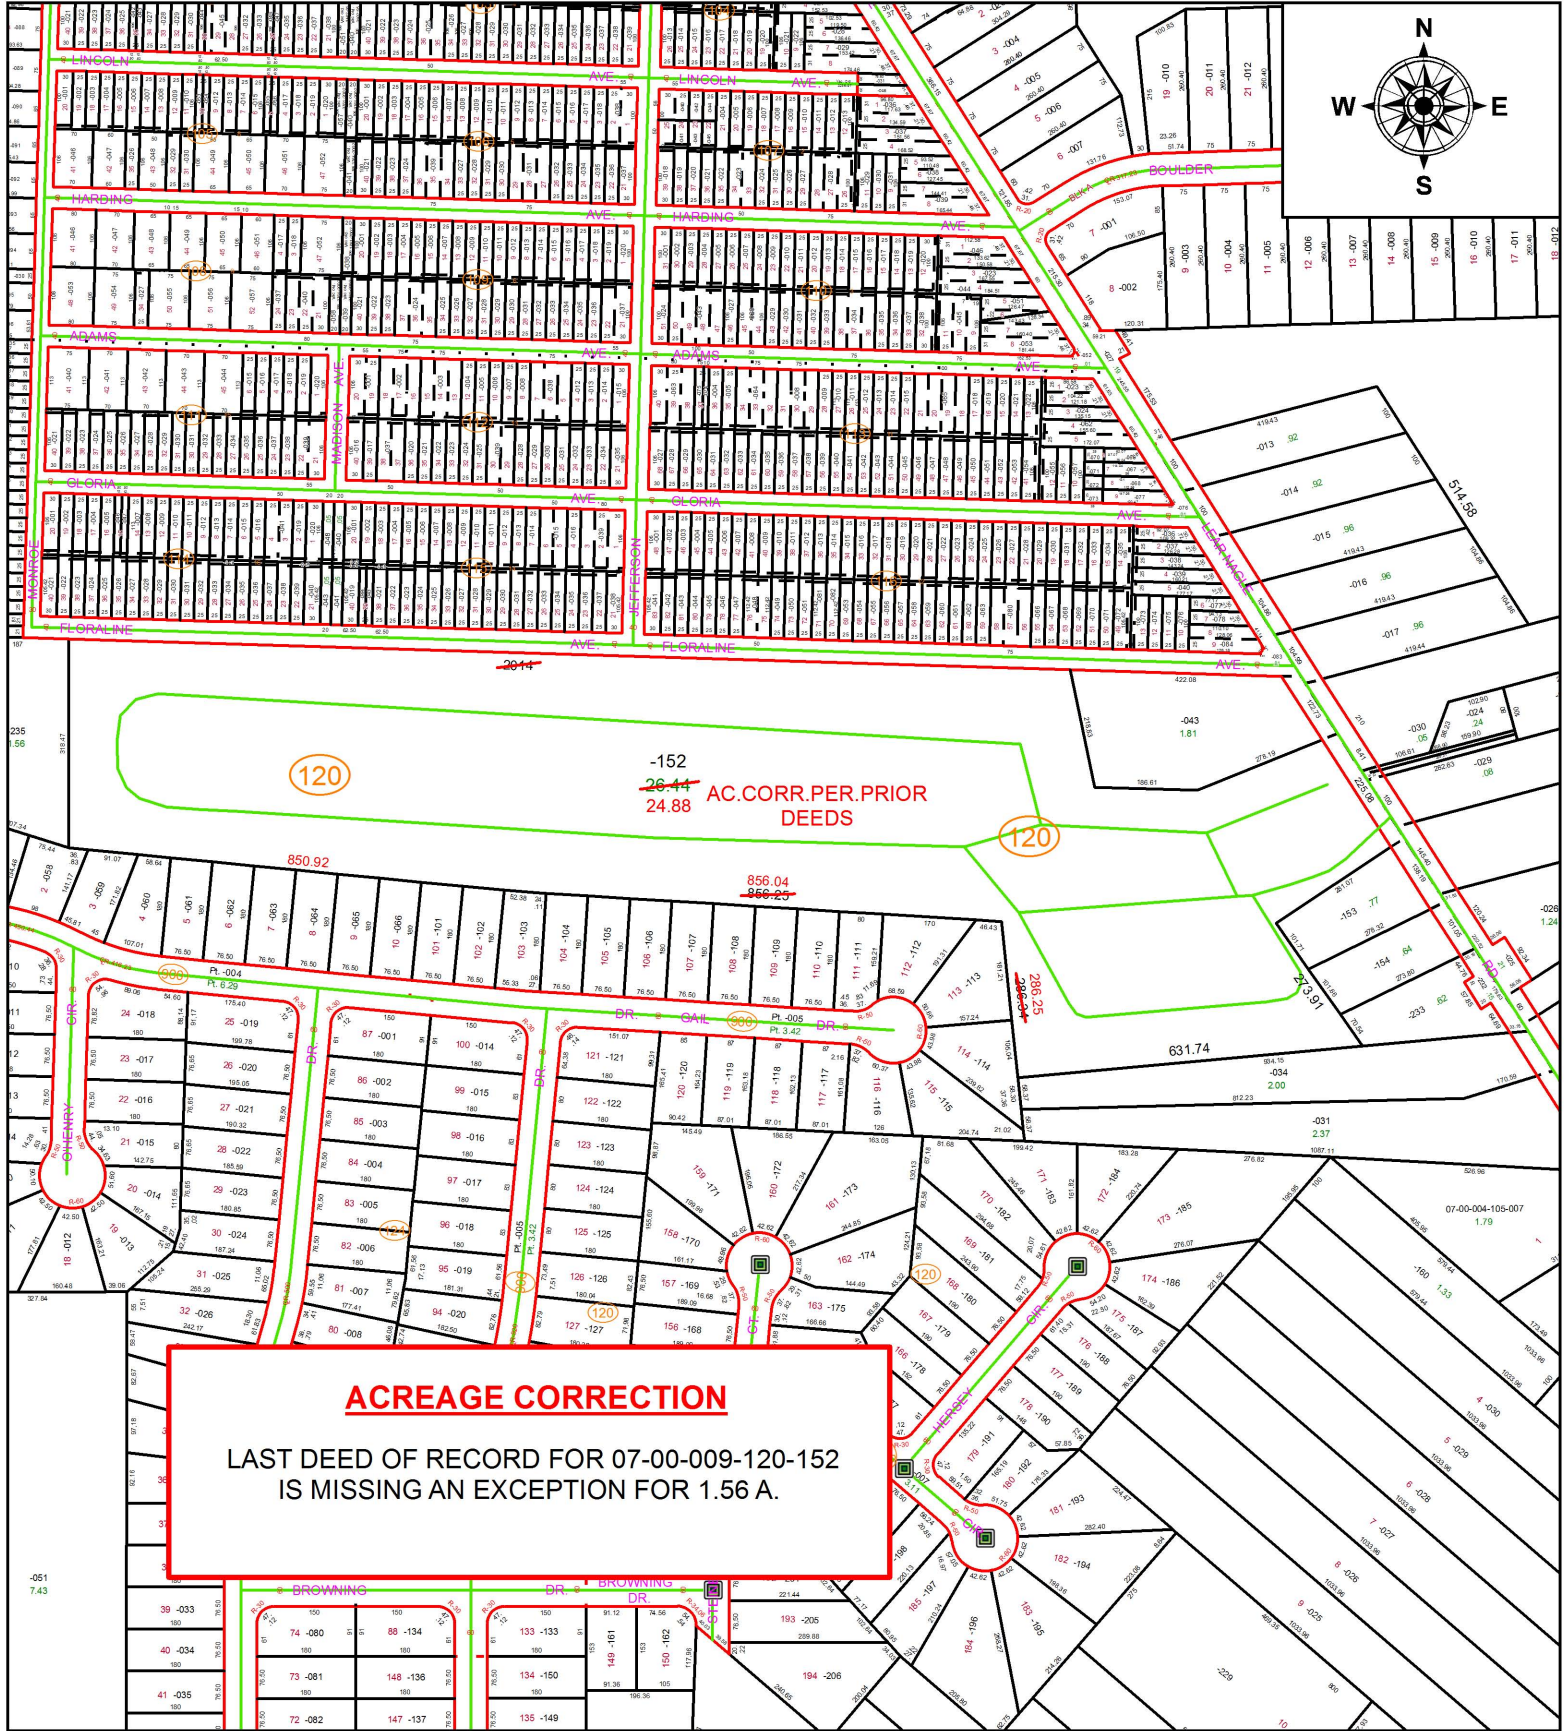

ACREAGE CORRECTION

LAST DEED OF RECORD FOR 07-00-009-120-152
IS MISSING AN EXCEPTION FOR 1.56 A.

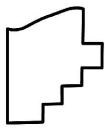

SPLITS/DEEDS PROCESSED

LORAIN COUNTY TAX MAP DEPARTMENT
226 MIDDLE AVE. ELYRIA, OH

SURVEYED BY: N/A
 CLOSURE: 1:1,109,144
 MAP PAGE(S): 7-00-009
 APPROVED BY: RRM DATE: 1-29-20
 SCALE: 1" = 350 PRIOR INSTRUMENT: 20190728804