
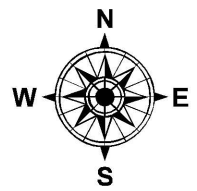


PARENT PARCEL: 05-00-062-110-010

CHILD PARCEL:

STARTING POINT: C/L OF OBERLIN RD. AND EXTENSION OF NORTH LINE OF S/L 43 IN BECHTEL SUB. NO.2


20-04254-C

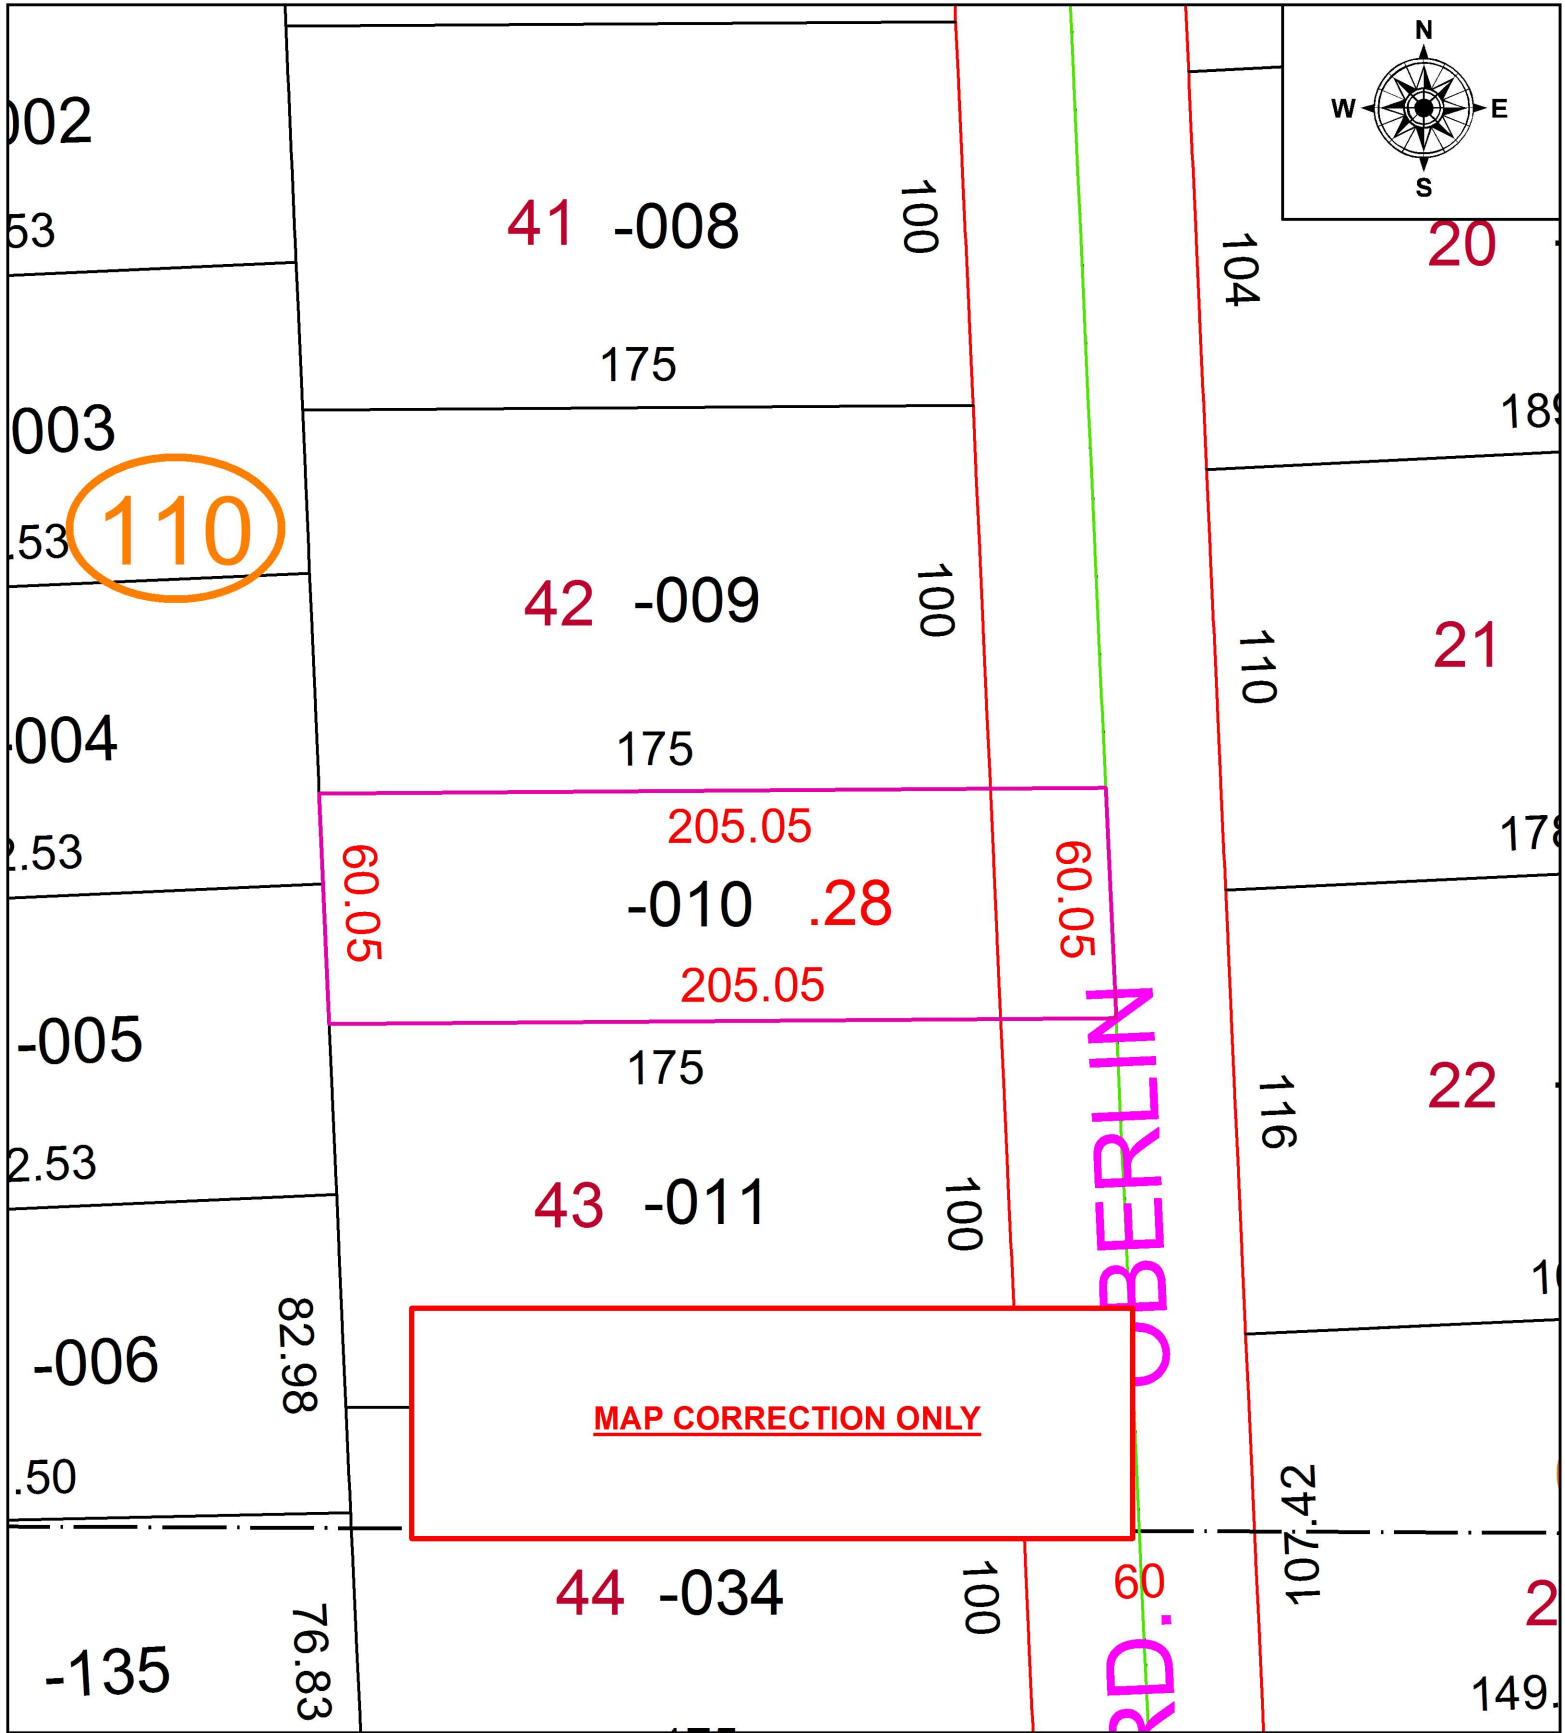

110

MAP CORRECTION ONLY

OBERLIN RD.

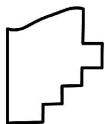

**SPLITS/DEEDS PROCESSED**  
 LORAIN COUNTY TAX MAP DEPARTMENT  
 226 MIDDLE AVE. ELYRIA, OH

SURVEYED BY: N/A  
 CLOSURE: 1:2147483648  
 MAP PAGE(S): 5-00-062  
 APPROVED BY: RRM DATE: 1-29-20  
 SCALE: 1" = 50 PRIOR INSTRUMENT: 20190736161