
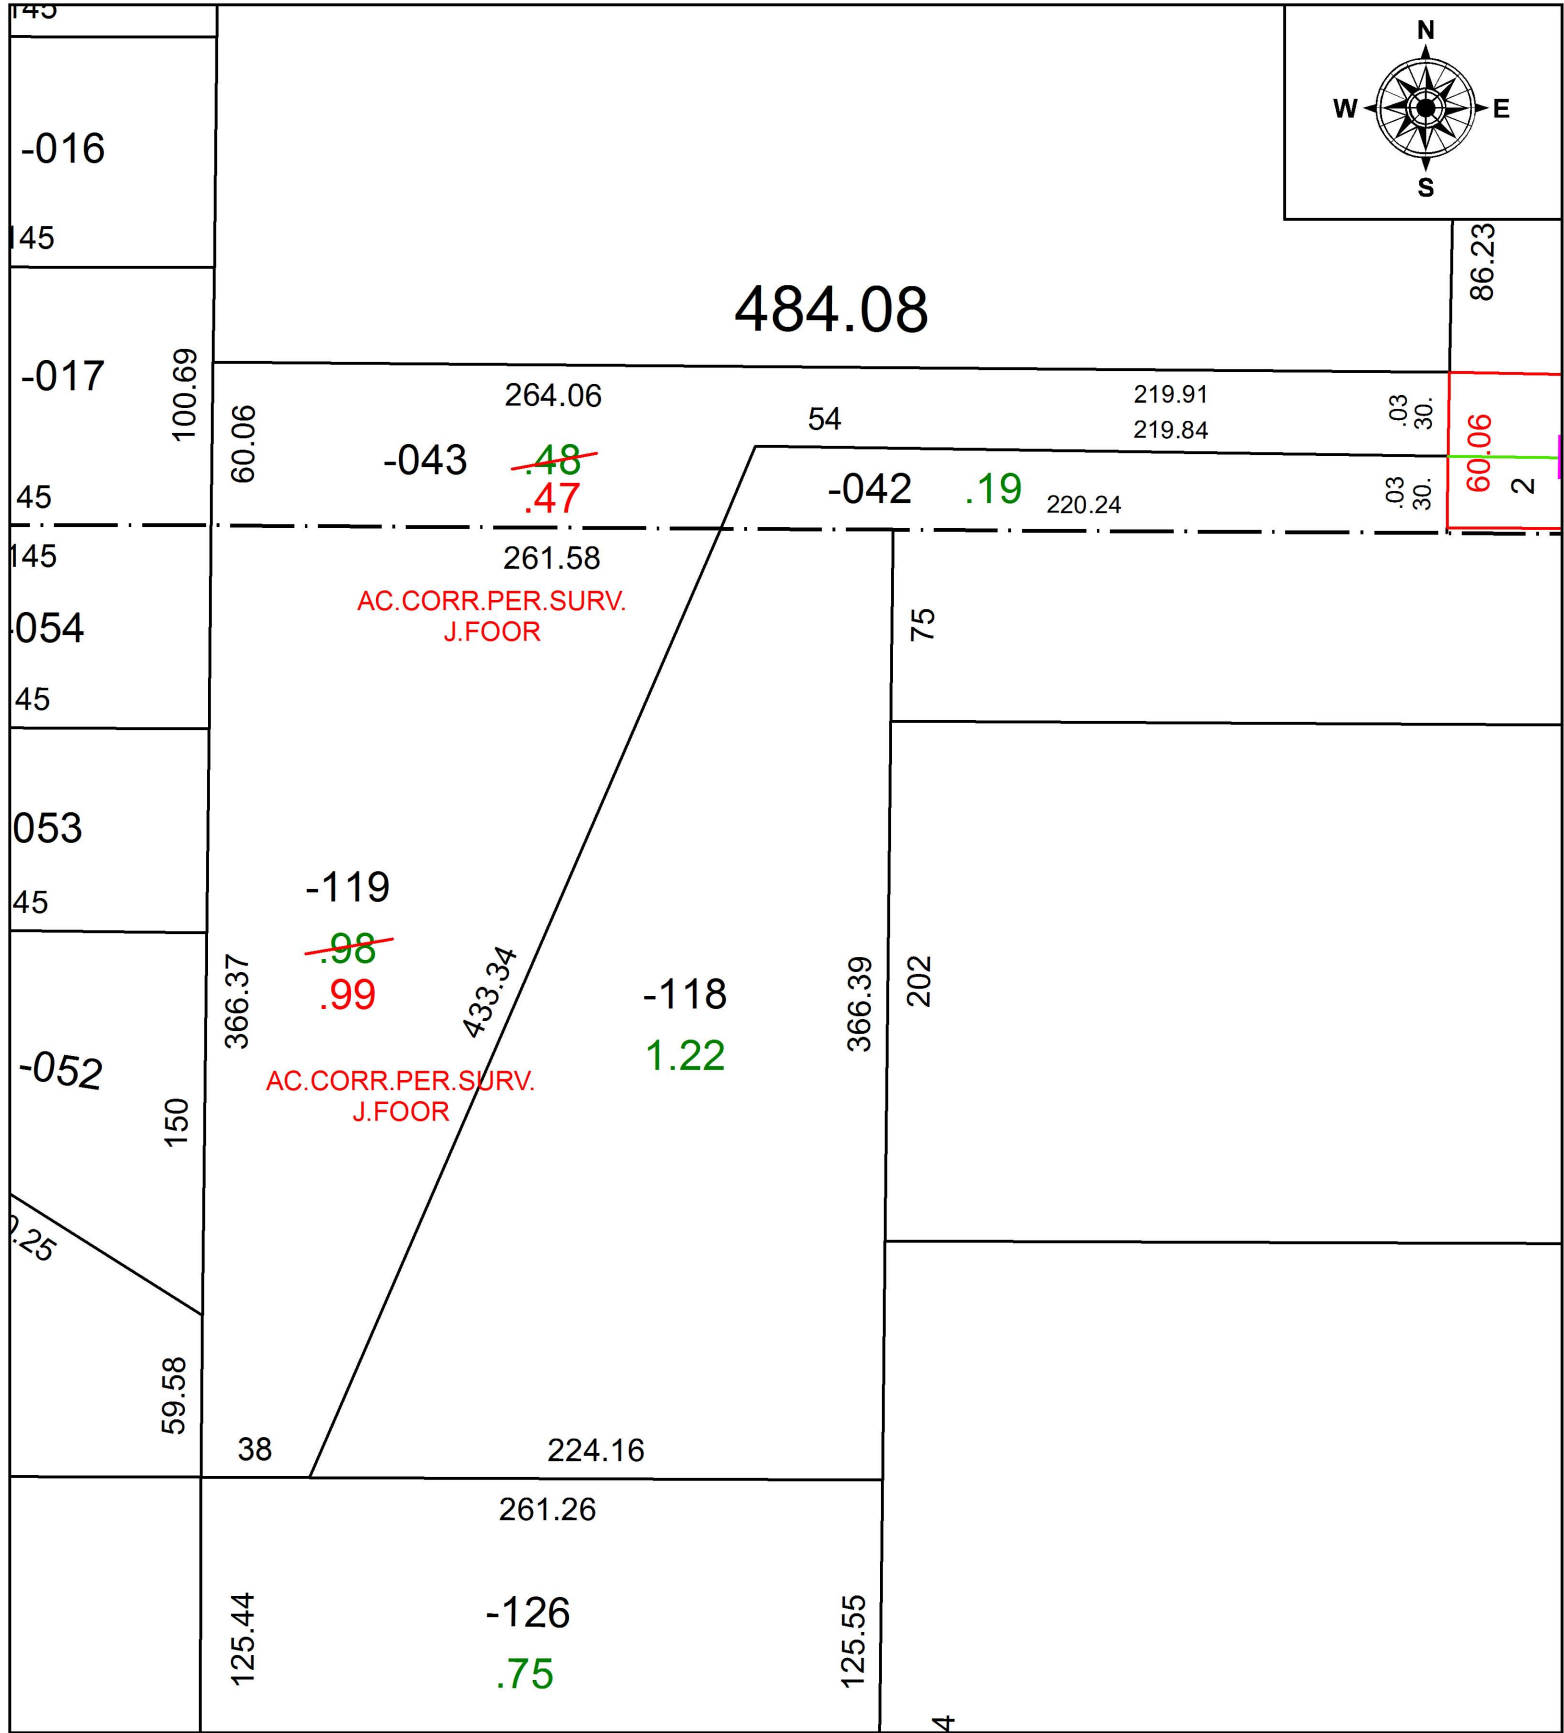


PARENT PARCEL: 04-00-022-106-043, 04-00-023-105-119

CHILD PARCEL:

STARTING POINT: INTERSECTION OF C/L OF LEAR NAGLE RD. AND NORTH LINE OF SEC. 23

20-04255-A

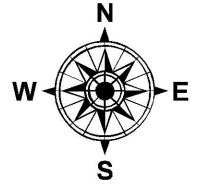

SPLITS/DEEDS PROCESSED
LORAIN COUNTY TAX MAP DEPARTMENT
226 MIDDLE AVE. ELYRIA, OH

SURVEYED BY: J.R. FOOR
CLOSURE: 1:519,498
MAP PAGE(S): 4-00-023
APPROVED BY: RRM DATE: 1-29-20
SCALE: 1" = 75' PRIOR INSTRUMENT: 20190739499