


PARENT PARCEL: 04-00-011-106-004

CHILD PARCEL:

STARTING POINT: NORTHEAST CORNER OF LAND CONVEYED TO ARTHUR H. LEASURE (DV 785/226)

20-04259-A

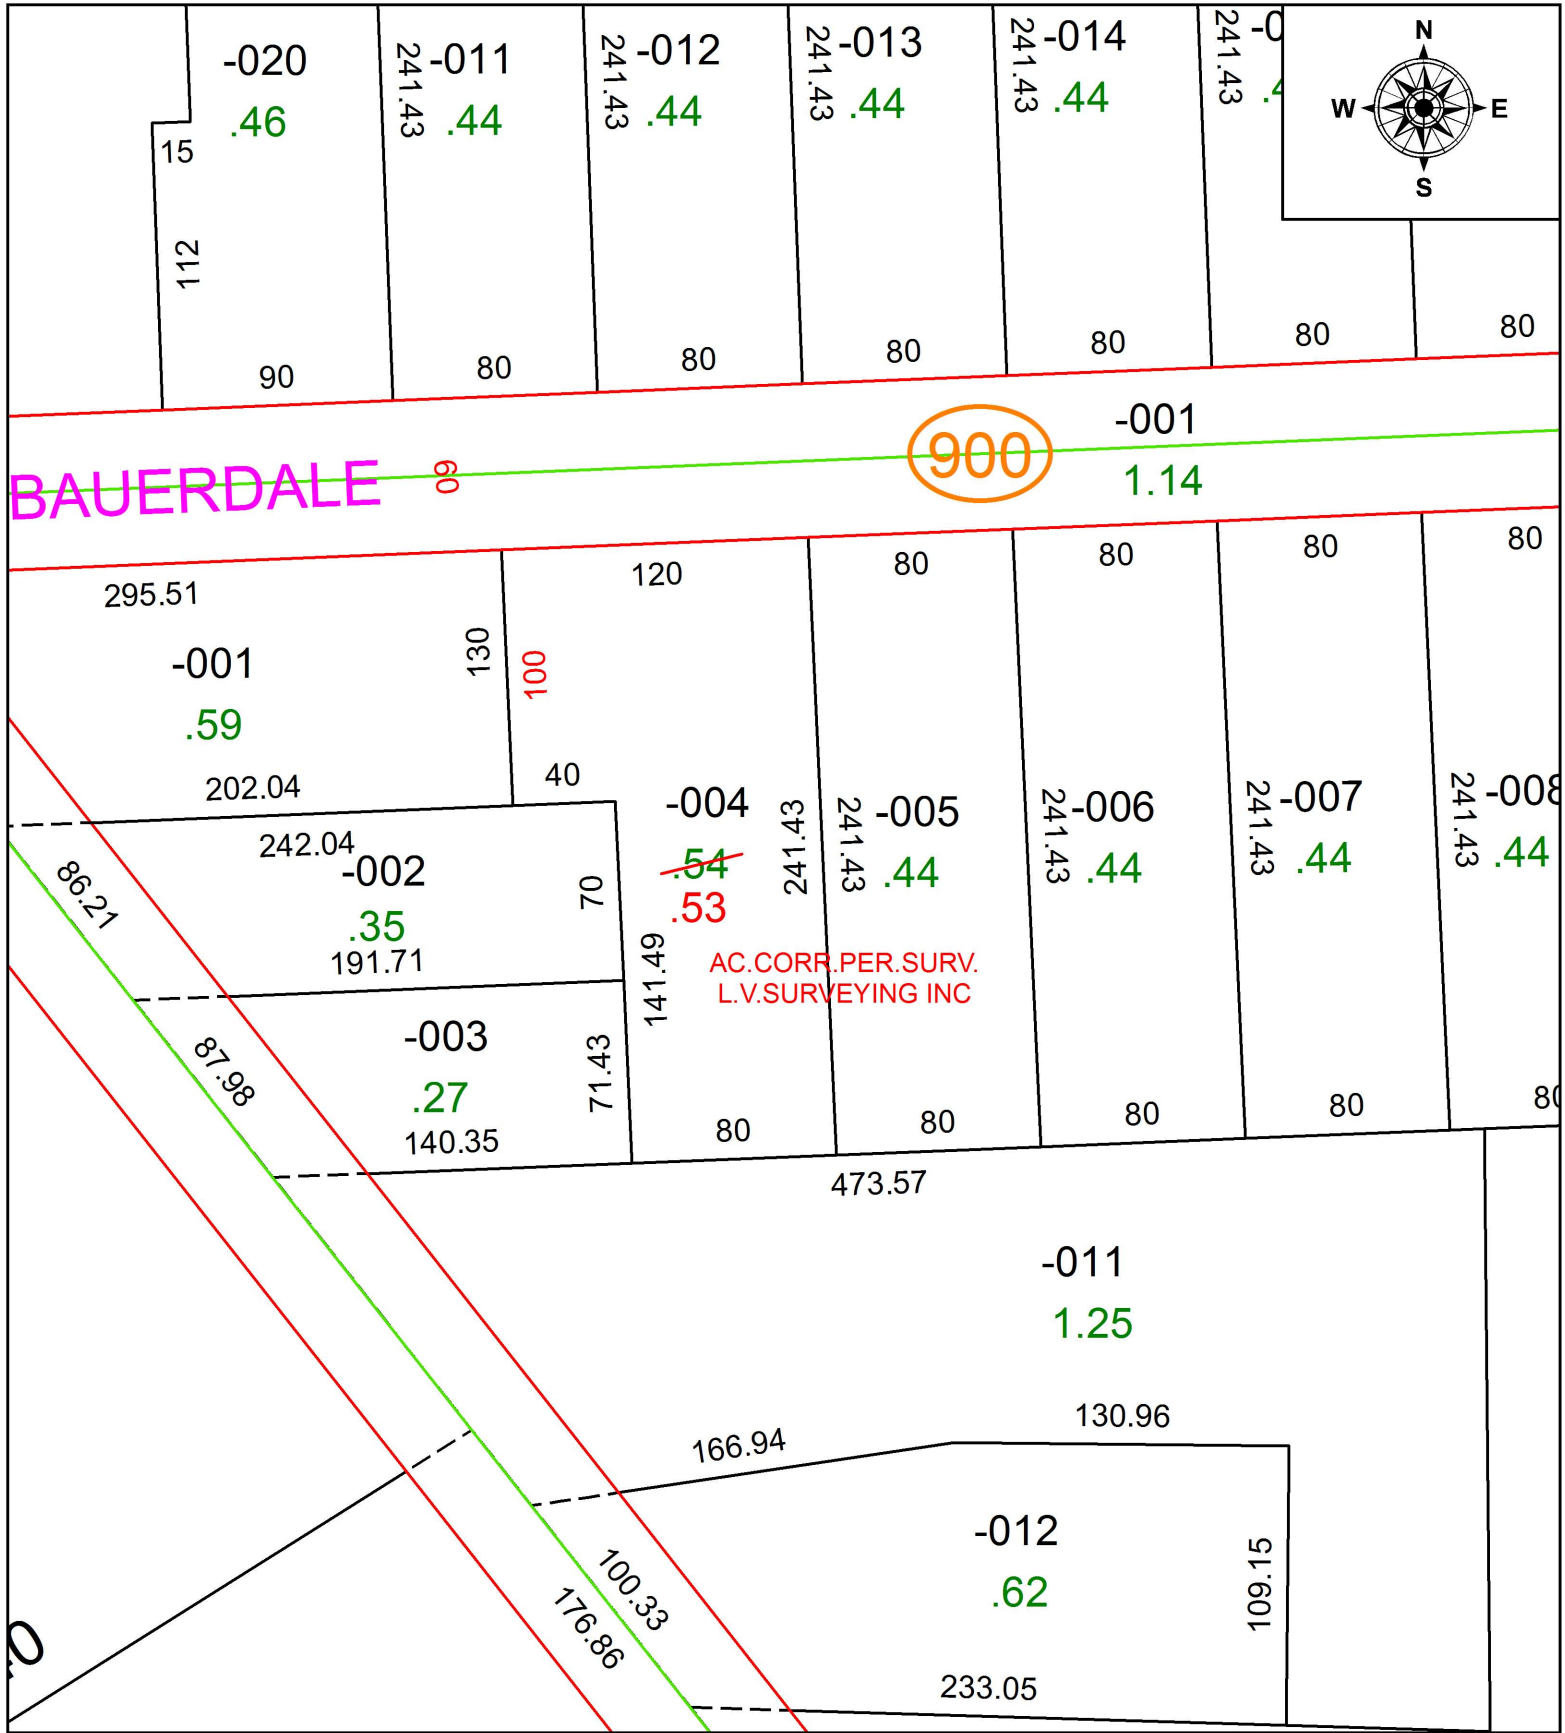

SPLITS/DEEDS PROCESSED
 LORAIN COUNTY TAX MAP DEPARTMENT
 226 MIDDLE AVE. ELYRIA, OH

SURVEYED BY: L.V. SURVEYING INC.
 CLOSURE: 1:12,048
 MAP PAGE(S): 4-00-011
 APPROVED BY: RRM DATE: 1-30-20
 SCALE: 1" = 75' PRIOR INSTRUMENT: 20190737885