

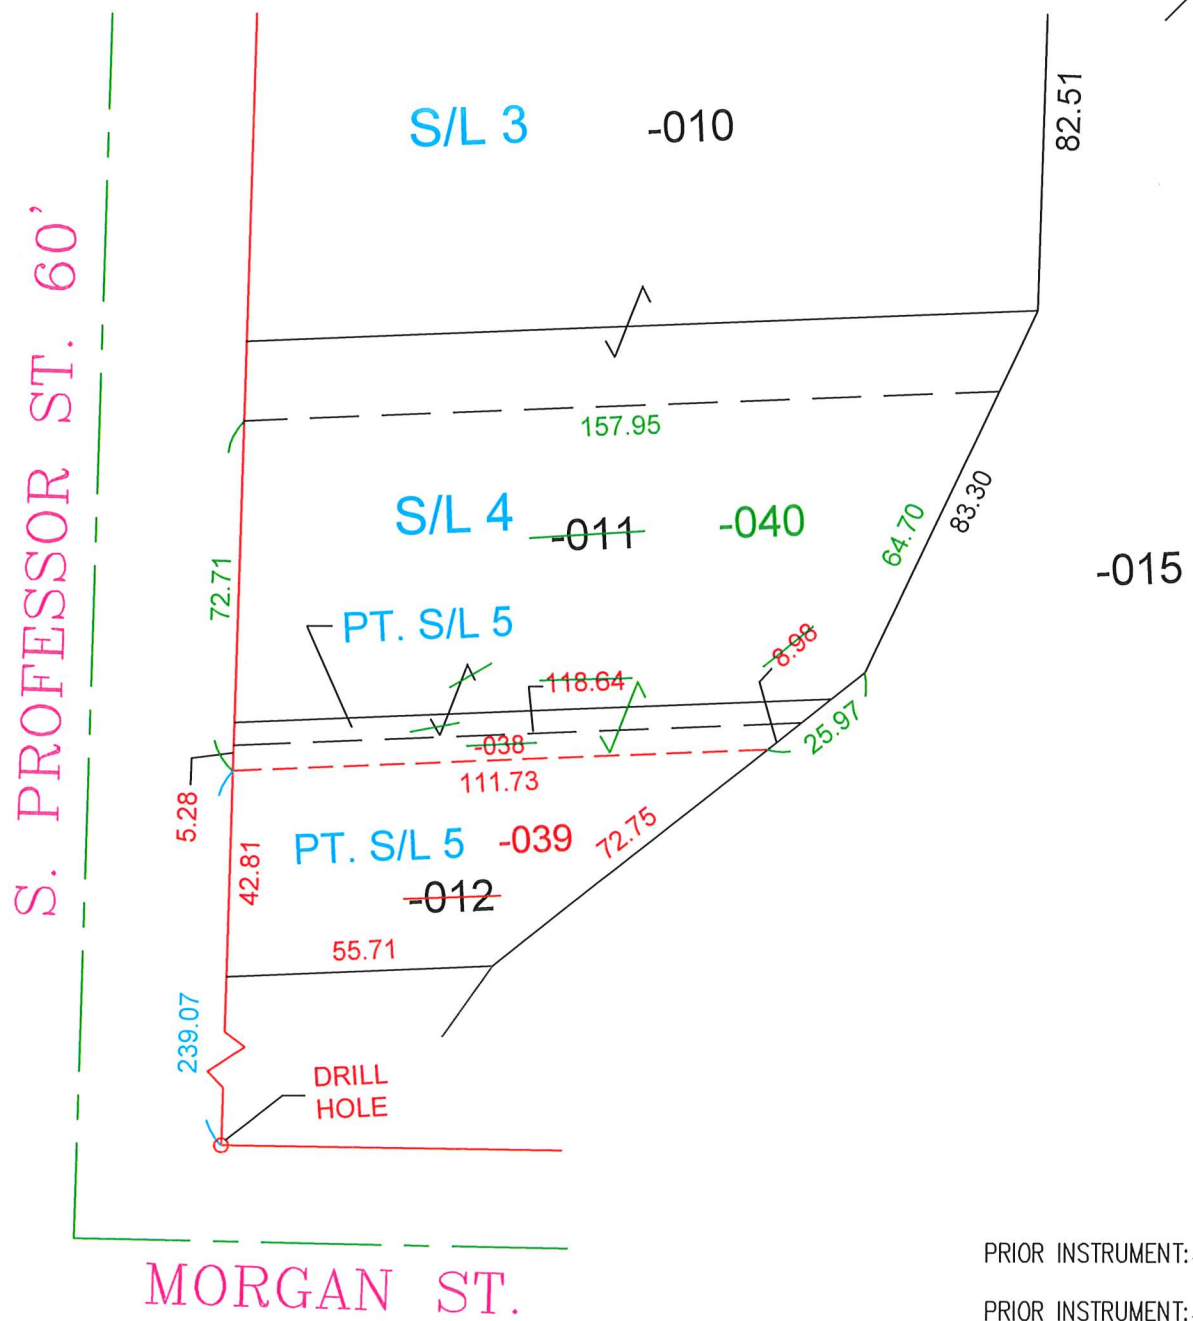


PARENT PARCEL: 09-00-085-113-011 & 012
 CHILD PARCEL: 09-00-085-113-038, -039, & -040
 STARTING POINT: DRILL HOLE, NORTH R.O.W. OF MORGAN ST. & EAST R.O.W. OF S. PROFESSOR ST.

21-04259

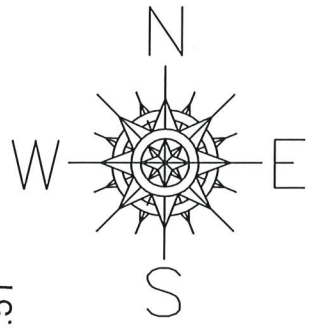

PRIOR INSTRUMENT: DV 188/146
 PRIOR INSTRUMENT: 2016-0601799

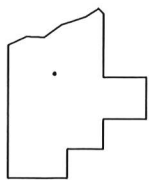

SPLITS/DEEDS PROCESSED
 LORAIN COUNTY TAX MAP DEPARTMENT
 226 MIDDLE AVE. ELYRIA, OHIO

SURVEYED BY: R. FREDRICKSON
 CLOSURE: 0.01 : 10,000
 MAP PAGE(S): 09-00-085
 APPROVED BY: TJS DATE: 2/22/2021
 SCALE: 1" = 40'