


PARENT PARCEL: 03-00-098-127-040

CHILD PARCEL:

STARTING POINT: S/L 179 IN HIGHLAND ADD.

20-04260-C

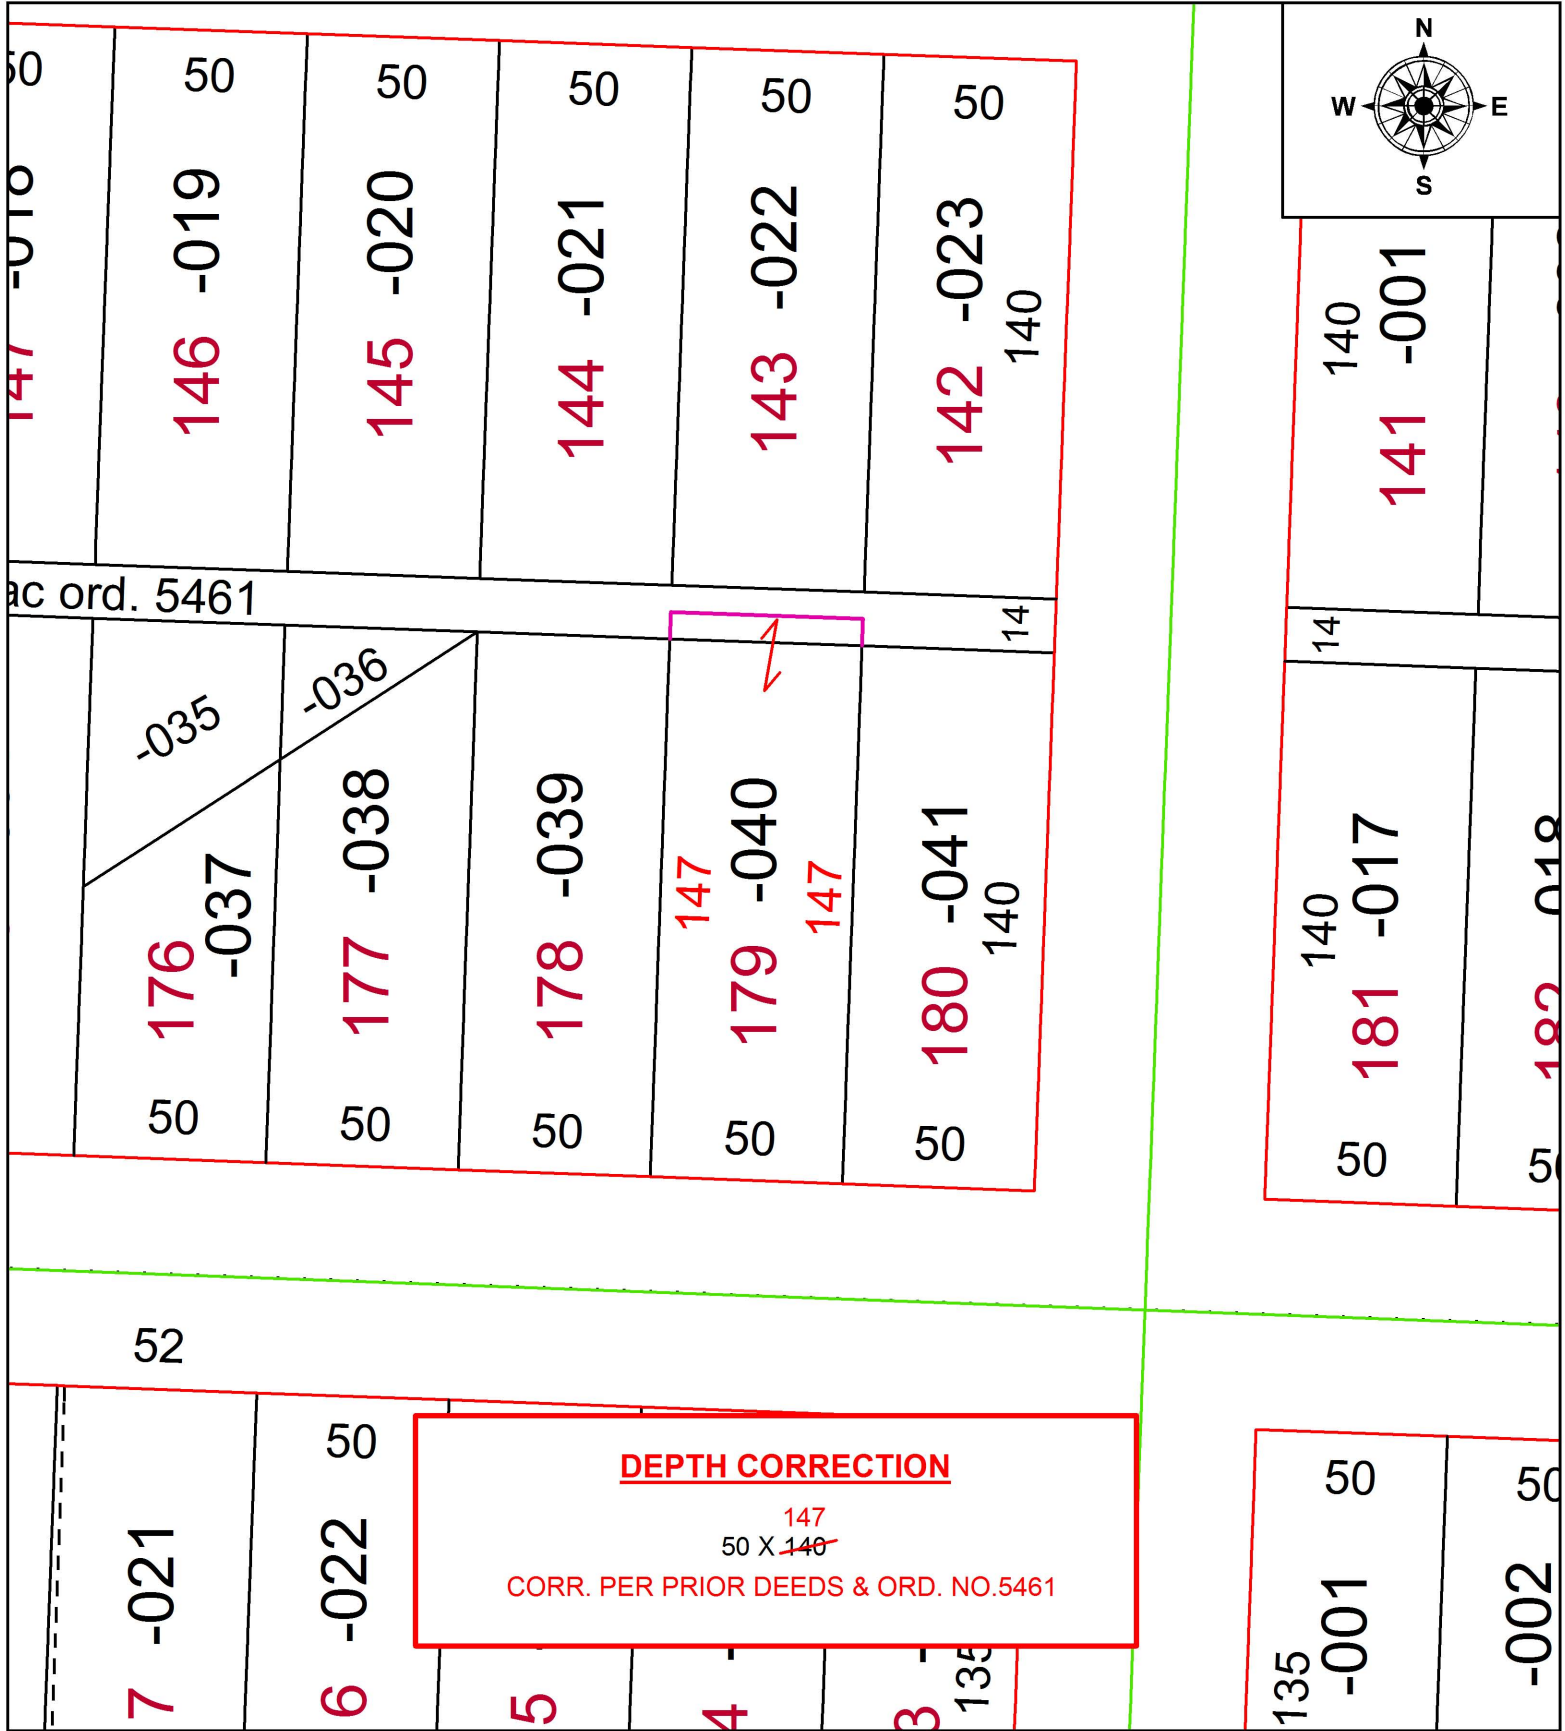

ac ord. 5461

DEPTH CORRECTION
 147
 50 X ~~140~~
 CORR. PER PRIOR DEEDS & ORD. NO.5461



SPLITS/DEEDS PROCESSED
 LORAIN COUNTY TAX MAP DEPARTMENT
 226 MIDDLE AVE. ELYRIA, OH

SURVEYED BY: _____ N/A
 CLOSURE: _____ N/A
 MAP PAGE(S): _____ 3-00-098
 APPROVED BY: _____ RRM DATE: _____ 1-30-20
 SCALE: _____ 1" = 50 _____ PRIOR INSTRUMENT: _____ 20190726859