
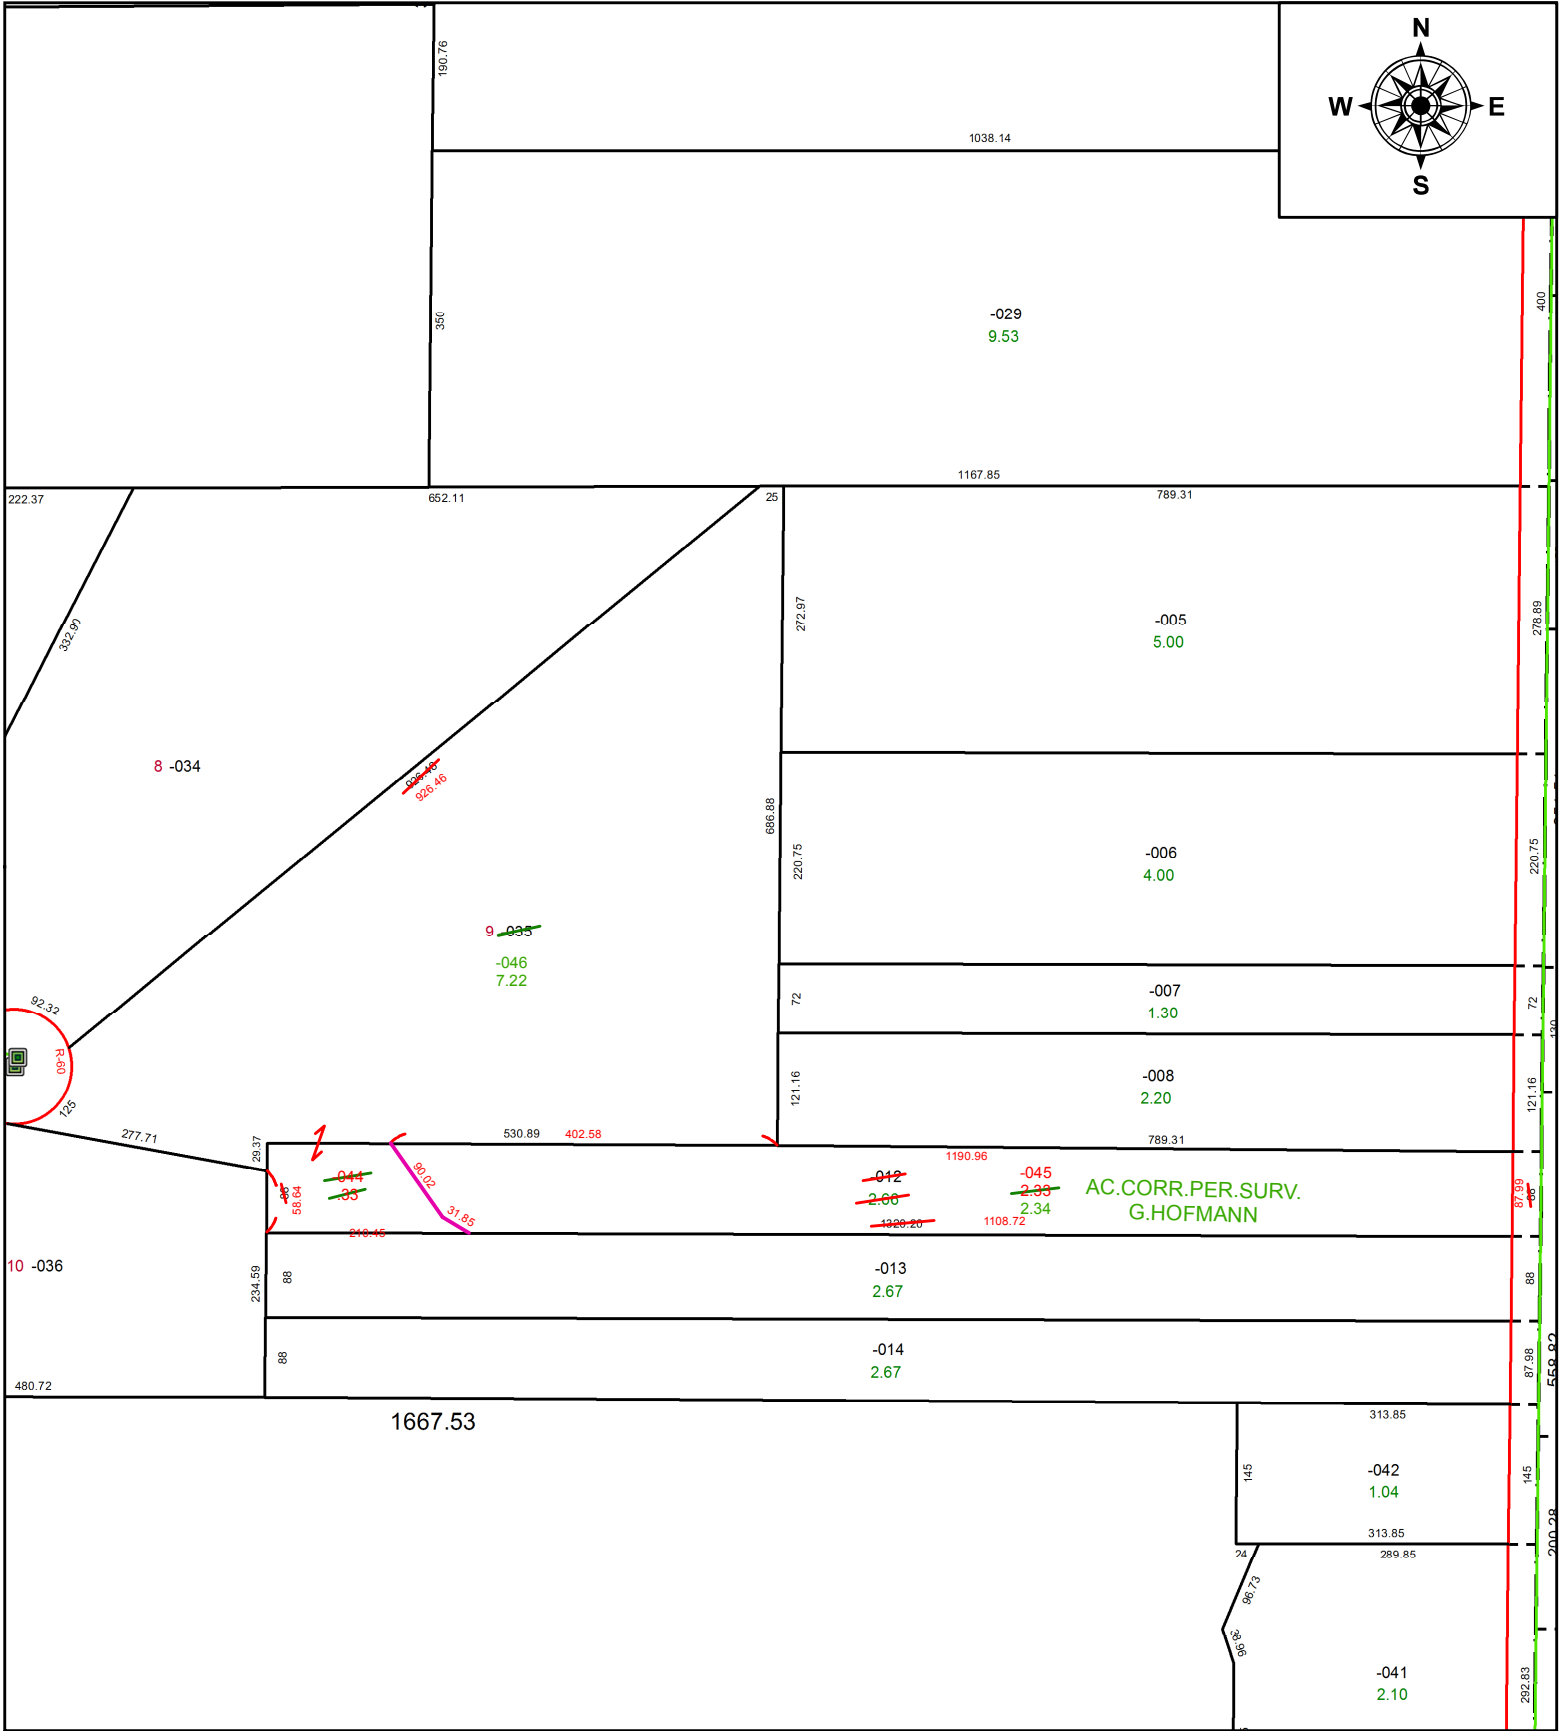


PARENT PARCEL: 12-00-024-000-012, -035
 CHILD PARCEL: 12-00-024-000-044 THRU -046
 STARTING POINT: SOUTHEAST CORNER OF O.L.24

21-04260

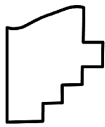

 **SPLITS/DEEDS PROCESSED**
 LORAIN COUNTY TAX MAP DEPARTMENT
 226 MIDDLE AVE. ELYRIA, OH

SURVEYED BY: GEORGE A. HOFMANN
CLOSURE: 1:27,449
MAP PAGE(S): 12-00-024
APPROVED BY: RRM **DATE:** 2-26-21
SCALE: 1" = 200 **PRIOR INSTRUMENT:** 19990647956