


PARENT PARCEL: 18-00-025-000-011  
 CHILD PARCEL: 18-00-025-000-012, -013  
 STARTING POINT: NORTHWEST CORNER OF O.L.25

21-04262

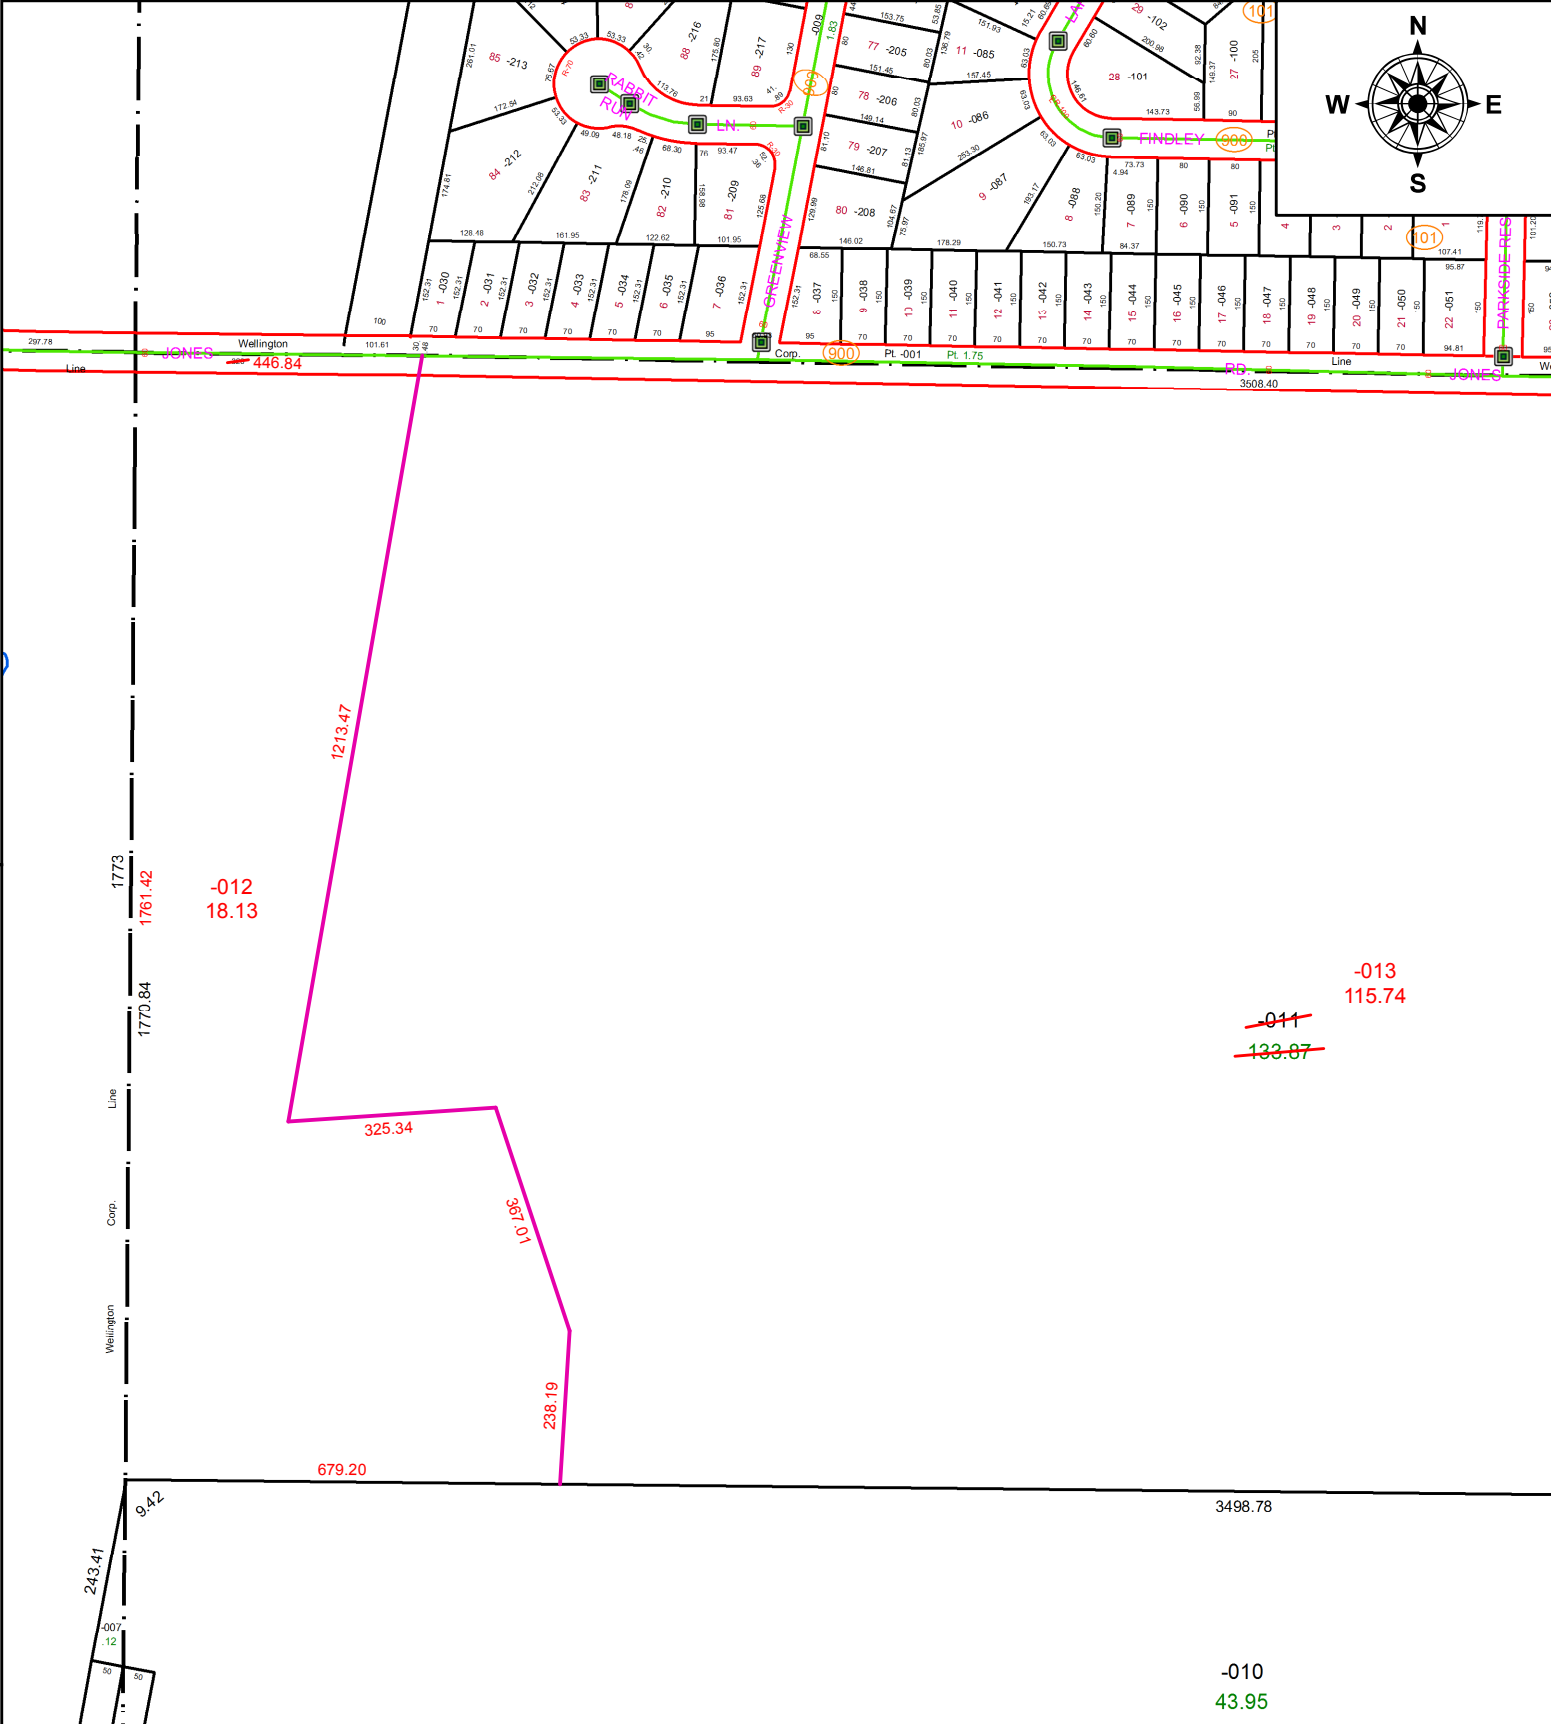

**SPLITS/DEEDS PROCESSED**  
 LORAIN COUNTY TAX MAP DEPARTMENT  
 226 MIDDLE AVE. ELYRIA, OH

SURVEYED BY: JAMES D. WELLERT  
 CLOSURE: 1: 558,312  
 MAP PAGE(S): 18-00-025  
 APPROVED BY: RRM DATE: 2-24-21  
 SCALE: 1" = 300 PRIOR INSTRUMENT: 20020827175