


PARENT PARCEL: 16-00-094-000-005, -009  
 CHILD PARCEL: 16-00-094-000-012 THRU -016  
 STARTING POINT: SOUTHEAST CORNER OF O.L.93

21-04264

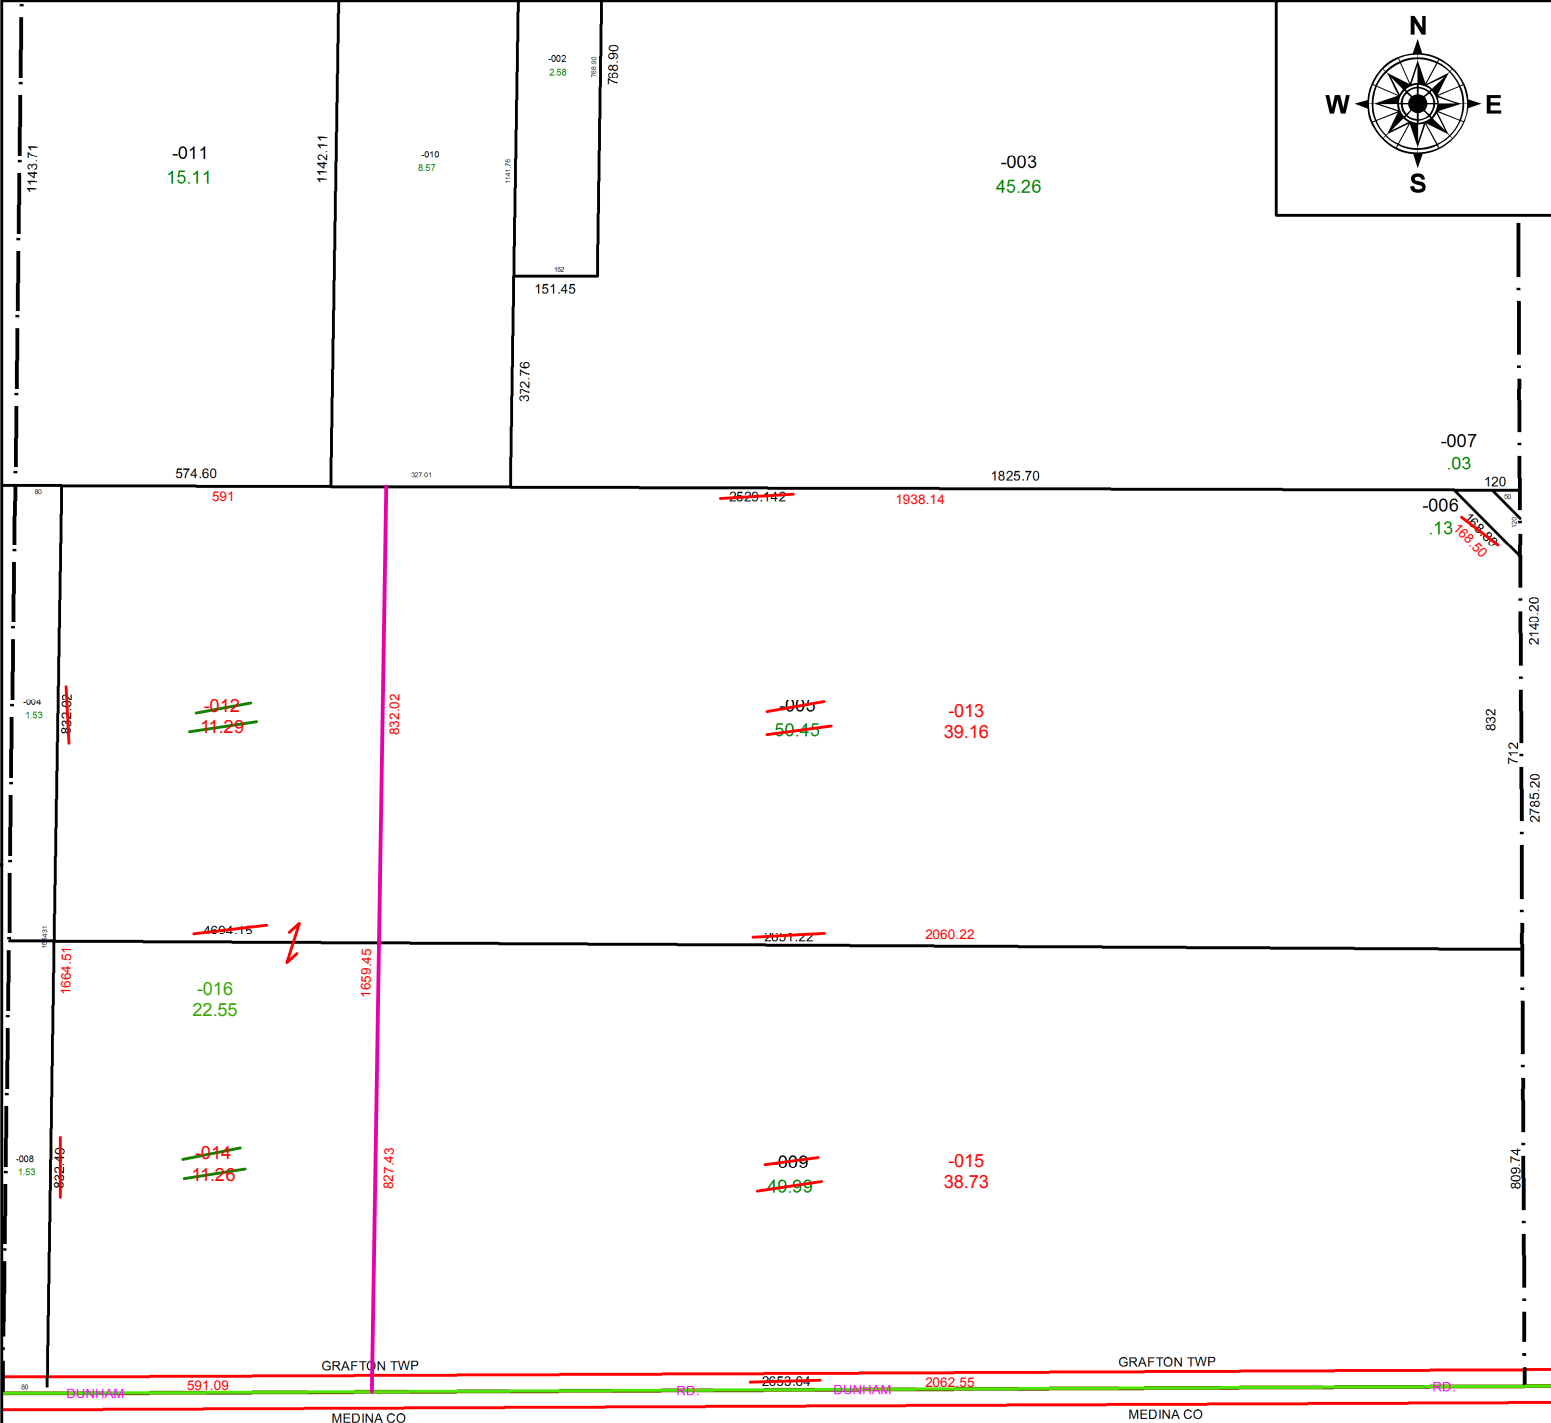

GRAFTON TWP  
 MEDINA CO

**SPLITS/DEEDS PROCESSED**  
 LORAIN COUNTY TAX MAP DEPARTMENT  
 226 MIDDLE AVE. ELYRIA, OH

SURVEYED BY: AMY M. KELLY  
 CLOSURE: 1: 1,423,743  
 MAP PAGE(S): 16-00-094  
 APPROVED BY: RRM DATE: 3-9-21  
 SCALE: 1" = 350 PRIOR INSTRUMENT: 20110364852