
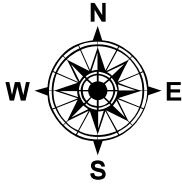


PARENT PARCEL: 01-00-056-000-094  
 CHILD PARCEL: 01-00-056-000-099 THRU -103  
 STARTING POINT: INTERSECTION OF C/L OF RICE RD. AND EAST LINE OF O.L.56

21-04266

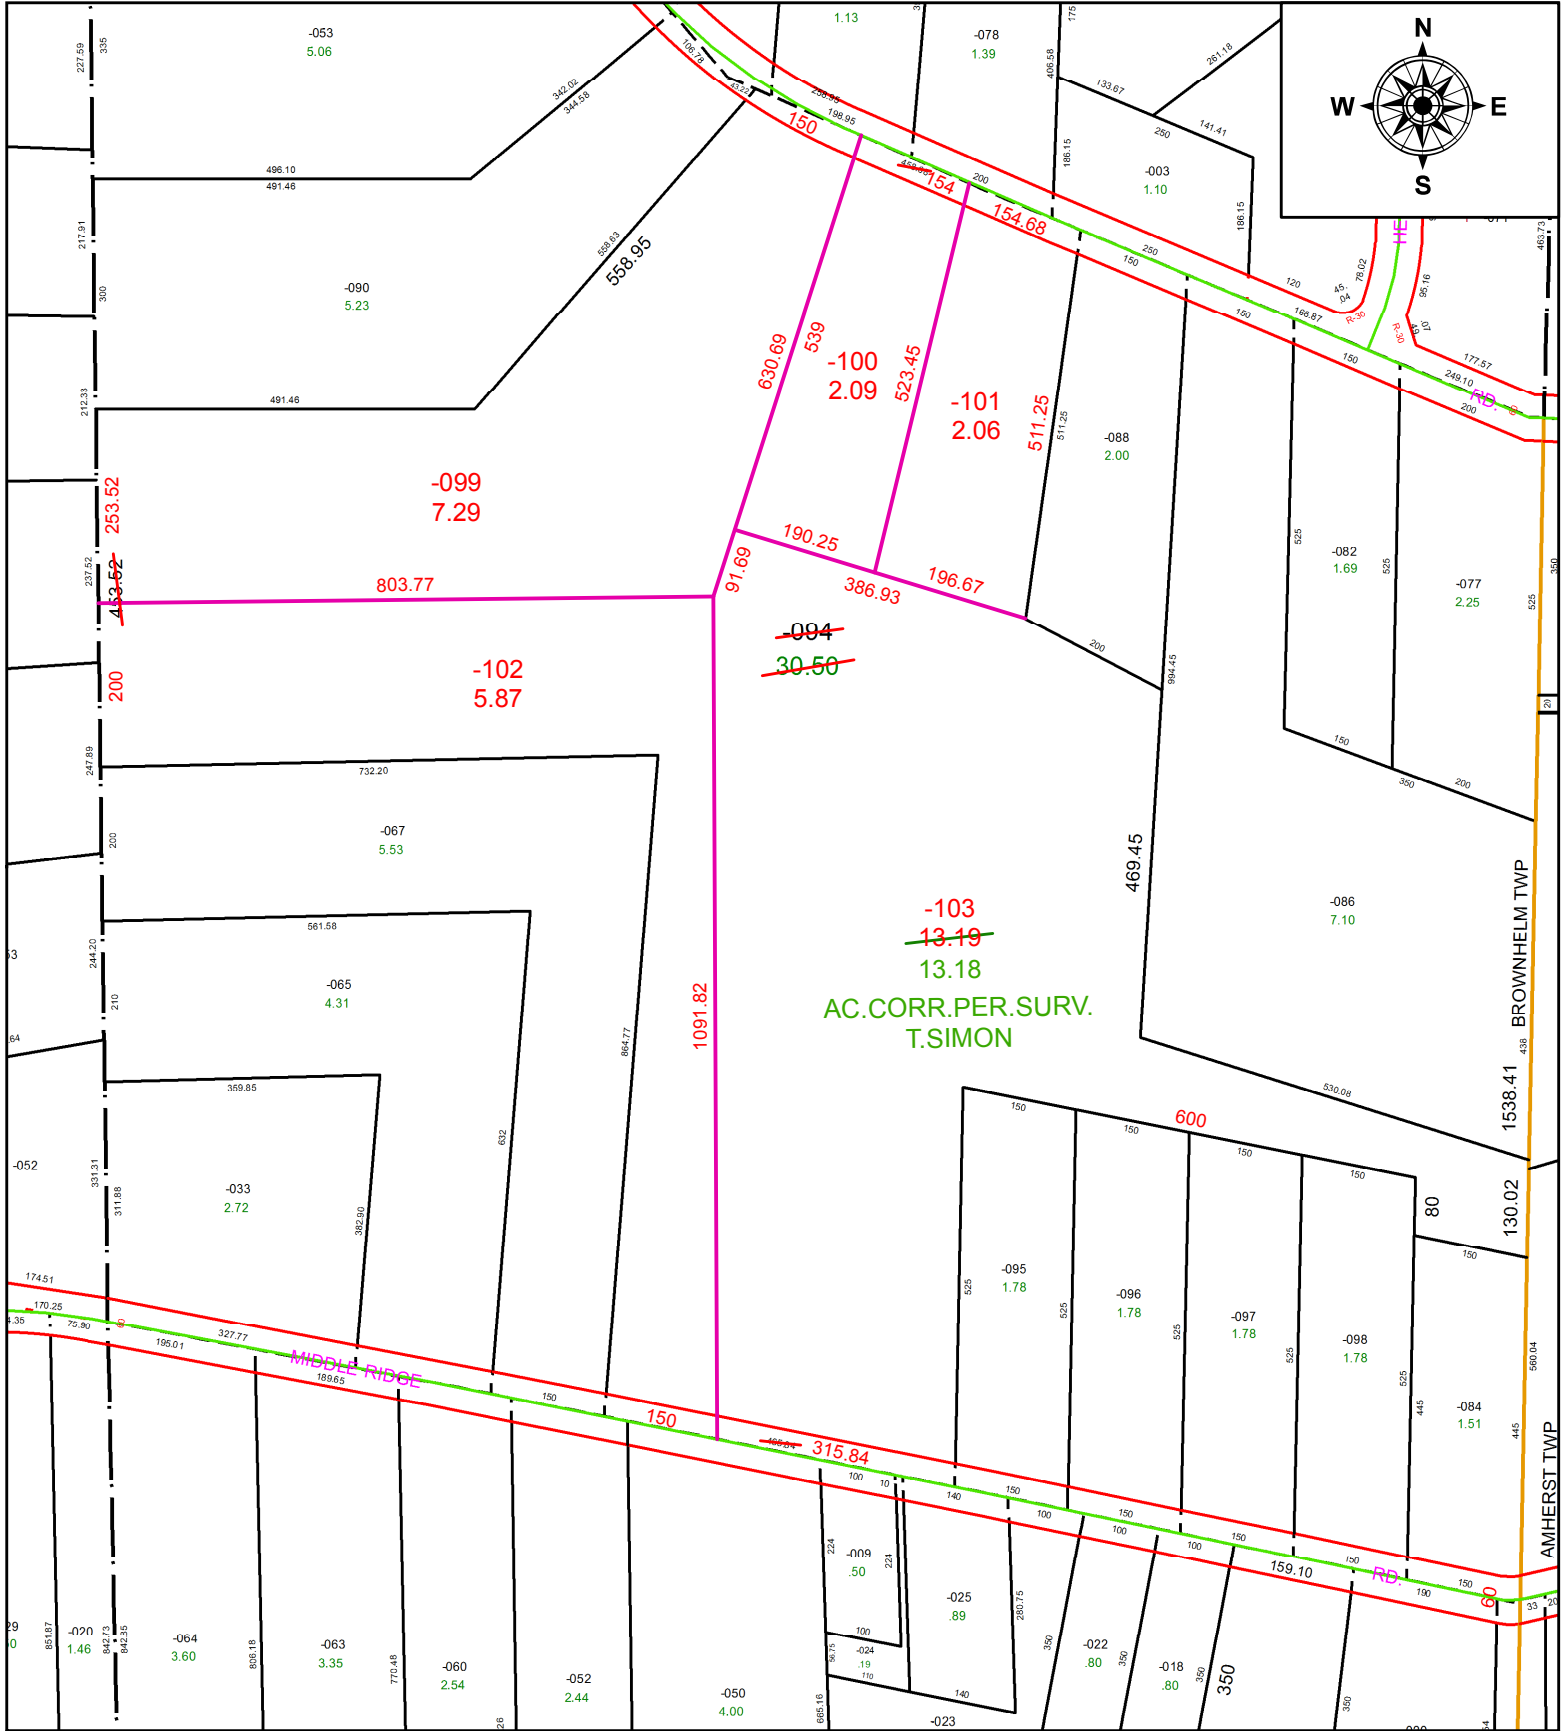

**SPLITS/DEEDS PROCESSED**  
 LORAIN COUNTY TAX MAP DEPARTMENT  
 226 MIDDLE AVE. ELYRIA, OH

SURVEYED BY: THOMAS A. SIMON  
 CLOSURE: 1: 449,673  
 MAP PAGE(S): 1-00-056  
 APPROVED BY: RRM DATE: 3-9-21  
 SCALE: 1" = 250 PRIOR INSTRUMENT: 20200790582