


PARENT PARCEL: 14-00-052-000-034

CHILD PARCEL:

STARTING POINT: INTERSECTION OF C/L OF QUARRY RD, AND C/L OF HUGHES RD.

20-04267-A

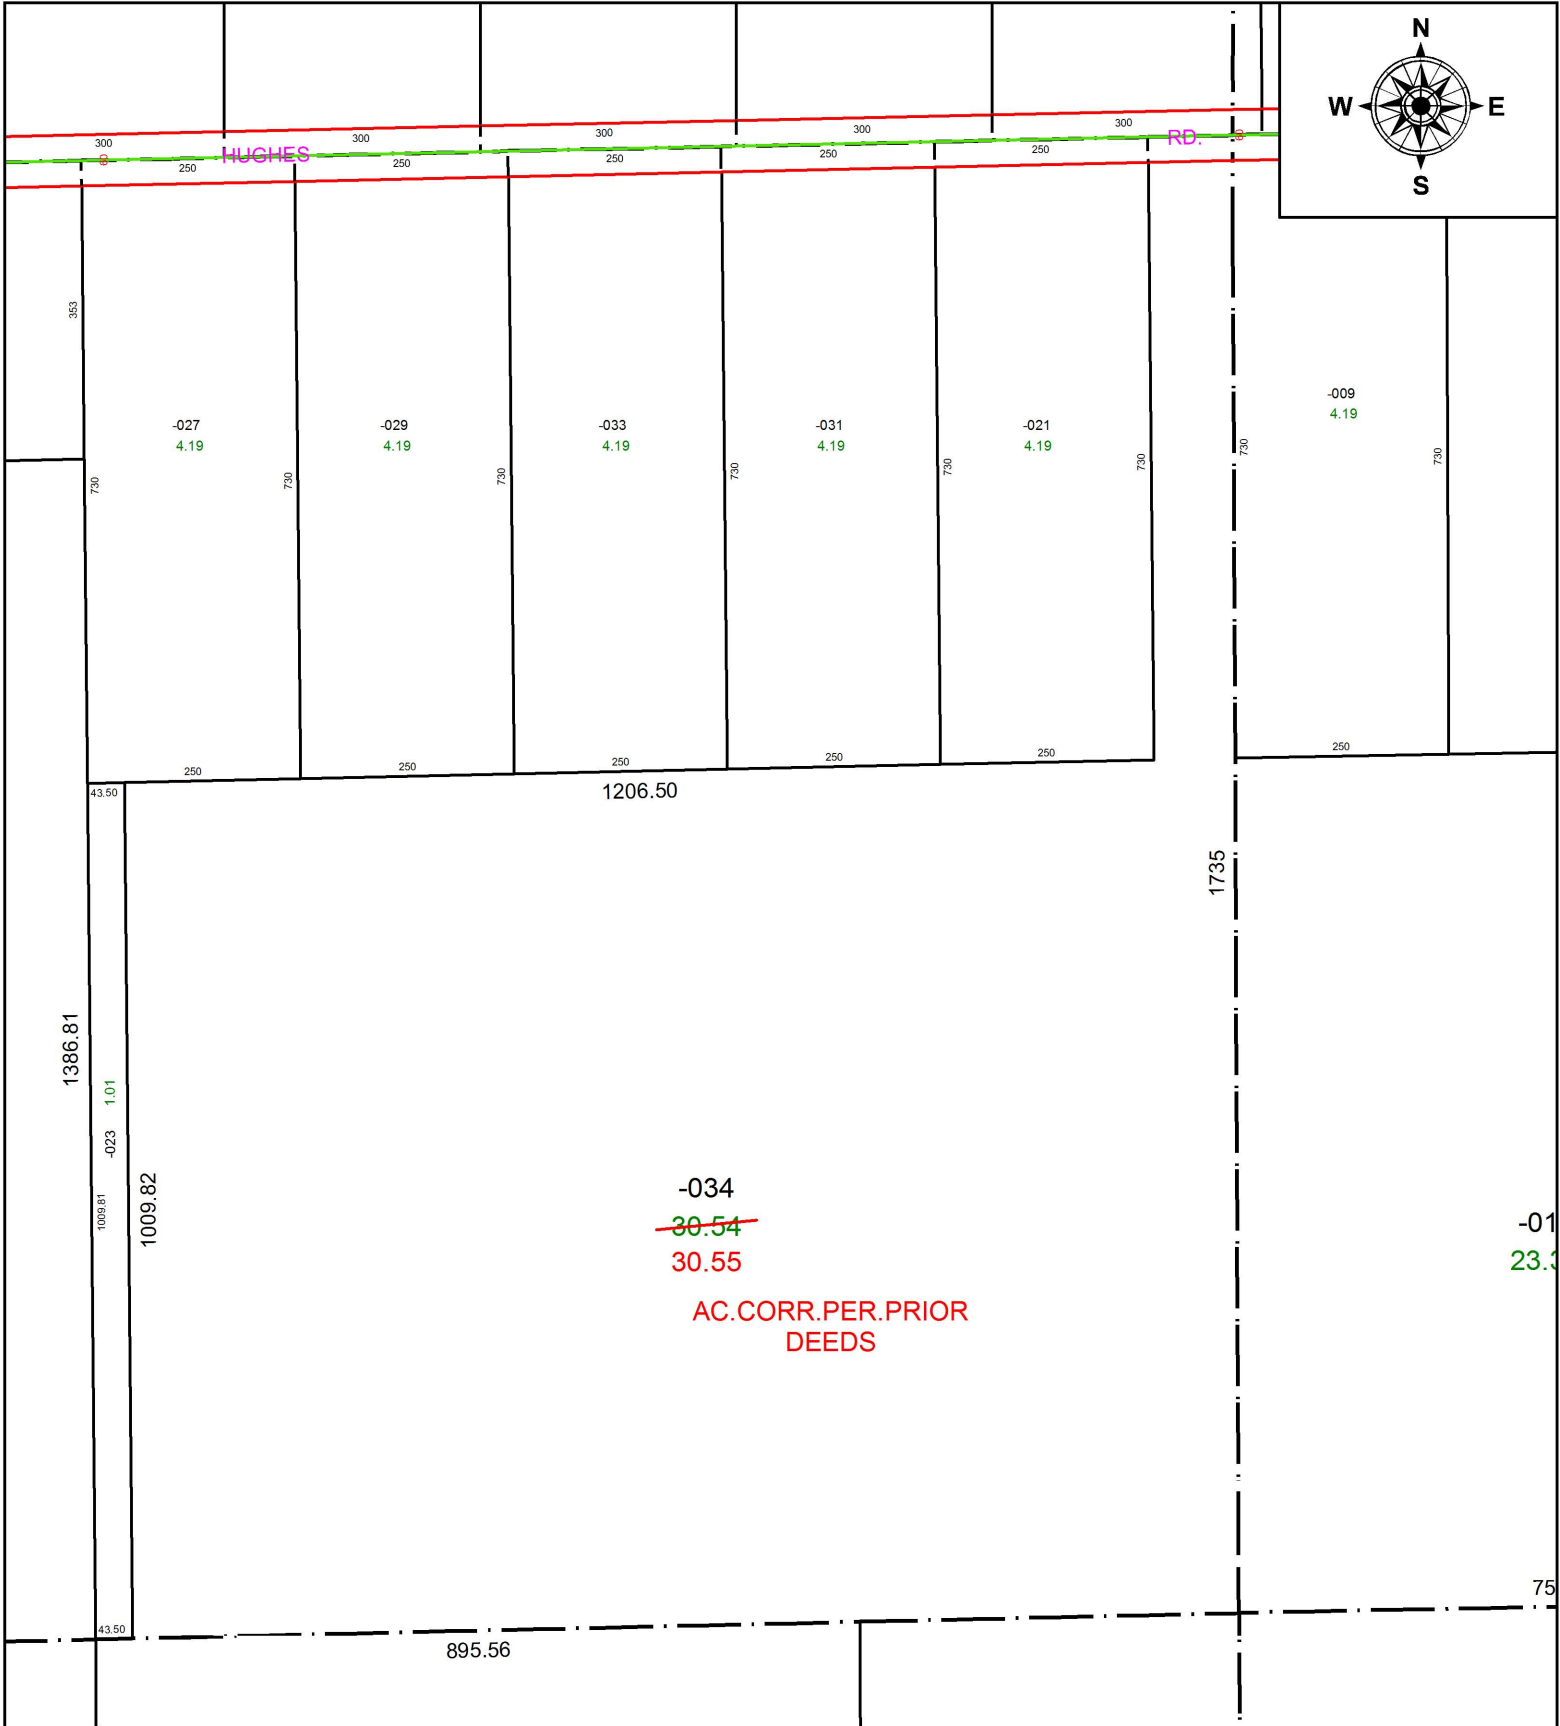

SPLITS/DEEDS PROCESSED
 LORAIN COUNTY TAX MAP DEPARTMENT
 226 MIDDLE AVE. ELYRIA, OH

SURVEYED BY: N/A
 CLOSURE: N/A
 MAP PAGE(S): 14-00-052
 APPROVED BY: RRM DATE: 2-3-20
 SCALE: 1" = 225 PRIOR INSTRUMENT: 20190706150