
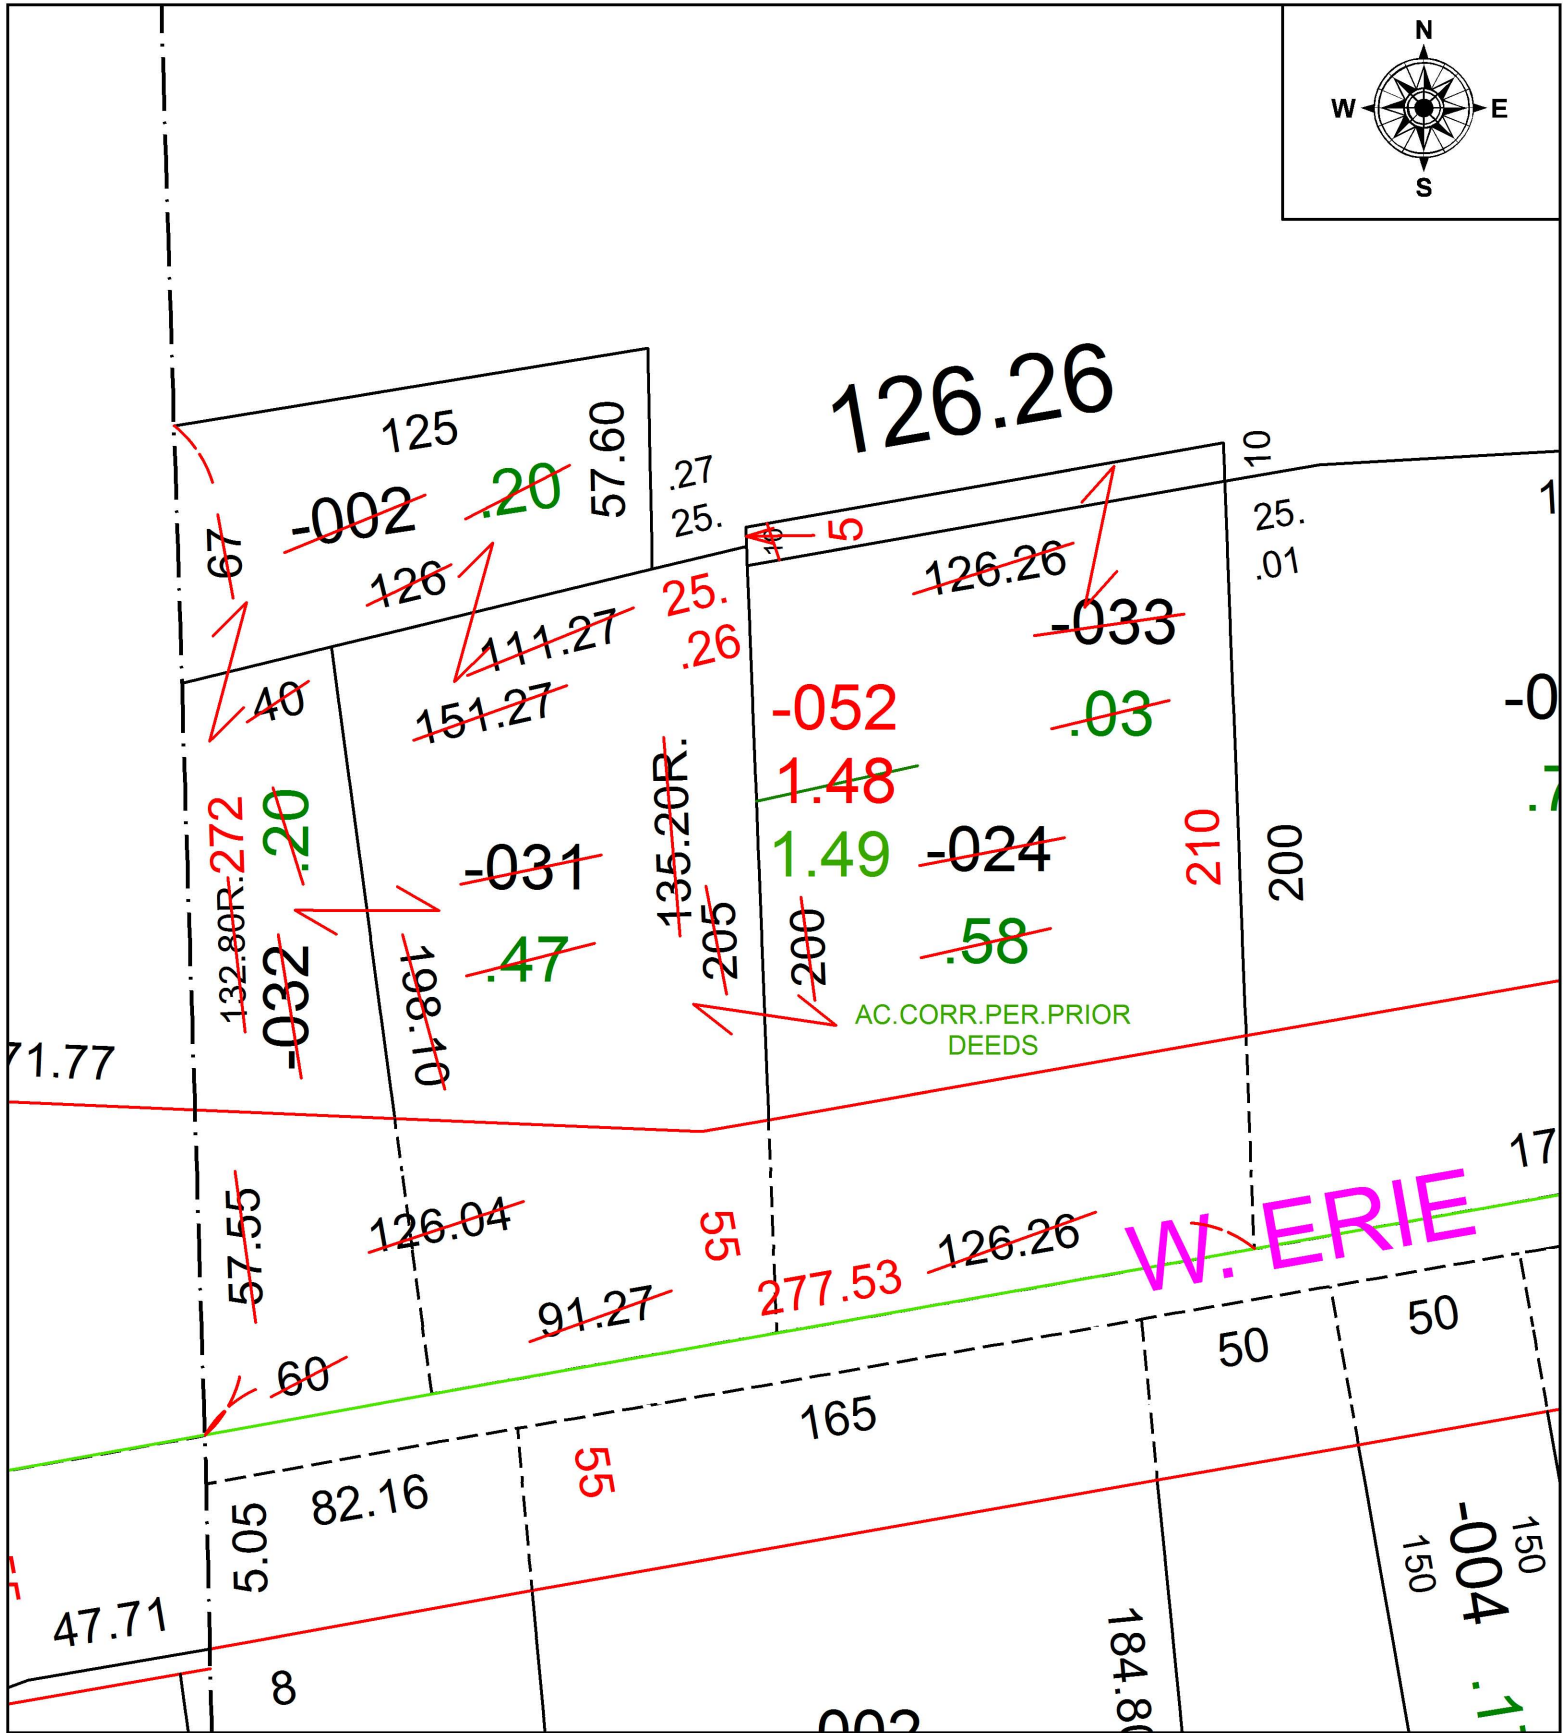


PARENT PARCEL: 01-00-006-101-002, -024, -031, -032, -033

CHILD PARCEL: 01-00-006-101-052

STARTING POINT: INTERSECTION OF C/L OF LIBERTY AVE AND WEST LINE OF O.L.6

20-04269-C

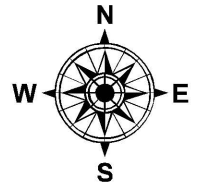

**SPLITS/DEEDS PROCESSED**  
LORAIN COUNTY TAX MAP DEPARTMENT  
226 MIDDLE AVE. ELYRIA, OH

SURVEYED BY: \_\_\_\_\_ N/A  
CLOSURE: 1:62,144  
MAP PAGE(S): 1-00-006  
APPROVED BY: RRM DATE: 2-3-20  
SCALE: 1" = 50' PRIOR INSTRUMENT: 20160580890