
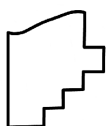
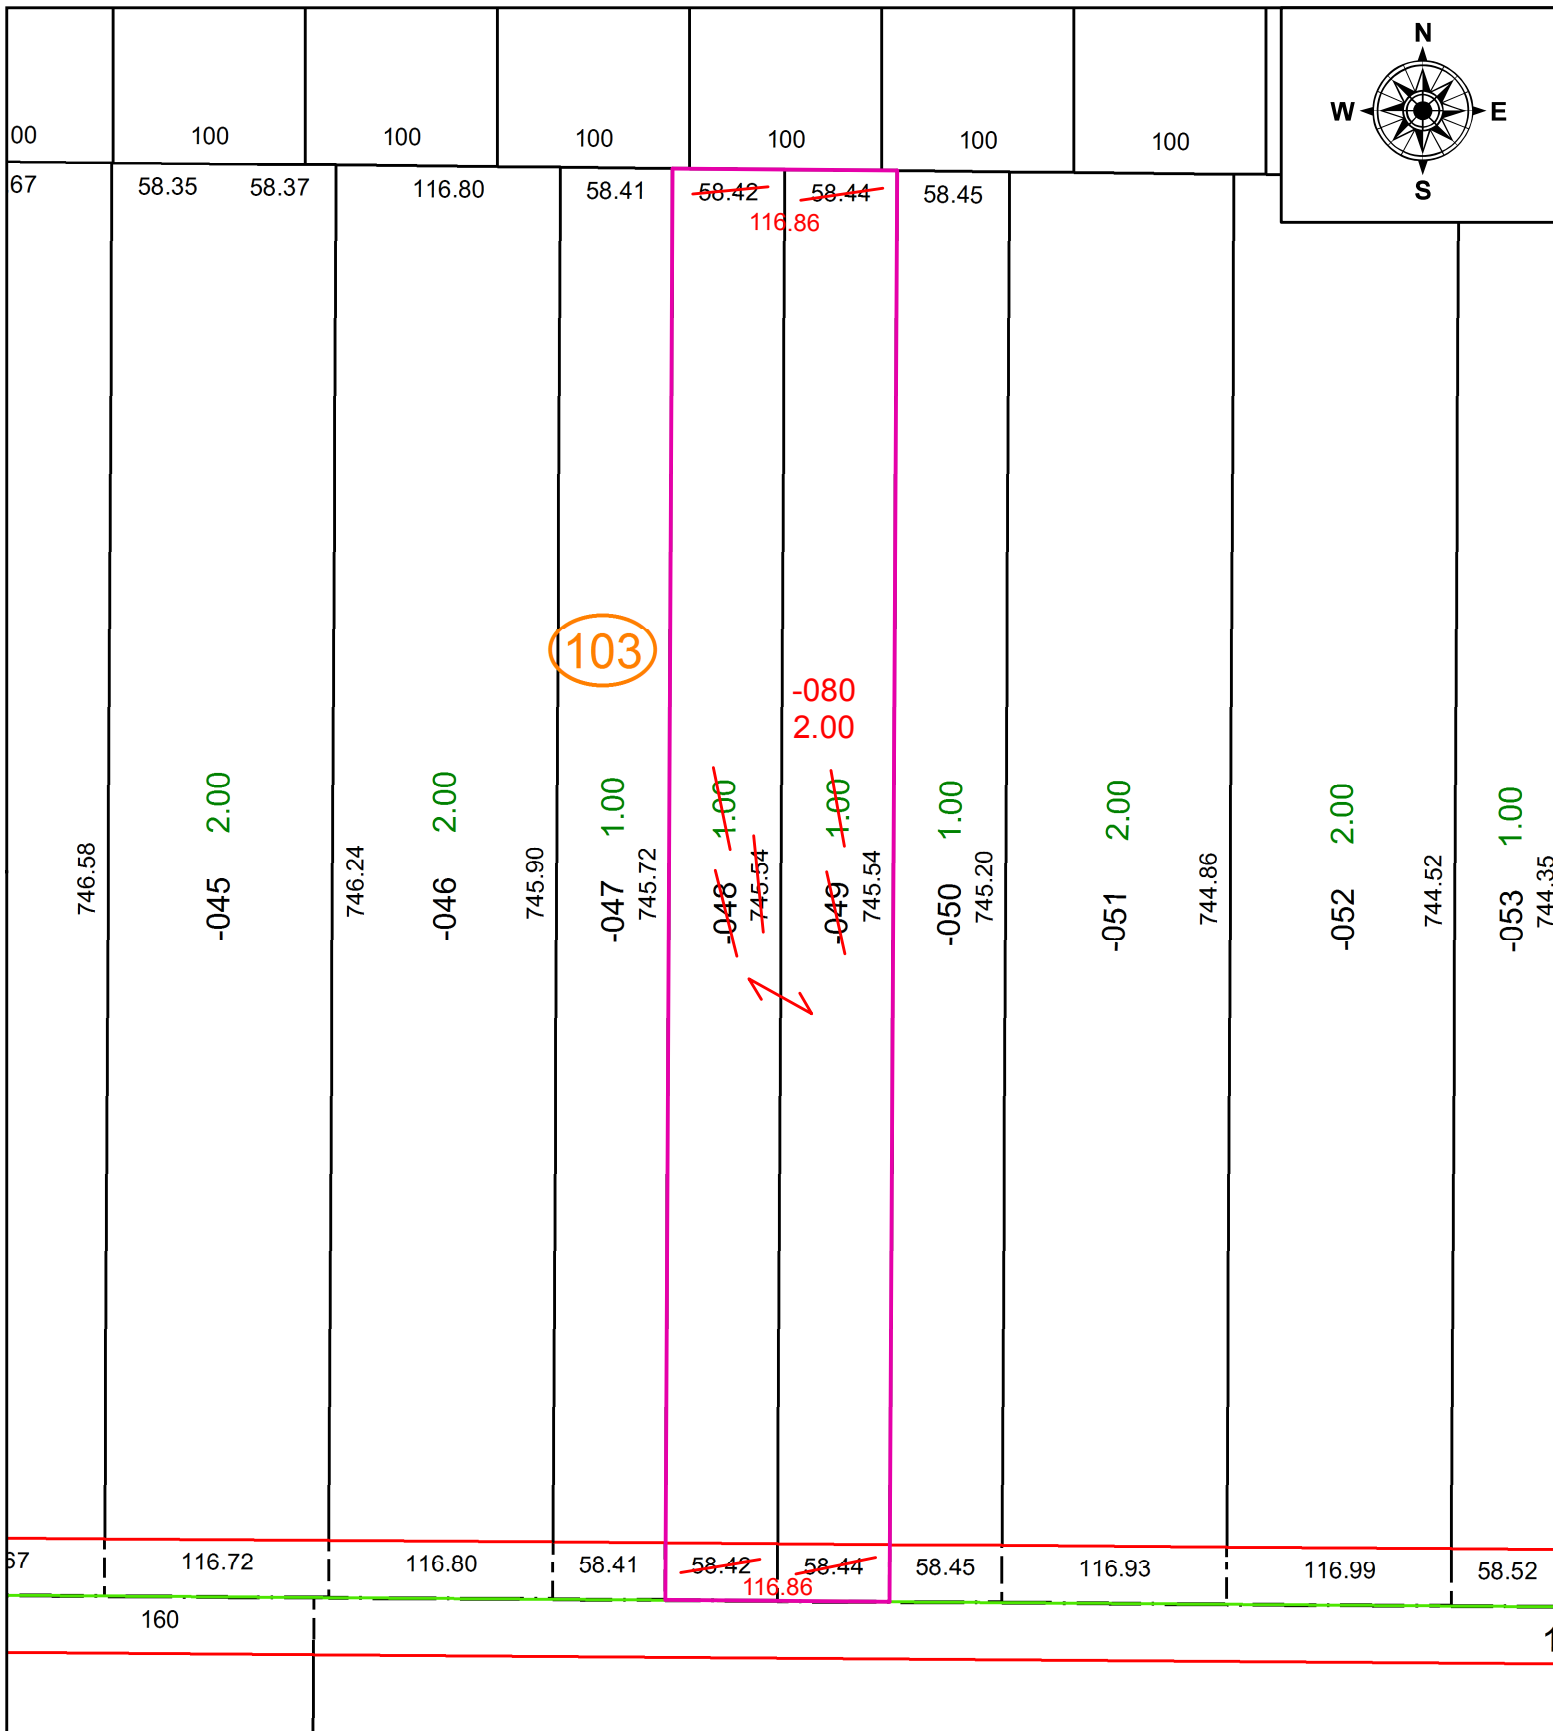


PARENT PARCEL: 03-00-066-103-048, -049

CHILD PARCEL: 03-00-066-103-080

21-04269

STARTING POINT: INTERSECTION OF C/L OF EAST RIVER RD. AND C/L OF FRENCH CREEK RD.

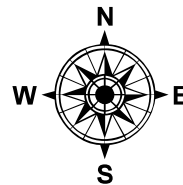

SPLITS/DEEDS PROCESSED
 LORAIN COUNTY TAX MAP DEPARTMENT
 226 MIDDLE AVE. ELYRIA, OH

SURVEYED BY: NATHAN W. SAUTTER
CLOSURE: 1:4,052,316
MAP PAGE(S): 3-00-066
APPROVED BY: RRM **DATE:** 3-11-21
SCALE: 1" = 100 **PRIOR INSTRUMENT:** 20210800026