
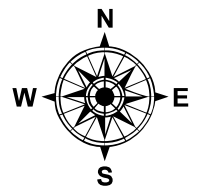


PARENT PARCEL: 03-00-040-114-021, -022, -027, 03-00-041-114-030

CHILD PARCEL: 03-00-040-114-028

21-04278

STARTING POINT: NORTHWEST CORNER OF S/L 230 IN COMMUNITY BEACH SUB.

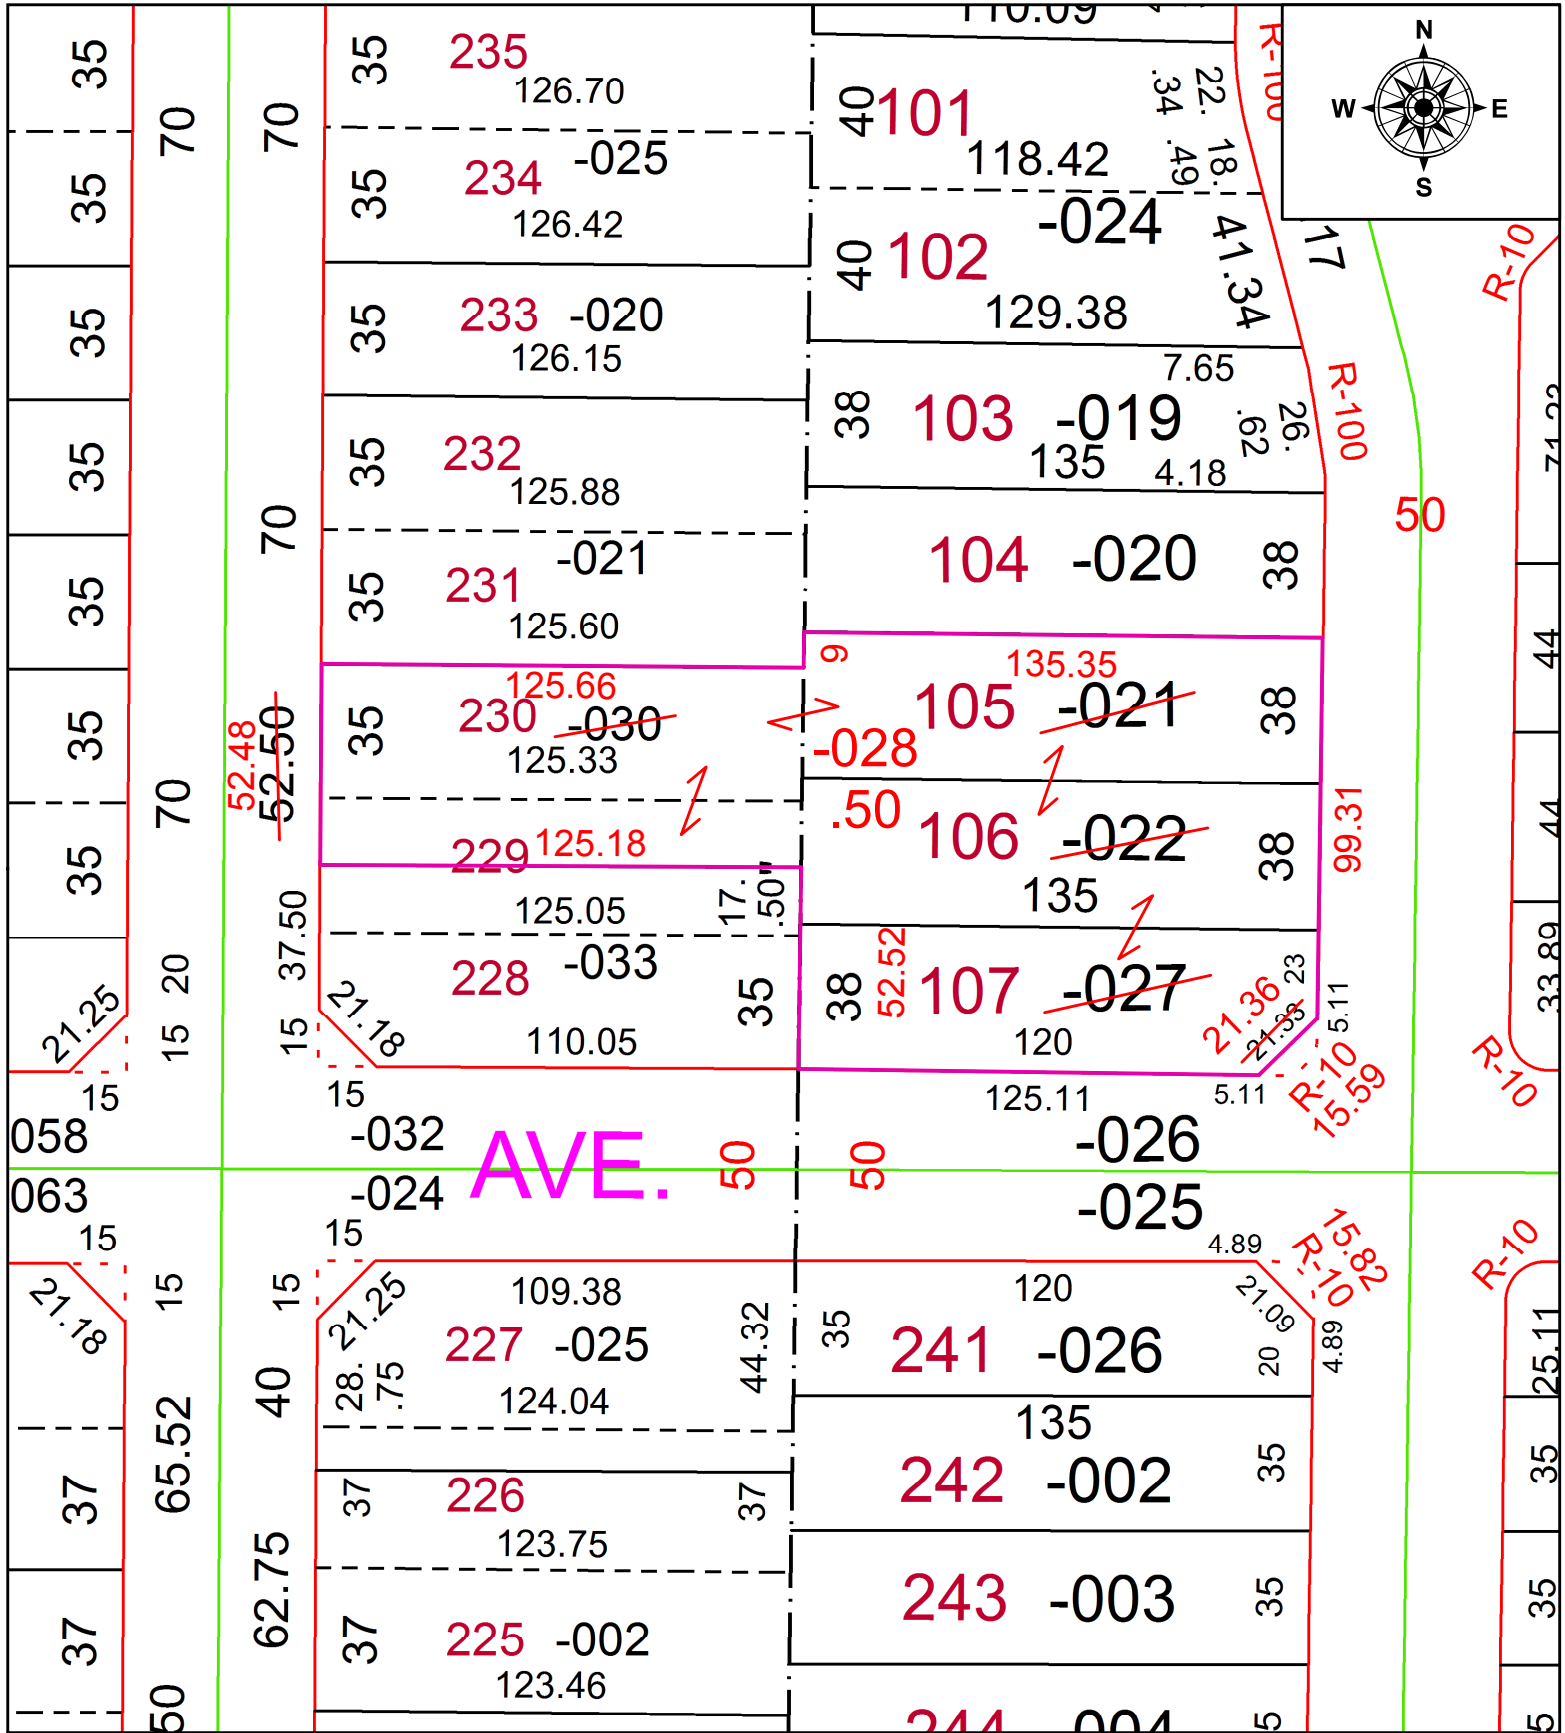

SPLITS/DEEDS PROCESSED
 LORAIN COUNTY TAX MAP DEPARTMENT
 226 MIDDLE AVE. ELYRIA, OH

SURVEYED BY: PATRICK A. MCGANNON
 CLOSURE: 1: 534,487
 MAP PAGE(S): 3-00-040
 APPROVED BY: RRM DATE: 3-29-21
 SCALE: 1" = 50 PRIOR INSTRUMENT: 19990660422