


PARENT PARCEL: 05-00-079-000-060

CHILD PARCEL:

STARTING POINT: INTERSECTION OF C/L OF MIDDLE RIDGE RD. AND SOUTH LINE OF O.L. 79

20-04279-A

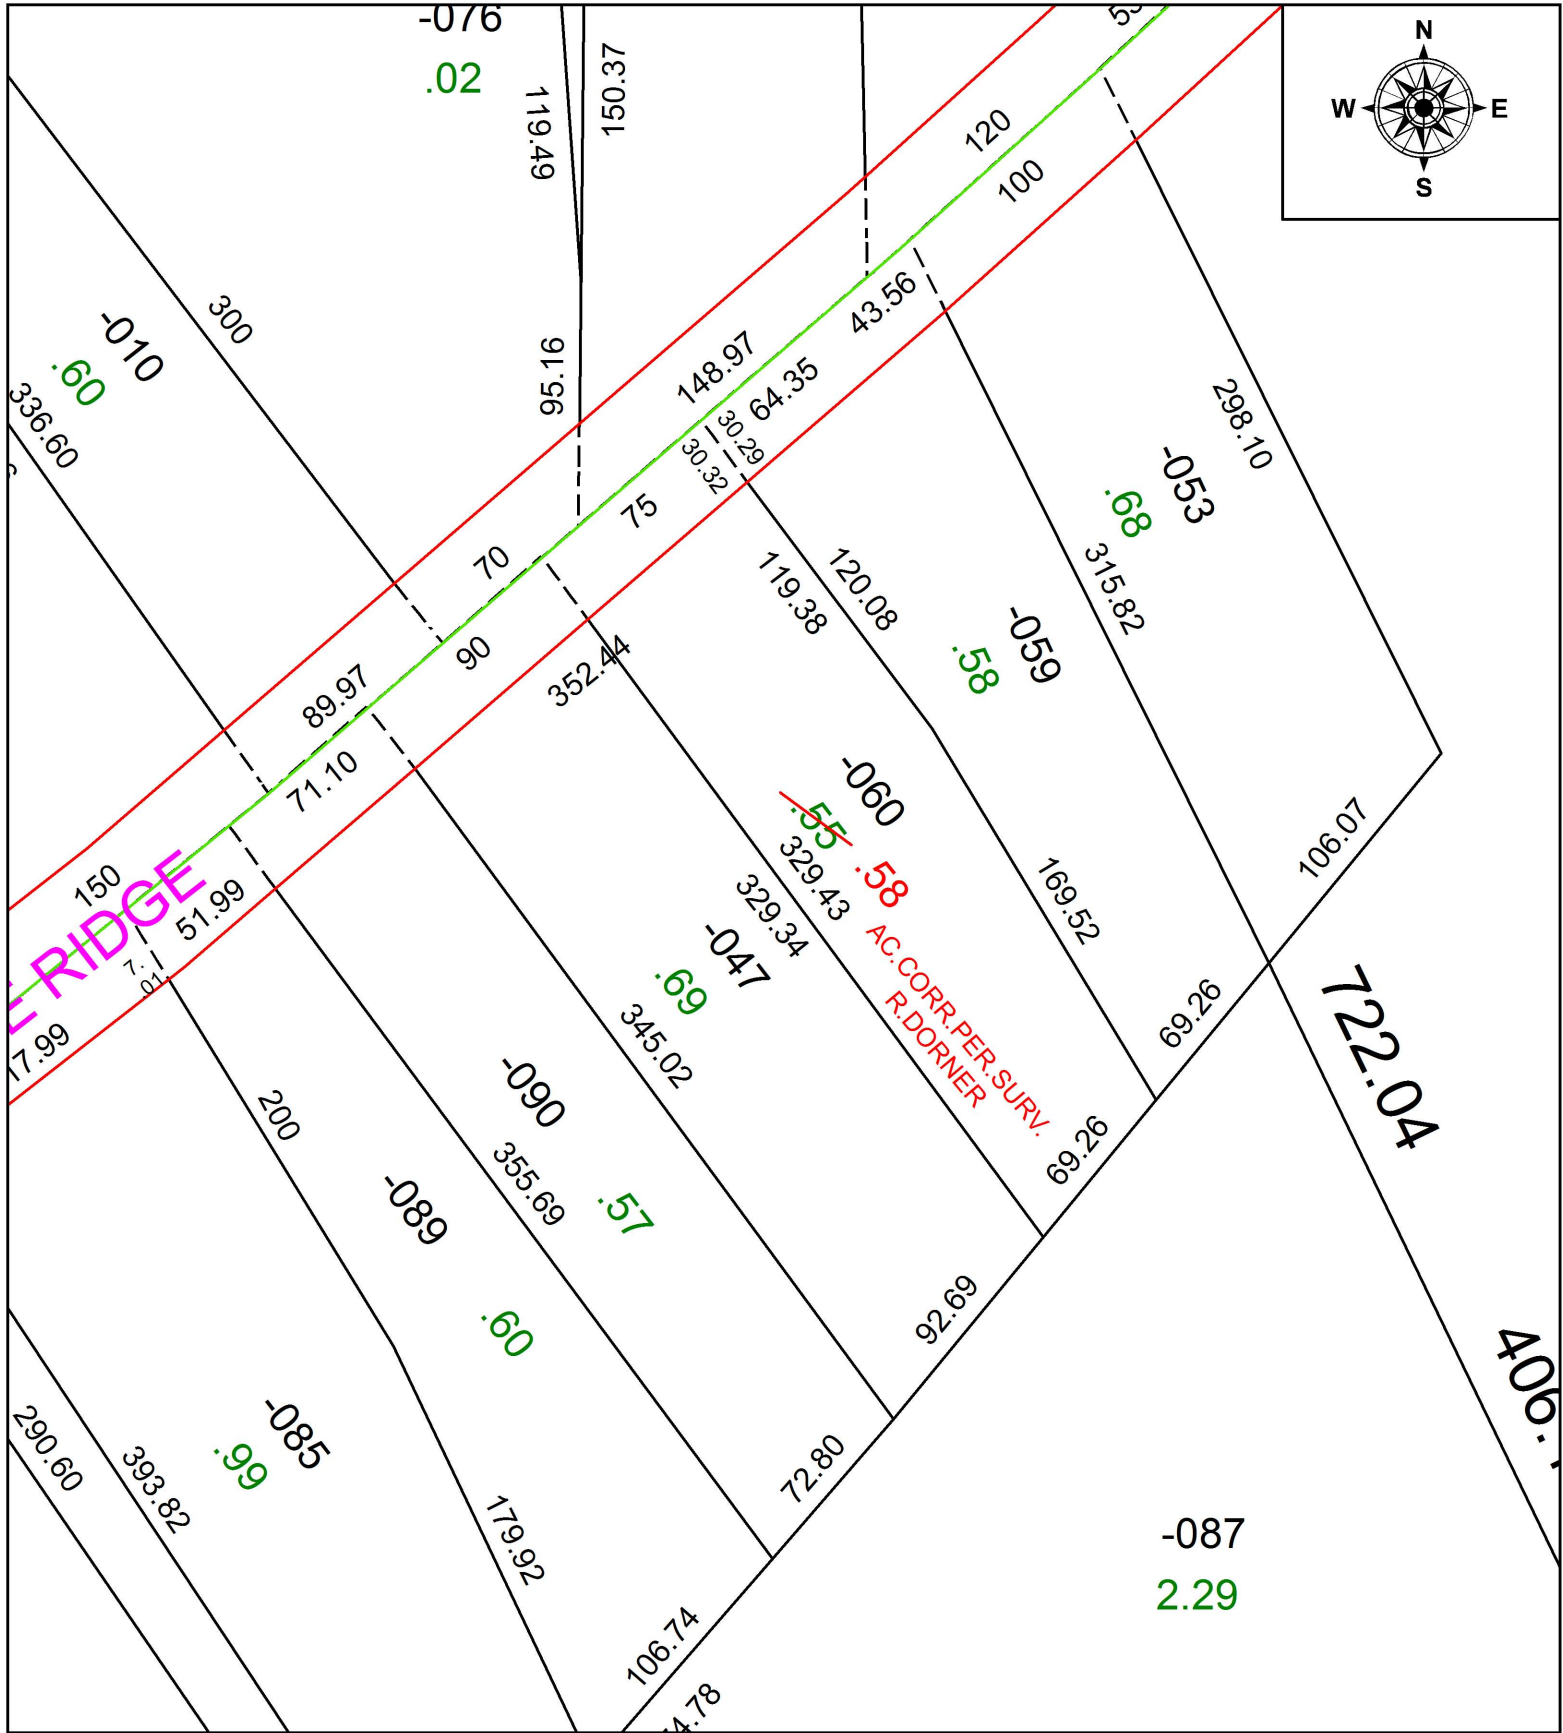

**SPLITS/DEEDS PROCESSED**  
 LORAIN COUNTY TAX MAP DEPARTMENT  
 226 MIDDLE AVE. ELYRIA, OH

**SURVEYED BY:** ROBERT A. DORNER  
**CLOSURE:** 1:125,662  
**MAP PAGE(S):** 1-00-006  
**APPROVED BY:** RRM **DATE:** 2-4-20  
**SCALE:** 1" = 75' **PRIOR INSTRUMENT:** 20180659641