


PARENT PARCEL: 11-00-089-000-124, -125, 11-00-090-000-029

CHILD PARCEL: 11-00-089-000-137 THRU -139, 11-00-090-000-263 THRU -265

STARTING POINT: INTERSECTION OF C/L OF CHESTNUT RIDGE RD. AND WEST LINE OF O.L.90

21-04282

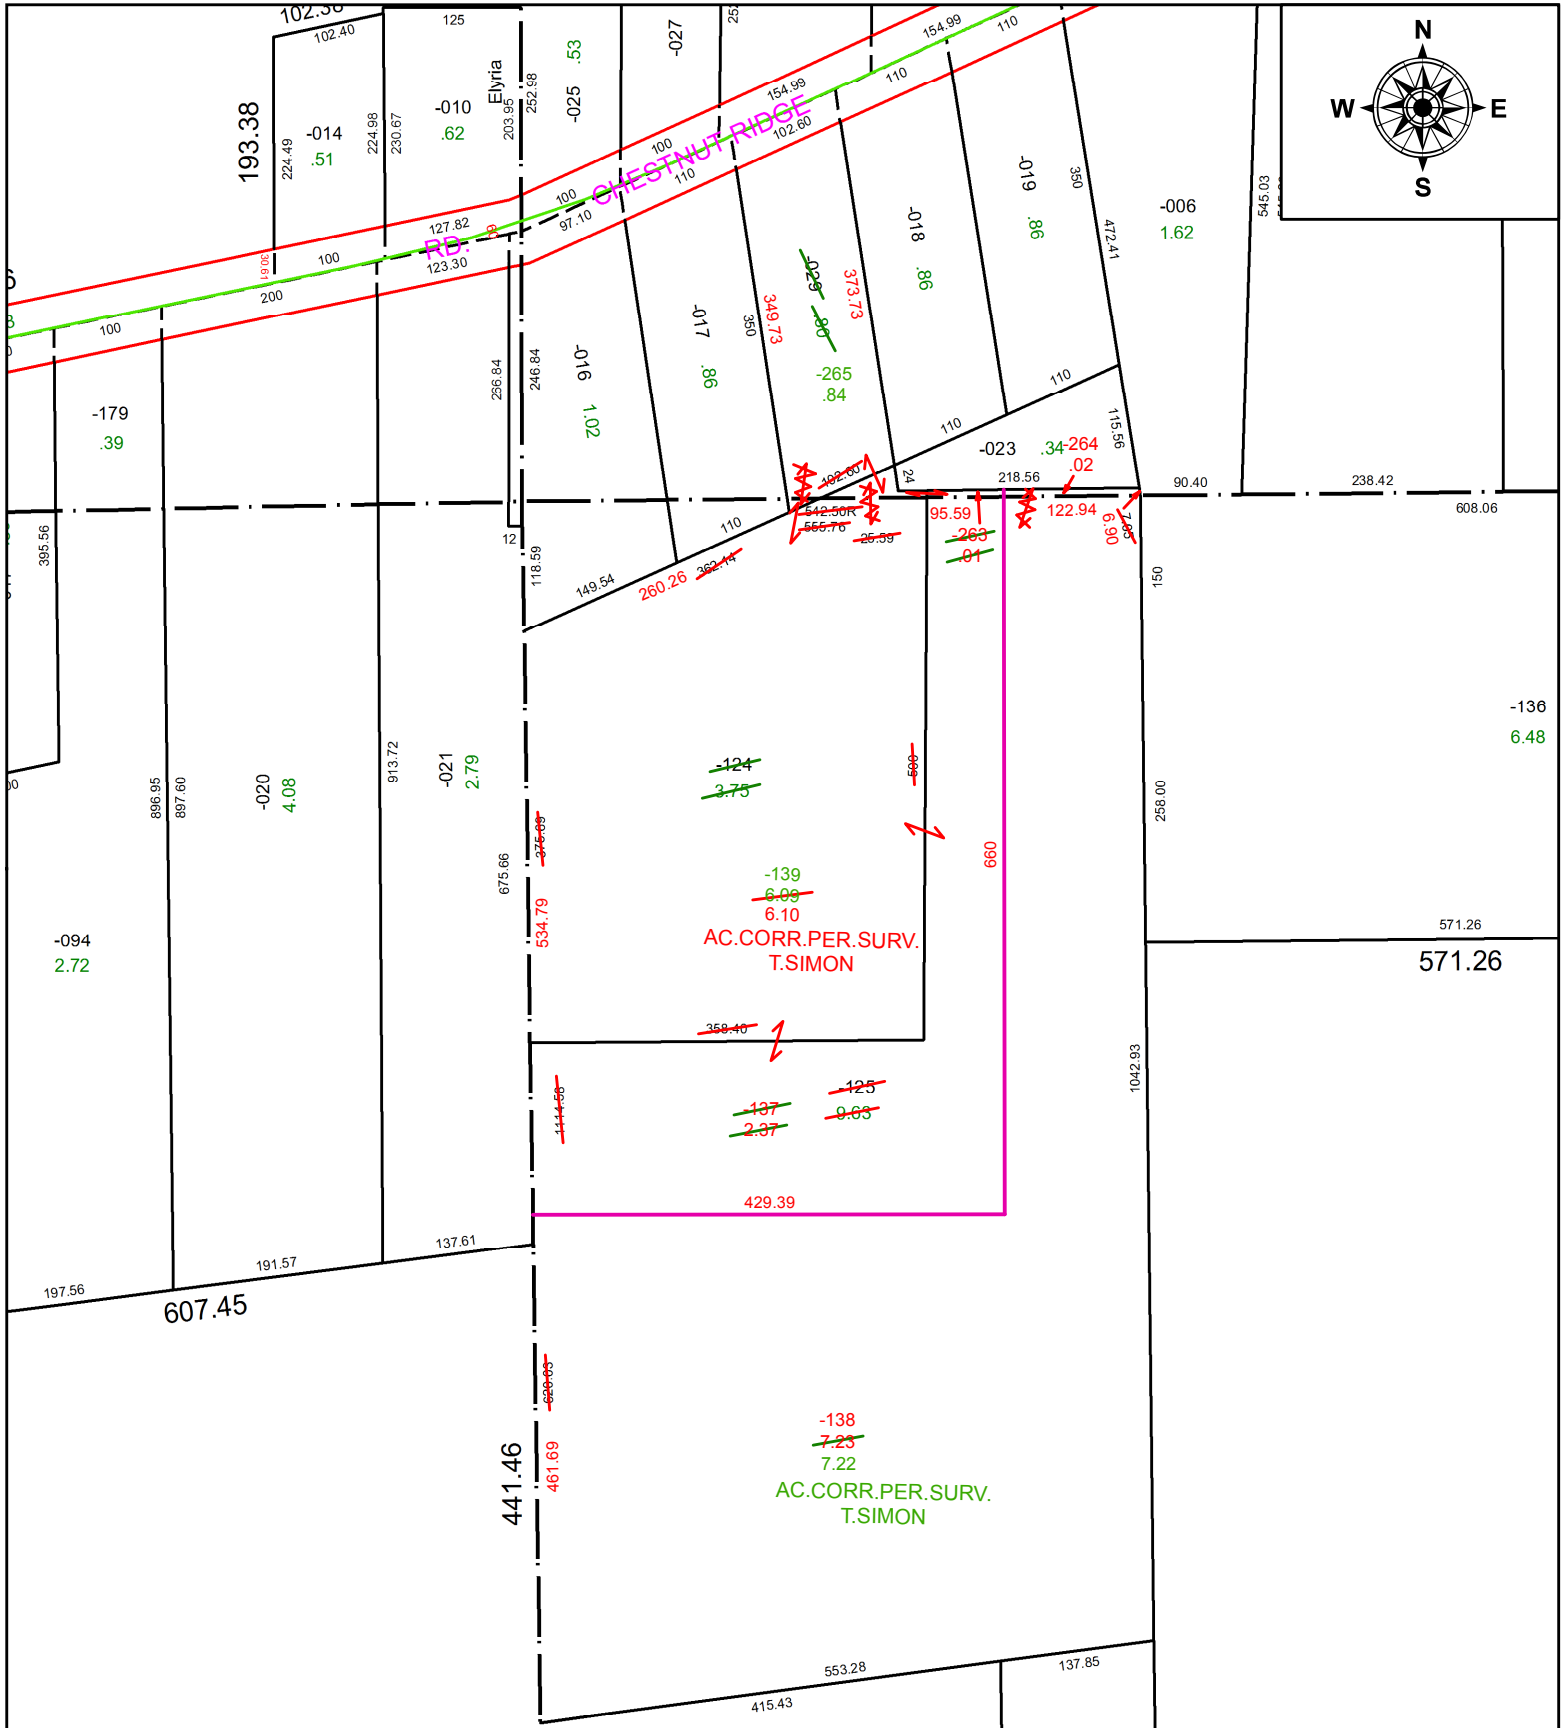

SPLITS/DEEDS PROCESSED
 LORAIN COUNTY TAX MAP DEPARTMENT
 226 MIDDLE AVE. ELYRIA, OH

SURVEYED BY: THOMAS A. SIMON
CLOSURE: 1: 1,125,371
MAP PAGE(S): 11-00-089
APPROVED BY: RRM **DATE:** 4-6-21
SCALE: 1" = 175 **PRIOR INSTRUMENT:** 20180662480