
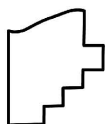


PARENT PARCEL: 02-01-003-270-036

CHILD PARCEL:

20-04283-A

STARTING POINT: INTERSECTION OF C/L OF CHERRYWOOD DR. AND C/L OF COOPER FOSTER PARK RD.

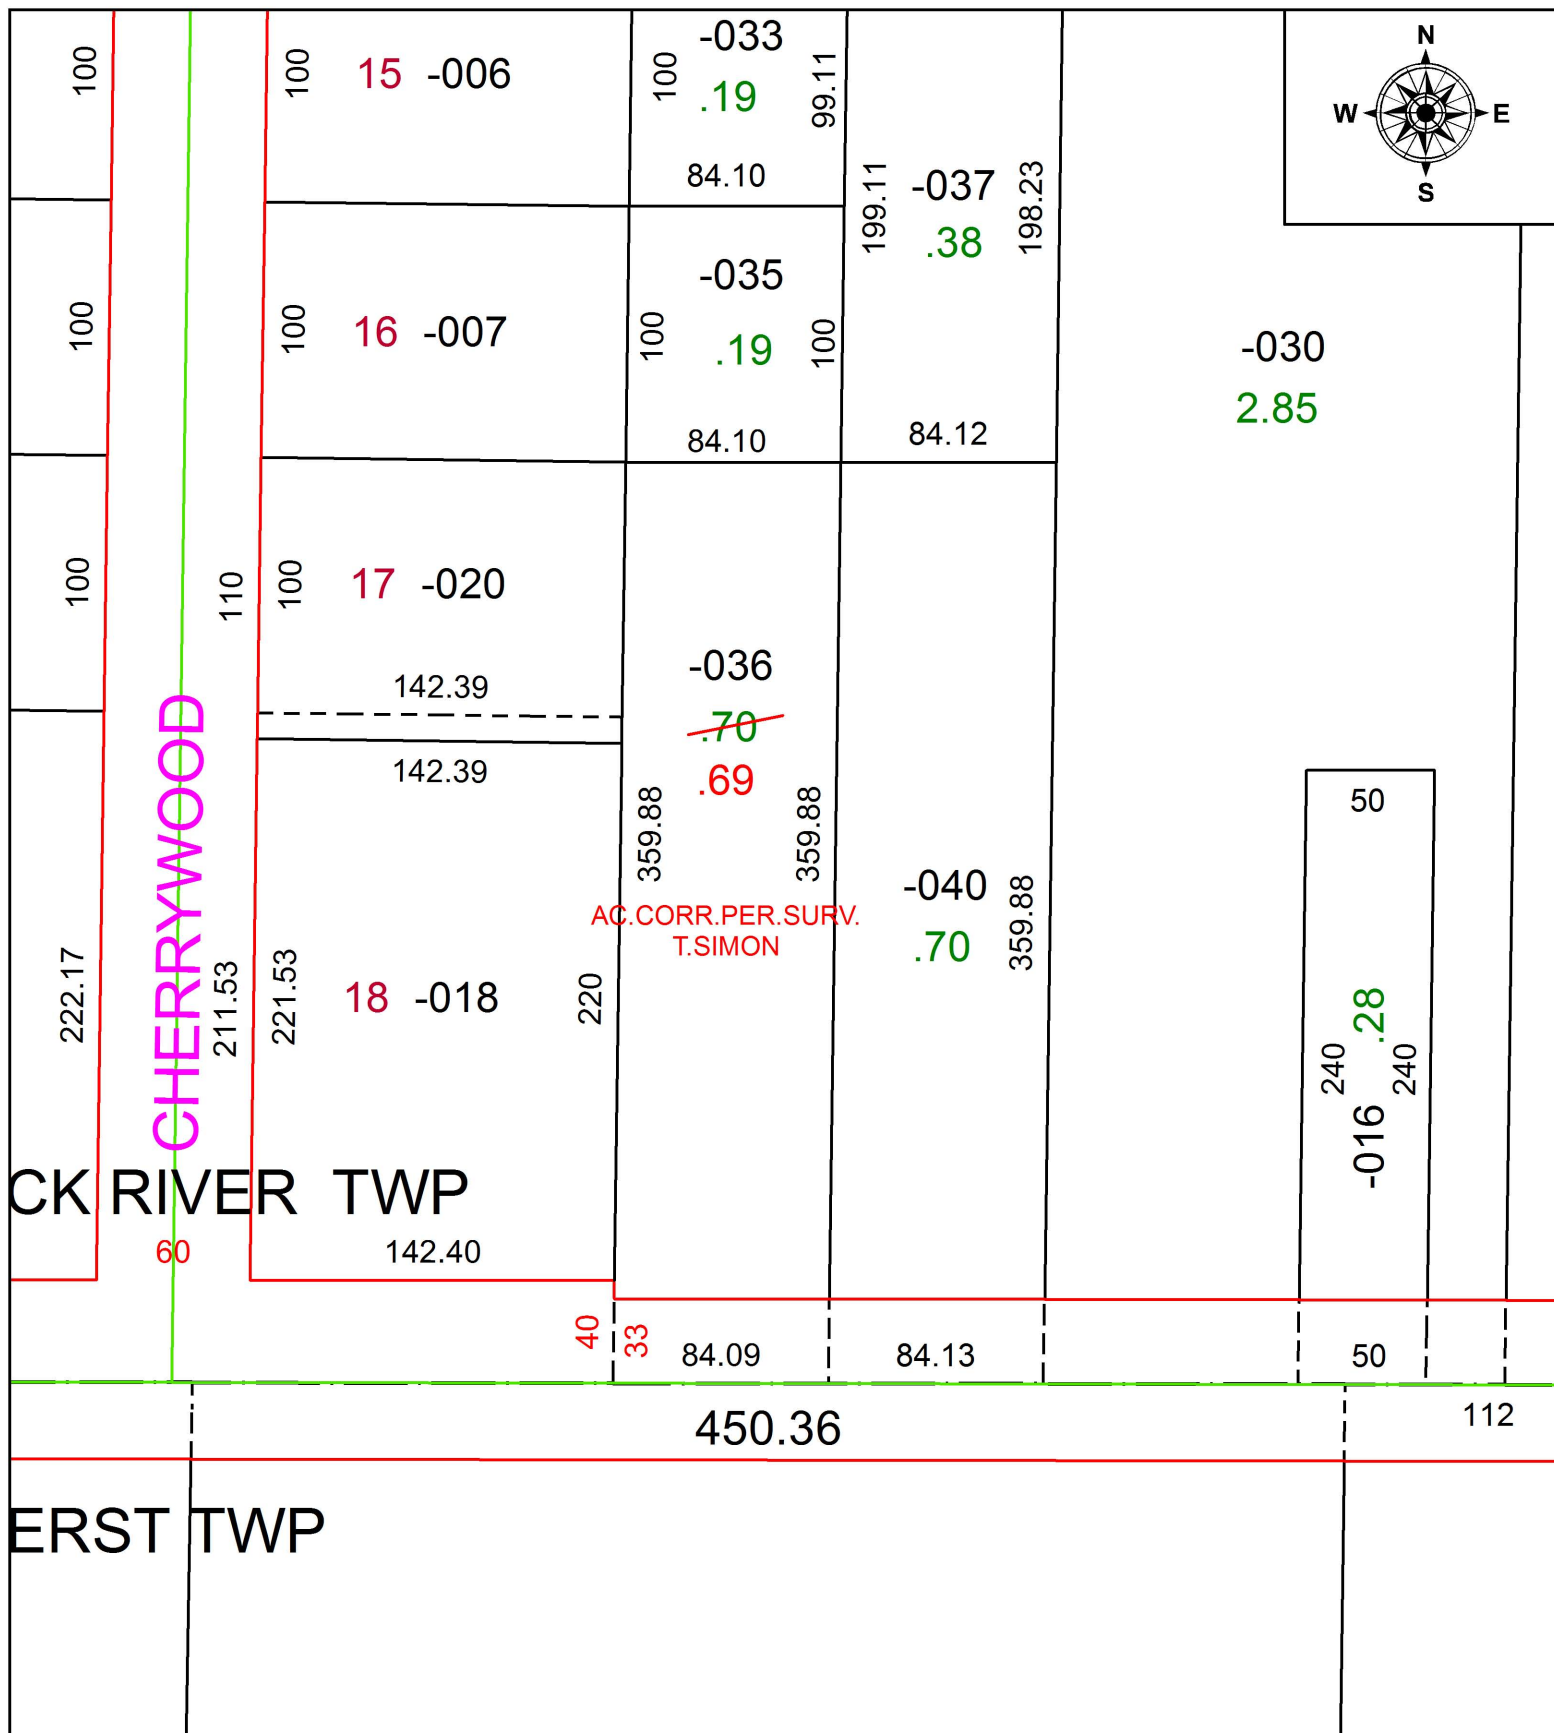

SPLITS/DEEDS PROCESSED
 LORAIN COUNTY TAX MAP DEPARTMENT
 226 MIDDLE AVE. ELYRIA, OH

SURVEYED BY: THOMAS A. SIMON
 CLOSURE: 1:293,795
 MAP PAGE(S): 2-01-003
 APPROVED BY: RRM DATE: 2-5-20
 SCALE: 1" = 75' PRIOR INSTRUMENT: 20180671298